

WOODLAND JOINT UNIFIED SCHOOL DISTRICT WOODLAND ADULT EDUCATION CENTER MODERNIZATION CLASSROOM CONVERSIONS

©2023 Synthesis Partners, LLC. All Rights Reserved.
These record drawings have been prepared based upon information submitted, in part, by others. While this information is believed to be reliable, the Architect is not responsible for their accuracy, nor for errors or omissions which may have been incorporated into these documents as a result.

PO Box 1900
Yuba City, CA 95992-1900
530.298.7298
www.spinc-arch.com



APPROVALS


OWNER

Woodland Joint Unified School District
435 6th Street
Woodland, CA 95695

PROJECT

CLASSROOM CONVERSIONS
at
WOODLAND EDUCATION CENTER
575 Hays Street
Woodland, CA 95695

KEY PLAN

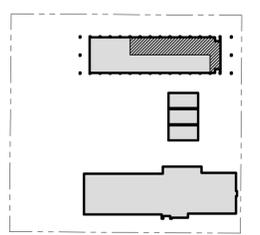

THIS IS A PRELIMINARY SET FOR REVIEW ONLY NOT FOR CONSTRUCTION

NO.	REVISION DESCRIPTION	DATE

COVER SHEET

CS

DATE: 2023-03-01
PROJECT NO.: 21-W04-01

PROJECT TEAM	SCOPE OF WORK	APPLICABLE CODES	DRAWING INDEX
<p>ARCHITECT Synthesis Partners, LLC A.O.R.: Gary M. Underhill, AIA MANAGER: Jaycen A. Russell, Assoc. AIA ADDRESS: PO Box 1900 Yuba City, CA 95992 - 1900 PHONE: (530) 298-7298</p> <p>OWNER Woodland Joint Unified School District CONTACT: Karin Liu ADDRESS: 575 Hays Street Woodland, CA 95695</p> <p>MECHANICAL Weston & Associates Mechanical Engineers, Inc. CONTACT: David A. Weston, PE, LEED AP ADDRESS: 555 University Avenue, Suite 210 Sacramento, CA 95825</p> <p>ELECTRICAL M. Neils Engineering, Inc. CONTACT: Stuart K. Lindsay, CSI, CDT, LEED AP ADDRESS: 100 Howe Avenue, Suite 235N Sacramento, CA 95825</p>	<p>THE SCOPE OF THIS PROJECT INCLUDES, BUT IS NOT LIMITED TO THE FOLLOWING:</p> <p>GENERAL COORDINATION WITH OTHER CONTRACTORS IS REQUIRED ON THIS PROJECT, INCLUDING COORDINATION BETWEEN THE GENERAL CONTRACTOR AND THE DISTRICT'S VENDORS FOR LOW VOLTAGE SYSTEMS (PHONE, INTERNET, SECURITY, INTRUSION, ETC.), FURNISHINGS, EQUIPMENT, THE OWNER'S REPRESENTATIVES, AND DISTRICT PERSONNEL.</p> <p>PROJECT CONSISTS OF REMODEL OF EXISTING CLASSROOMS INCLUDING PLUMBING & ELECTRICAL TO SUPPORT EQUIPMENT REQUIRED FOR MANUFACTURING, DENTAL AND CULINARY CLASSROOMS.</p> <p>DEMOLITION</p> <ul style="list-style-type: none"> REMOVAL OF EXISTING CABINETS, DOORS, DOOR FRAMES, DOOR HARDWARE, FINISHES & INTERIOR WALLS. <p>INTERIOR WORK</p> <ul style="list-style-type: none"> REMODEL OF 4 CLASSROOMS. <p>THIS PROJECT REQUIRES A CLASS 3 PROJECT INSPECTOR.</p>	<p>THE CONTRACTOR SHALL KEEP A COPY OF THE FOLLOWING REGULATIONS ON THE JOB SITE AT ALL TIMES:</p> <ol style="list-style-type: none"> CALIFORNIA CODE OF REGULATIONS, TITLE 24 <ul style="list-style-type: none"> PART 1 - 2022 CALIFORNIA ADMINISTRATIVE CODE PART 2 - 2019 CALIFORNIA BUILDING CODE PART 3 - 2019 CALIFORNIA ELECTRICAL CODE PART 4 - 2019 CALIFORNIA MECHANICAL CODE PART 5 - 2019 CALIFORNIA PLUMBING CODE PART 6 - 2019 CALIFORNIA ENERGY CODE PART 7 - 2019 CALIFORNIA ELEVATOR SAFETY CONSTRUCTION CODE PART 8 - 2019 CALIFORNIA HISTORICAL BUILDING CODE PART 9 - 2019 CALIFORNIA FIRE CODE PART 10 - 2019 CALIFORNIA EXISTING BUILDING CODE PART 11 - 2019 CALIFORNIA GREEN BUILDING STANDARDS CODE PART 12 - 2019 CALIFORNIA REFERENCED STANDARDS CODE CALIFORNIA CODE OF REGULATIONS, TITLE 19, PUBLIC SAFETY 2010 ADA STANDARDS FOR ACCESSIBLE DESIGN ASCE STEEL CONSTRUCTION MANUAL, 13TH EDITION 2018 NATIONAL DESIGN SPECIFICATION FOR WOOD CONSTRUCTION ACI 318-14 BUILDING CODE REQUIREMENTS FOR STRUCTURAL CONCRETE AND COMMENTARY 2018 NFPA 10 PORTABLE FIRE EXTINGUISHERS 2016 NFPA 72 NATIONAL FIRE ALARM CODE w/ CALIFORNIA AMENDMENTS 	<p>ARCHITECTURAL</p> <ol style="list-style-type: none"> CS COVER SHEET AO.1 GENERAL NOTES, ABBREVIATIONS & SYMBOLS A1.1 SITE PLAN A1.2 ENLARGED SITE PLAN A1.3 SITE DETAILS A2.0 SCHEDULES A2.1 FLOOR PLANS A2.2 ENLARGED FLOOR PLAN A2.3 EQUIPMENT SCHEDULES A5.1 INTERIOR ELEVATIONS A5.2 INTERIOR ELEVATIONS A9.1 INTERIOR DETAILS <p>STRUCTURAL</p> <ol style="list-style-type: none"> SO.1 GENERAL NOTES S2.1 PARTIAL ROOF FRAMING PLANS S2.2 DETAILS & NOTES <p>MECHANICAL</p> <ol style="list-style-type: none"> MO.1 MECHANICAL LEGEND & NOTES MO.2 MECHANICAL SCHEDULES & NOTES MO.3 MECHANICAL SCHEDULES & NOTES MO.4 MECHANICAL SCHEDULES & NOTES MO.5 MECHANICAL SCHEDULES & NOTES MO.6 MECHANICAL SCHEDULES & NOTES M2.1 MECHANICAL OVERALL PLAN & PARTIAL PLANS M5.1 MECHANICAL DETAILS M5.2 MECHANICAL DETAILS M8.1 TITLE 24 ENERGY COMPLIANCE M8.2 TITLE 24 ENERGY COMPLIANCE <p>PLUMBING</p> <ol style="list-style-type: none"> PO.1 PLUMBING LEGEND & NOTES PO.2 PLUMBING SCHEDULES P1.1 PLUMBING OVERALL PLAN & DEMO FLOOR PLAN P2.1 PLUMBING FLOOR PLANS P5.1 PLUMBING DETAILS P5.2 PLUMBING DETAILS P5.3 PLUMBING DETAILS <p>ELECTRICAL</p> <ol style="list-style-type: none"> EO.1 COVER SHEET - ELECTRICAL E1.1 SITE PLAN - ELECTRICAL ONE LINE DIAGRAM, PANEL SCHEDULE E2.0 PARTIAL FLOOR PLAN - DEMOLITION E2.1 PARTIAL FLOOR PLAN - LIGHTING AND SIGNAL E2.2 PARTIAL FLOOR PLAN - POWER E2.3 PARTIAL FLOOR PLAN - FIRE ALARM E4.1 FIRE ALARM DIAGRAMS, FA EQUIPMENT E5.1 ELECTRICAL DETAILS E6.1 T24 COMPLIANCE FORMS <p>THIS SET OF DRAWINGS INCLUDES 42 SHEETS.</p>
	<p>DEFERRED APPROVALS</p> <p>NONE</p>	<p>NOTES</p> <ol style="list-style-type: none"> THE CALIFORNIA ENERGY CODE SECTION 10-103 REQUIRES ACCEPTANCE TESTING ON ALL NEWLY INSTALLED LIGHTING CONTROLS, MECHANICAL SYSTEMS, ENVELOPES, AND PROCESS EQUIPMENT AFTER INSTALLATION AND BEFORE PROJECT COMPLETION. AN ACCEPTANCE TEST IS A FUNCTIONAL PERFORMANCE TEST TO HELP ENSURE THAT NEWLY INSTALLED EQUIPMENT IS OPERATING AND IN COMPLIANCE WITH THE ENERGY CODE. LIGHTING CONTROLS ACCEPTANCE TESTS MUST BE PERFORMED BY A CERTIFIED LIGHTING CONTROLS ACCEPTANCE TEST TECHNICIAN (ATT). MECHANICAL SYSTEM ACCEPTANCE TESTS MUST BE PERFORMED BY A CERTIFIED MECHANICAL ATT FOR PROJECTS SUBMITTED ON OR AFTER OCTOBER 1, 2021. ENVELOPE AND PROCESS EQUIPMENT ACCEPTANCE TESTS SHALL BE PERFORMED BY THE INSTALLING CONTRACTOR, ENGINEER/ARCHITECT OF RECORD OR THE OWNER'S AGENT. A LISTING OF CERTIFIED ATT CAN BE FOUND AT: HTTPS://WWW.ENERGY.CA.GOV/PROGRAMS-AND-TOPICS/PROGRAMS/ACCEPTANCE-TEST-TECHNICIAN-CERTIFICATION-PROVIDER-PROGRAM/ACCEPTANCE. THE ACCEPTANCE TESTING PROCEDURES MUST BE REPEATED, AND DEFICIENCIES MUST BE CORRECTED BY THE BUILDER OR INSTALLING CONTRACTOR UNTIL THE CONSTRUCTION/INSTALLATION OF THE SPECIFIED SYSTEMS CONFORM AND PASS THE REQUIRED ACCEPTANCE CRITERIA. PROJECT INSPECTORS WILL COLLECT THE FORMS TO CONFIRM THAT THE REQUIRED ACCEPTANCE TESTS HAVE BEEN COMPLETED. 	
	<p>DESIGN CRITERIA</p> <p>SEISMIC RISK CATEGORY III SITE CLASS D (DEFAULT) S_s-1.0 11 SDS - 0.809</p> <p>WIND WIND SPEED 100 MPH RC III EXPOSURE C</p>		
	<p>AREA MAP</p>	<p>VICINITY MAP</p>	
		<p>STATEMENT OF GENERAL CONFORMANCE</p> <p>OTHER THAN THE "ARCHITECTURAL" DRAWINGS, THE DRAWINGS FOR THE ITEMS LISTED ABOVE HAVE BEEN PREPARED BY OTHER DESIGN PROFESSIONALS WHO ARE LICENSED AND AUTHORIZED TO PREPARE SUCH DRAWINGS IN THIS STATE. THESE DOCUMENTS HAVE BEEN EXAMINED BY THE ARCHITECT AND HAVE BEEN FOUND TO MEET THE APPROPRIATE REQUIREMENTS OF TITLE 24, CALIFORNIA CODE OF REGULATIONS AND THE PROJECT SPECIFICATIONS PREPARED BY THE ARCHITECT. THE DRAWINGS LISTED ARE ACCEPTABLE FOR INCORPORATION INTO THE CONSTRUCTION OF THIS PROJECT.</p> <p>THE STATEMENT OF GENERAL CONFORMANCE SHALL NOT BE CONSTRUED AS RELIEVING ME OF MY RIGHTS, DUTIES, AND RESPONSIBILITIES UNDER SECTIONS 11302 AND 91139 OF THE EDUCATION CODE AND SECTIONS 4-336, 4-341 AND 4-344 OF TITLE 24, PART 1, TITLE 24, PART 1, SECTION 4-311(B).</p> <p>SIGNATURE: March 1, 2023</p>	

GENERAL NOTES

- THESE DRAWINGS ARE INSTRUMENTS OF SERVICE AND ARE PROPERTY OF THE ARCHITECT AND OTHER INFORMATION ON THE DRAWINGS FOR USE ON THE SPECIFIED PROJECT AND SHALL NOT BE USED OTHERWISE WITHOUT THE EXPRESS WRITTEN PERMISSION.
- THE WORK OF THIS CONTRACT SHALL INCLUDE WORK INDICATED ON THE DRAWINGS AND/OR SPECIFICATIONS WHICH FALL WITHIN THE GENERAL CONSTRUCTION LIMITS (AS DEFINED ON THE DRAWINGS) AND WORK OUTSIDE THE GENERAL CONSTRUCTION LIMITS NOTED OR OTHERWISE INDICATED AS PART OF THE CONTRACT.
- THE CONTRACTOR SHALL FURNISH LABOR, MATERIALS, TOOLS, TRANSPORTATION, AND EQUIPMENT NECESSARY TO PERFORM WORK UNDER HIS TRADE IN FULL ACCORDANCE WITH THE WORKING DRAWINGS, SPECIFICATIONS AND CONTRACTS.
- THE CONTRACTOR IS RESPONSIBLE FOR INCLUDING INCIDENTAL WORK NECESSARY TO FACILITATE AND COMPLETE THE INSTALLATION OF NEW WORK. THIS INCLUDES, BUT IS NOT LIMITED TO, THE REMOVAL AND/OR REINSTALLATION OF EXISTING ITEMS OR PORTIONS OF THE EXISTING CONSTRUCTION WHETHER SHOWN OR NOT.
- SPECIFIC ITEMS NOTED TO BE VERIFIED OR FIELD VERIFIED ARE REQUIRED TO BE VERIFIED BY THE CONTRACTOR PRIOR TO ORDERING MATERIALS AND EQUIPMENT BEFORE PROCEEDING WITH THE WORK. LACK OF DOING SO WILL BE AT THE CONTRACTOR'S RISK.
- THE CONTRACTOR SHALL BE RESPONSIBLE FOR APPROPRIATE SITE VISITS TO CONFIRM FIELD CONDITIONS AND ESTIMATING PROPERLY THE DIFFICULTY AND COST OF SUCCESSFULLY PERFORMING THE WORK PRIOR TO BIDDING.
- DIMENSIONS:
 - DIMENSIONS SHALL HAVE PREFERENCE OVER SCALE.
 - DIMENSIONS ARE TO BE ROUGH UNLESS OTHERWISE NOTED.
 - DIMENSIONS TO STUD PARTITIONS ARE TO F.O.S. UNLESS OTHERWISE NOTED.
 - CEILING HEIGHT DIMENSIONS ARE FROM FINISH FLOOR TO UNDERSIDE OF CEILING JOIST.
 - DIMENSIONS SHALL BE VERIFIED IN FIELD BEFORE PROCEEDING WITH THE WORK.
 - CONTRACTORS SHALL VERIFY AND BE RESPONSIBLE FOR DIMENSIONS AND CONDITIONS ON THE JOB AND THE ARCHITECT SHALL BE NOTIFIED OF ERRORS, OMISSIONS OR VARIATIONS FROM THE DIMENSIONS AND CONDITIONS SHOWN ON THESE DRAWINGS. WHERE VARIATIONS EXIST THE ARCHITECT SHALL PROVIDE CORRECTION OR DIRECTION BEFORE THE CONTRACTOR SHALL PROCEED w/ THE WORK.
- ITEMS MARKED " TYP." OR "TYPICAL" SHALL APPLY UNLESS SPECIFICALLY INDICATED OTHERWISE.
- WHERE NO SPECIFIC DETAIL IS SHOWN, THE FRAMING OR CONSTRUCTION SHALL BE IDENTICAL OR SIMILAR TO THAT INDICATED FOR LIKE CASES OF CONSTRUCTION ON THIS PROJECT.
- ALL WORK & MATERIALS ARE NEW UNLESS INDICATED AS EXISTING.
- IF A CONTRACTOR DISCOVERS UNDOCUMENTED MATERIALS WHICH HE SUSPECTS MAY CONTAIN ASBESTOS OR OTHER HAZARDOUS MATERIALS, THE CONTRACTOR SHOULD STOP WORK IMMEDIATELY AND CONTACT THE PROJECT MANAGER. THE MATERIALS SHALL BE TESTED AND APPROPRIATE ACTION TAKEN BY THE OWNER.
- CONSTRUCTION IS TO COMPLY WITH CFG CHAPTER 33 - FIRE SAFETY DURING CONSTRUCTION AND DEMOLITION.

DIVISION OF THE STATE ARCHITECT

- A COPY OF PARTS 1 TO 5 & 9, TITLE 24, C.C.R. SHALL BE KEPT ON THE JOB SITE AT ALL TIMES.
- ALL ADDENDA ARE TO BE SIGNED BY THE ARCHITECT AND APPROVED BY DSA. ADDENDA ARE NOT VALID UNTIL APPROVED BY DSA PER SECTION 4-338, PART 1, TITLE 24.
- ALL CHANGES, INCLUDING SUBSTITUTIONS, TO THE STRUCTURAL, ACCESSIBILITY, OR FIRE AND LIFE SAFETY PORTIONS OF THE APPROVED PLANS AND SPECIFICATIONS AFTER THE WORK HAS BEEN LET SHALL BE SUBMITTED AND APPROVED BY DSA PRIOR TO COMMENCEMENT OF THE WORK. CONSTRUCTION CHANGE DOCUMENTS SHALL BE PREPARED AND SUBMITTED TO DSA IN COMPLIANCE WITH DSA INTERPRETATION OF REGULATION (IR) A-6.
- ALL TESTS SHALL CONFORM TO THE REQUIREMENTS OF SECTION 4-335, PART 1, TITLE 24 AND THE APPROVED LIST OF STRUCTURAL TESTS AND SPECIAL INSPECTIONS, FORM DSA-103.
- TESTS OF MATERIALS AND TESTING LABORATORY SHALL BE IN ACCORDANCE WITH SECTION 4-335, PART 1 OF TITLE 24 AND THE DISTRICT SHALL EMPLOY AND PAY A DSA ACCEPTED LABORATORY. COSTS OF RE-TEST SHALL BE PER THE GENERAL CONDITIONS.
- DSA SHALL BE NOTIFIED AT THE START OF CONSTRUCTION AND PRIOR TO THE PLACEMENT OF CONCRETE PER SECTION 4-331, PART 1, TITLE 24.
- A DSA CERTIFIED PROJECT INSPECTOR SHALL BE EMPLOYED BY THE DISTRICT AND APPROVED BY DSA. INSPECTION SHALL BE IN ACCORDANCE WITH SECTION 4-333(b). THE DUTY OF THE INSPECTOR SHALL BE IN ACCORDANCE WITH SECTION 4-324, PART 1, TITLE 24.
- SUPERVISION OF CONSTRUCTION BY DSA SHALL BE IN ACCORDANCE WITH SECTION 4-334, PART 1, TITLE 24.
- THE CONTRACTOR, INSPECTOR, ARCHITECT, AND ENGINEERS SHALL SUBMIT VERIFIED REPORTS IN ACCORDANCE WITH SECTIONS 4-336 AND 4-343, PART 1, TITLE 24.
- THE ARCHITECT AND STRUCTURAL ENGINEER SHALL PERFORM THEIR DUTIES IN ACCORDANCE WITH SECTIONS 4-333(a) AND 4-341, PART 1, TITLE 24.
- THE CONTRACTOR SHALL PERFORM HIS DUTIES IN ACCORDANCE WITH SECTIONS 4-336 AND 4-343, PART 1, TITLE 24.
- THE INTENT OF THESE DRAWINGS AND SPECIFICATIONS IS THAT THE WORK OF ALTERATION, REHABILITATION OR RECONSTRUCTION IS TO BE IN ACCORDANCE WITH TITLE 24, CALIFORNIA CODE OF REGULATIONS. SHOULD ANY EXISTING CONDITION SUCH AS DETERIORATION OR NON-COMPLYING CONSTRUCTION BE DISCOVERED WHICH IS NOT COVERED BY THE CONTRACT DOCUMENTS WHEREIN THE FINISHED WORK WILL NOT COMPLY WITH TITLE 24, C.C.R., A CONSTRUCTION CHANGE DOCUMENT (CCD) OR SEPARATE SET OF PLANS AND SPECIFICATIONS, DETAILING AND SPECIFYING THE REQUIRED WORK SHALL BE SUBMITTED TO AND APPROVED BY DSA BEFORE PROCEEDING WITH THE WORK.

- ALL WORK SHALL CONFORM TO 2019 TITLE 24, CALIFORNIA CODE OF REGULATIONS (C.C.R.).
- CHANGES TO THE APPROVED DRAWINGS AND SPECIFICATIONS SHALL BE MADE BY AN ADDENDUM OR A CONSTRUCTION CHANGE DOCUMENT (CCD) APPROVED BY THE DIVISION OF THE STATE ARCHITECT, AS REQUIRED BY SECTION 4-338, PART 1, TITLE 24, C.C.R.
- GRADING PLANS, DRAINAGE IMPROVEMENTS, ROAD AND ACCESS REQUIREMENTS AND ENVIRONMENTAL HEALTH CONSIDERATIONS SHALL COMPLY WITH ALL LOCAL ORDINANCES.

4	AND
∠	ANGLE
@	AT
⊕	CENTER LINE
∅	DIAMETER OF ROUND
⊥	PERPENDICULAR
⊃	PLATE/PROPERTY LINE
±	PLUS OR MINUS
#	POUND/NUMBER

ABBREV.	ABBREVIATIONS
AC	ASPHALTIC CONCRETE
ACC.	ACCESSIBLE
ACOUS.	ACOUSTICAL
A.D.	AREA DRAIN
ADJ.	ADJUSTABLE/ADJACENT
A.F.F.	ABOVE FINISHED FLOOR
AGGR.	AGGREGATE
AHJ	AUTHORITY HAVING JURISDICTION
ALT.	ALTERNATE
AL.	ALUMINUM
AN.	ANODIZED
APPROX.	APPROXIMATE
ARCH.	ARCHITECTURAL
ASPH.	ASPHALT
ASST.	ASSISTANT

BD.	BOARD
BITUM.	BITUMINOUS
BLDG.	BUILDING
BLK.	BLOCK
BLKG.	BLOCKING
BTM	BETWEEN

CAB.	CABINET
CB.	CATCH BASIN
C.B.C.	CALIFORNIA BUILDING CODE
CEM.	CEMENT
CER.	CERAMIC
CFM.	CUBIC FEET PER MINUTE
C.I.	CAST IRON
C.J.	CONSTRUCTION JOINT
C.L.	CHAIN LINK
CLS.	CEILING
CLO.	CLOSET
CLR.	CLEAR/CLEARANCE
COL.	COLUMN
CONG.	CONCRETE
CONF.	CONFERENCE
CONN.	CONNECTION
CONSTR.	CONSTRUCTION
CONT.	CONTINUOUS
CORR.	CORRIDOR
C.T.	CERAMIC TILE
CTS&K.	COUNTERSUNK CENTER

DBL.	DOUBLE
DEPT.	DEPARTMENT
D.F.	DRINKING FOUNTAIN
DF.	DOUGLAS FIR
D.G.	DECOMPOSED GRANITE
D.I.	DROP INLET
DIA.	DIAMETER
DIAS.	DIAGONAL
DIM.	DIMENSION
DISP.	DISPENSER
DN.	DOWN
D.O.	DOOR OPENING
DS.	DOWN SPOUT
D.S.P.	DRY STANDPIPE
DTL.	DETAIL
DWG.	DRAWING

(E)	EXISTING
E	EAST
EA.	EACH
E.J.	EXPANSION JOINT
ELEG.	ELECTRICAL
ELEV.	ELEVATION
EMER.	EMERGENCY
E.N.	EDGE NAIL/END NAIL
ENCL.	ENCLOSURE
EP.	ELECTRICAL PANEL BOARD
EQ.	EQUAL
EGPT.	EQUIPMENT
EXP.	EXPANSION
EXT.	EXTERIOR

(F)	FUTURE
F.A.	FIRE ALARM
F.D.	FLOOR DRAIN
FDN.	FOUNDATION

ABBREVIATIONS

F.E.	FIRE EXTINGUISHER
F.E.G.	FIRE EXTINGUISHER CABINET
FF.	FINISH FLOOR
F.H.G.	FIRE HOSE CABINET
FIN.	FINISH
FLR.	FLOOR
FLASH.	FLASHING
FLUOR.	FLUORESCENT
F.N.	FIELD NAIL
F.O.C.	FACE OF CONCRETE
F.O.F.	FACE OF FINISH
F.O.S.	FACE OF STUD(S)
FRM.G.	FRAMING
FRP.	FIBER REINFORCED PLASTIC
FT.	FOOT OR FEET
FTG.	FOOTING
FURR.	FURRING
FUT.	FUTURE

GA.	GAUGE
GALV.	GALVANIZED
GB.	GRAB BAR
G.C.	GENERAL CONTRACTOR
GI.	GALVANIZED IRON
GND.	GROUND
GYP. BD.	GYPSON BOARD
H.B.	HOSE BIB
H.C.	HOLLOW CORE
HDWD.	HARDWOOD
H.M.	HOLLOW METAL
HORIZ.	HORIZONTAL
HR.	HOUR
HT.	HEIGHT
HVAC.	HEATING-VENTING & AIR CONDITIONING

ID.	INSIDE DIAMETER
INSUL.	INSULATION
INT.	INTERIOR

JAN.	JANITOR
J.H.	JOIST HANGER
JT.	JOINT

KIT.	KITCHEN
------	---------

LAB.	LABORATORY
LAM.	LAMINATE
LAU.	LAUNDRY
LAV.	LAVATORY
LBS.	POUND(S)
L.F.	LINEAR FEET
LT.	LIGHT

MATL.	MATERIAL
MAX.	MAXIMUM
MCT.	MARMOLEUM COMPOSITE TILE
MDF.	MEDIUM DENSITY FIBERBOARD
MECH.	MECHANICAL
MEMB.	MEMBRANE
MFR.	MANUFACTURER
MFRD.	MANUFACTURED
MFRG.	MANUFACTURING
MH.	MANHOLE
MIN.	MINIMUM
MISC.	MISCELLANEOUS
MTD.	MOUNTED
MTL.	METAL
MUL.	MULLION

(N)	NEW
N	NORTH
N/A	NOT APPLICABLE
N.I.C.	NOT IN CONTRACT
NO.	NUMBER
NOM.	NOMINAL
N.T.S.	NOT TO SCALE

O/	OVER
O.A.	OVERALL
OBS.	OBSCURE
O.C.	ON CENTER
O.D.	OUTSIDE DIAMETER
OFF.	OFFICE
O.H.	OPPOSITE HAND
O.I.	ORNAMENTAL IRON
OFI.	OWNER FURNISHED, CONTRACTOR INSTALLED
OFI.	OWNER FURNISHED, OWNER INSTALLED
OPNG.	OPENING
OPP.	OPPOSITE
OSB.	ORIENTED STRAND BOARD
OZ.	OUNCE(S)

P.D.F.	POWER DRIVEN FASTENER
PL.	PLATE
P.LAM.	PLASTIC LAMINATE
PLAS.	PLASTER
PLYWD.	PLYWOOD
P.M.F.	PRESSED METAL FRAME
P.O.T.	PATH OF TRAVEL
PR.	PAIR
PREP.	PREPARE/PREPARATION
PT.	PAINT
PTD.	PAINTED
P.T.D.	PAPER TOWEL DISPENSER
P.T.D./R.	COMBINATION PAPER TOWEL DISPENSER/RECEPTACLE
PTDF.	PRESSURE TREATED DOUGLAS FIR PARTITION
PTN.	PARTITION

Q.T.	QUARRY TILE
(R)	REMOVE/DEMOLISH
RAD.	RADIUS
R.D.	ROOF DRAIN
R.D.W.D.	ROOF DRAIN
REF.	REFRIGERATOR
REINF.	REINFORCED
REQ.	REQUIRED
RM.	ROOM
R.O.	ROUGH OPENING
R.W.L.	RAIN WATER LEADER

S	SOUTH
S&P.	SHELF & POLE
S.B.	SPLASH BLOCK
S.C.	SOLID CORE
S.C.D.	SEAT COVER DISPENSER
SCHED.	SCHEDULE
S.D.	SOAP DISPENSER
SECT.	SECTION
SF.	SQUARE FOOT/FEET
SH.	SHELF
SHT.	SHEET
SIM.	SIMILAR
S.M.S.	SHEET METAL SCREW
S.N.D.	SANITARY NAPKIN DISPENSER
S.N.R.	SANITARY NAPKIN RECEPTACLE
SPEC.	SPECIFICATION
SQ.	SQUARE
SS.	SANITARY SEWER
S.S.K.	SERVICE SINK
STA.	STATION
STD.	STANDARD
STL.	STEEL
STOR.	STORAGE
S.T.S.	SELF-DRILLING/SELF-TAPPING SCREW
STRUCT.	STRUCTURAL
SUSP.	SUSPENDED
S.Y.	SQUARE YARD
SYM.	SYMMETRICAL


T&G	TONGUE & GROOVE
TC	TOP OF CURB
TEMP.	TEMPORARY
THK.	THICK
TMP.	TEMPERED
T.O.	TOP OF
TP.	TOP OF PAVEMENT
T.P.D.	TOILET PAPER DISPENSER
TRD.	TREAD
TV.	TELEVISION
TYP.	TYPICAL

UNFIN.	UNFINISHED
U.O.N.	UNLESS OTHERWISE NOTED
UTIL.	UTILITY/UTILITIES
U/S	UNDER SIDE
VCT.	VINYL COMPOSITION TILE
VEST.	VESTIBULE
V.I.F.	VERIFY IN FIELD
VERT.	VERTICAL

W	WEST
w/o	WITHOUT
W.C.	WATER CLOSET
WD.	WOOD
W.D.O.	WINDOW
WH.	WATER HEATER
WI.	WROUGHT IRON
WP.	WATER PROOF
WR.	WATER RESISTANT
WT.	WEIGHT
W.W.F.	WELDED WIRE FABRIC

YD.	YARD
-----	------

SYMBOL LEGEND

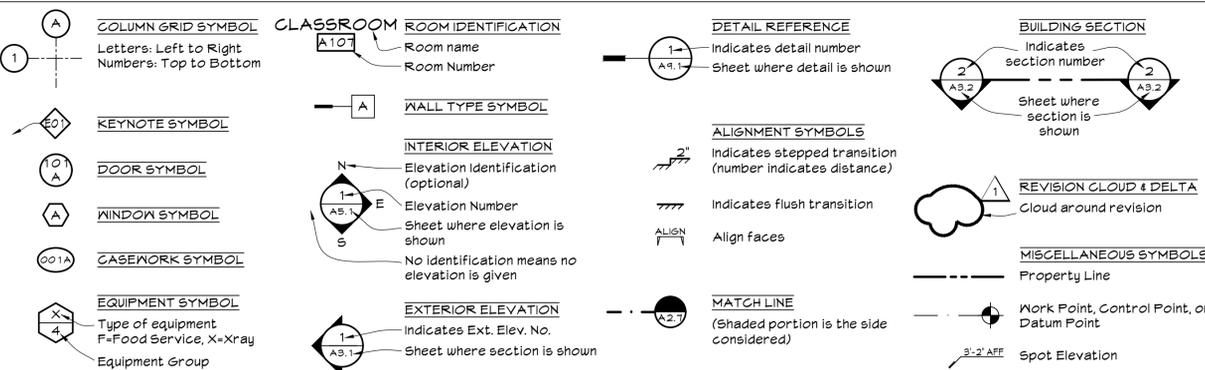

©2023 Synthesis Partners, LLC. All Rights Reserved.
These record drawings have been prepared based upon information submitted, in part, by others. While this information is believed to be reliable, The Architect is not responsible for their accuracy, nor for errors or omissions which may have been incorporated into these documents as a result.

PO Box 1900
Yuba City, CA 95992-1900
530.298.7298
www.spinc-arch.com

ARCHITECTURAL • COMMERCIAL • RESIDENTIAL • INTERIOR • CONSTRUCTION MANAGEMENT



SYNTHESIS PARTNERS, LLC
Managers • Architects


OWNER

Woodland Joint Unified School District
435 6th Street
Woodland, CA 95695

PROJECT

CLASSROOM CONVERSIONS
at
WOODLAND EDUCATION CENTER
575 Hays Street
Woodland, CA 95695

KEY PLAN

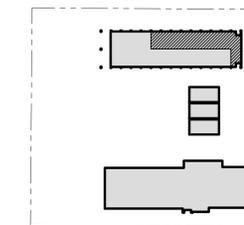


THIS IS A PRELIMINARY SET FOR REVIEW ONLY NOT FOR CONSTRUCTION

NO.	REVISION DESCRIPTION	DATE

GENERAL NOTES, ABBREVIATIONS & SYMBOLS

DATE 2023-03-01
PROJECT NO. 21-W04-01

A0.1

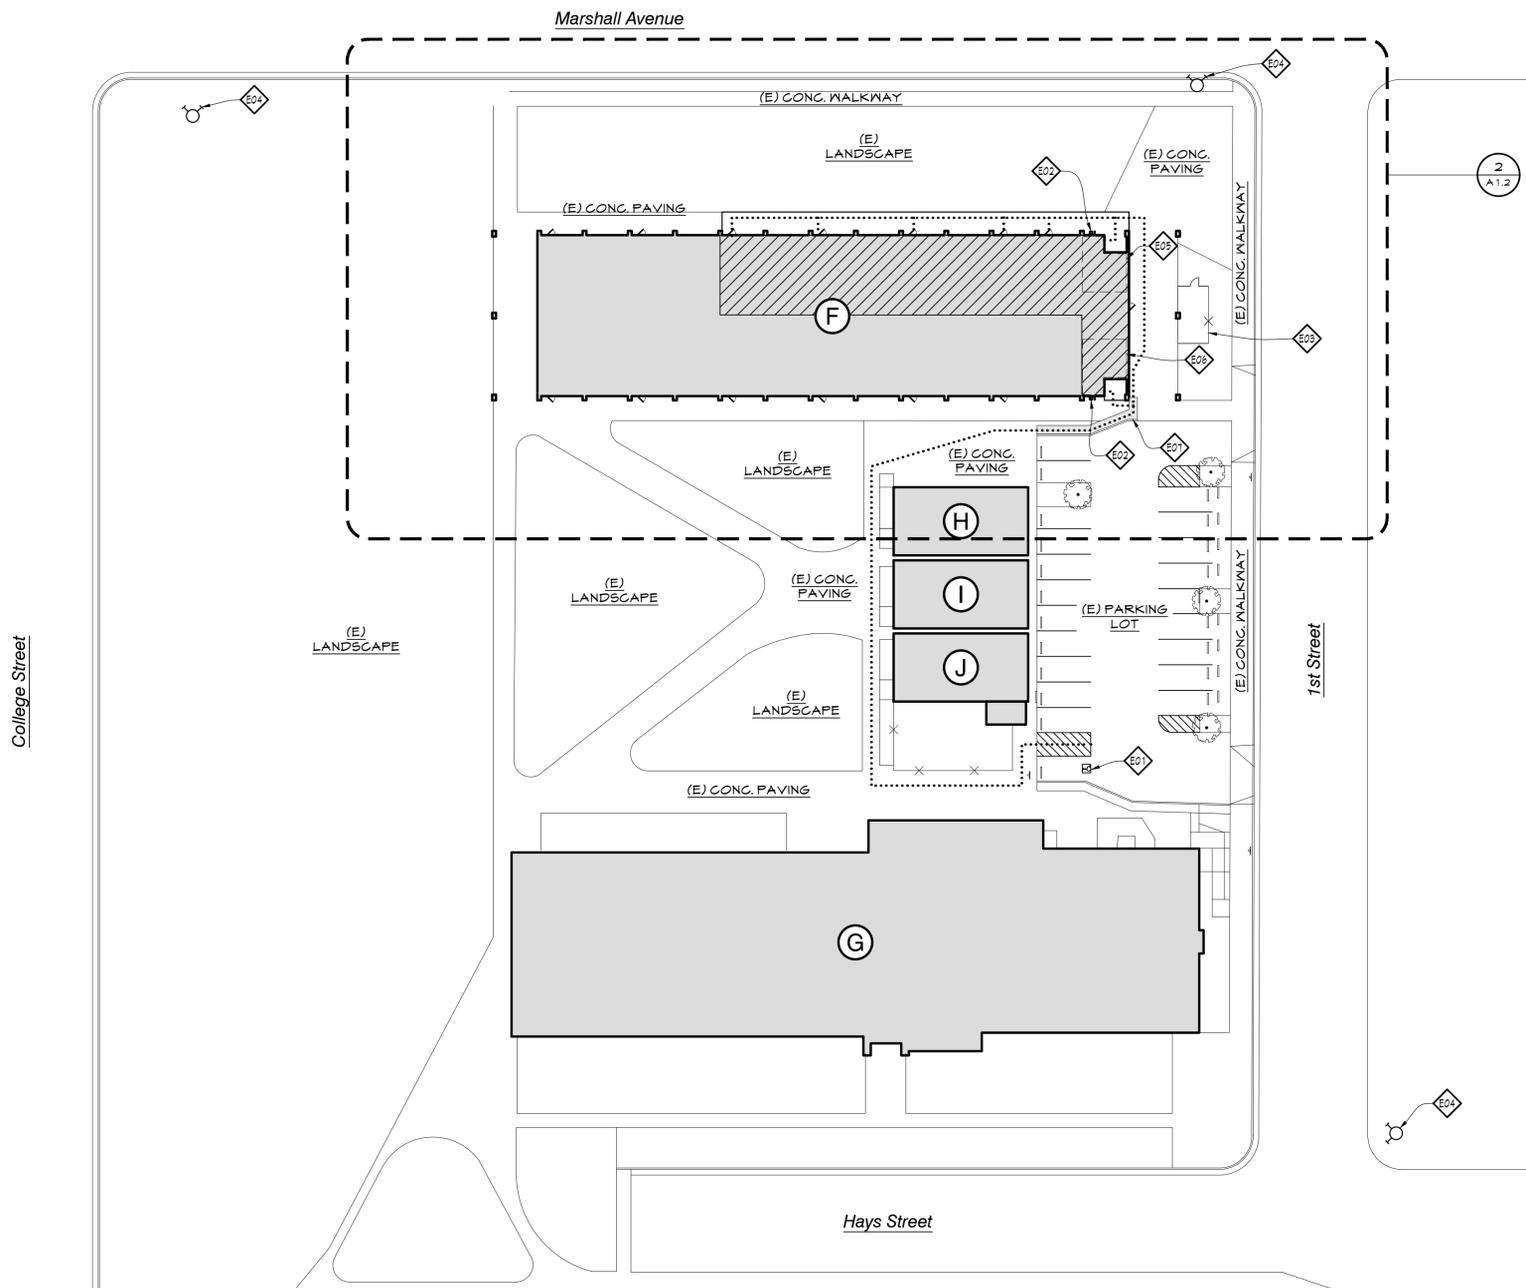

BLDG	DSA APPL. #	YEAR	CONST.	OCC.	AREA
F	02-26093	1965	VB	E	11,895 SF
	02-113054	2013	VB	E	11,895 SF
G	02-26093	1965	VB	E	16,658 SF
	(E) CLASSROOMS & CAFETERIA BUILDING				
H	02-26093	1965	V-N	E	1,442 SF
	(E) RELOCATABLE CLASSROOM				
I	02-26093	1965	V-N	E	1,442 SF
	(E) RELOCATABLE CLASSROOM				
J	02-26093	1965	V-N	E	1,442 SF
	(E) RELOCATABLE CLASSROOM				

- KEYNOTES**
- E01 VAN ACC. PARKING STALL & TOW-AWAY SIGN - DSA # 02-115590
 - E02 DF. - DSA # 02-26093 TO BE REMODELED IN THIS APPL.
 - E03 CHAIN LINK FENCE
 - E04 FIRE HYDRANT
 - E05 BOYS RESTROOM - DSA # 02-26093 TO BE REMODELED IN THIS APPL.
 - E06 GIRLS RESTROOM - DSA # 02-26093 TO BE REMODELED IN THIS APPL.
 - E07 TRUNCATED DOMES - DSA# 02-115590

ACCESSIBLE PATH OF TRAVEL

.....PATH OF TRAVEL (P.O.T.)

- AS INDICATED IS A BARRIER-FREE ACCESS w/o ANY ABRUPT VERTICAL CHANGES EXCEEDING 1/2" AT 1:2 MAX. SLOPE, EXCEPT THAT LEVEL CHANGES DO NOT EXCEED 1/2" VERTICAL.
- SURFACES SHALL BE MIN. 4'-0" WIDE (OR AS OTHERWISE APPROVED BY CODE) AND SHALL BE STABLE, FIRM, AND SLIP-RESISTANT AND NOT EXCEED 1:20 (5%) RUNNING SLOPE U.O.N. AND 1:50 (2%) CROSS SLOPE.
- HAS A 4" MAX. DROP AT EDGE OF P.O.T. EXCEPT ADJACENT TO PARKING AREAS WHERE EDGE MAY BE UP TO 6" MAX.
- SHALL BE FREE OF OVERHANGING OBSTRUCTIONS TO 80" MIN. AND PROTRUDING OBJECTS GREATER THAN 4" PROJECTION FROM WALLS BETWEEN 27" AND 80" ABOVE THE P.O.T. SURFACE.
- PASSING SPACES OF AT LEAST 60"X60" SHALL BE LOCATED NOT MORE THAN 200'-0" APART.
- WALKS WITH CONTINUOUS GRADIENTS HAVE 60" IN LENGTH OF LEVEL AREAS (11B-403.7) NOT MORE THAN 400'-0" APART.

DESIGN PROFESSIONAL IN GENERAL RESPONSIBLE CHARGE STATEMENT:
 THE P.O.T. IDENTIFIED IN THESE CONSTRUCTION DOCUMENTS IS COMPLIANT WITH THE CURRENT APPLICABLE CBC ACCESSIBILITY PROVISIONS FOR PATH OF TRAVEL REQUIREMENTS FOR ALTERATIONS, ADDITIONS AND STRUCTURAL REPAIRS.

AS PART OF THE DESIGN OF THIS PROJECT, THE P.O.T. WAS EXAMINED AND ANY ELEMENTS, COMPONENTS OR PORTIONS OF THE P.O.T. THAT WERE DETERMINED TO BE NONCOMPLIANT 1) HAVE BEEN IDENTIFIED AND 2) THE CORRECTIVE WORK NECESSARY TO BRING THEM INTO COMPLIANCE HAS BEEN INCLUDED WITHIN THE SCOPE OF THIS PROJECT'S WORK THROUGH DETAILS, DRAWINGS AND SPECIFICATIONS INCORPORATED INTO THESE CONSTRUCTION DOCUMENTS. ANY NONCOMPLIANT ELEMENTS, COMPONENTS OR PORTIONS OF THE P.O.T. THAT WILL NOT BE CORRECTED BY THIS PROJECT BASED ON VALUATION THRESHOLD LIMITATIONS OR A FINDING OF UNREASONABLE HARDSHIP ARE SO INDICATED IN THESE CONSTRUCTION DOCUMENTS.

DURING CONSTRUCTION, IF P.O.T. ITEMS WITHIN THE SCOPE OF THE PROJECT REPRESENTED AS CODE COMPLIANT ARE FOUND TO BE NONCONFORMING BEYOND REASONABLE CONSTRUCTION TOLERANCES, THEY SHALL BE BROUGHT INTO COMPLIANCE WITH THE CBC AS PART OF THIS PROJECT BY MEANS OF A CONSTRUCTION CHANGE DOCUMENT (DSA FORM 140, CCD).

LEGEND

	AREA OF WORK		(E) BUILDING
	(E) FIRE HYDRANT		

©2023 Synthesis Partners, LLC. All Rights Reserved.
 These record drawings have been prepared based upon information submitted, in part, by others. While this information is believed to be reliable, the Architect is not responsible for their accuracy, nor for errors or omissions which may have been incorporated into these documents as a result.

PO Box 1900
 Yuba City, CA 95992-1900
 530.298.7298
 www.spinc-arch.com

ARCHITECTURAL • COMMERCIAL • RESIDENTIAL • INTERIORS • CONSTRUCTION MANAGEMENT



SYNTHESIS PARTNERS, LLC
 Managers • Architects

APPROVALS


OWNER

Woodland Joint Unified School District
 435 6th Street
 Woodland, CA 95695

PROJECT

CLASSROOM CONVERSIONS
 at
 WOODLAND EDUCATION CENTER
 575 Hays Street
 Woodland, CA 95695

KEY PLAN

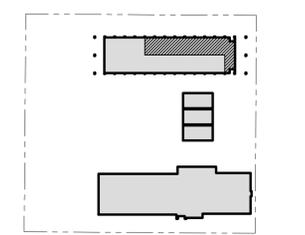

THIS IS A PRELIMINARY SET FOR REVIEW ONLY NOT FOR CONSTRUCTION


NO.	REVISION DESCRIPTION	DATE

SITE PLAN

A1.1

DATE 2023-03-01
 PROJECT NO. 21-W04-01

Marshall Avenue

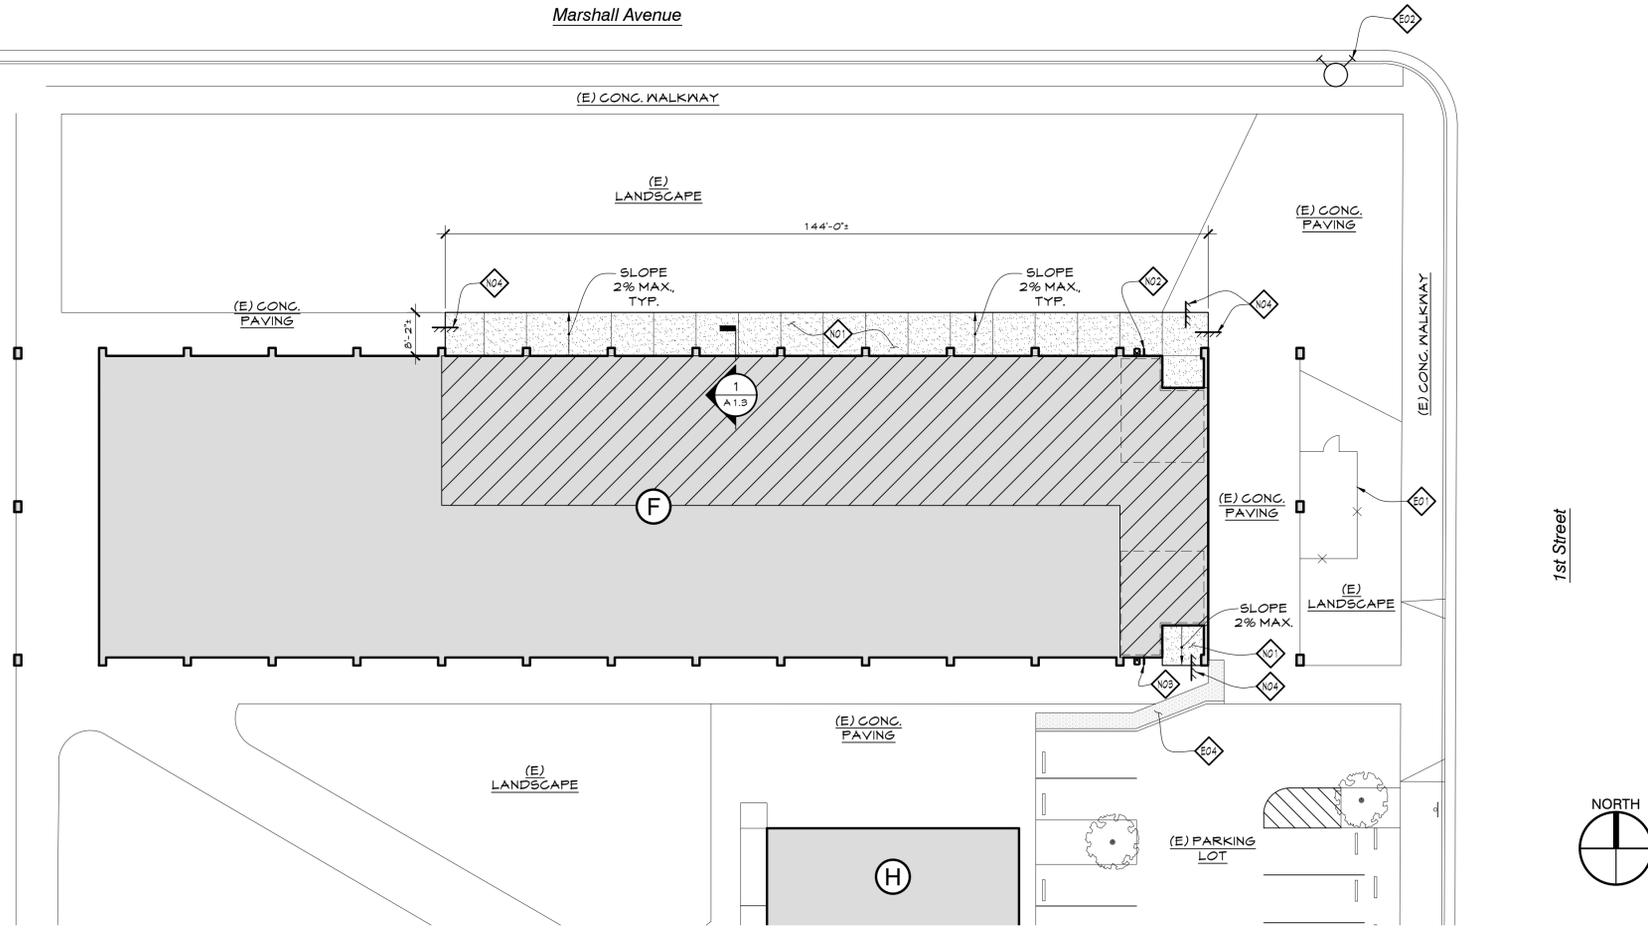

ENLARGED SITE PLAN - ALTERATION

SCALE: 1/16" = 1'-0" 2

KEYNOTES

- EXISTING**
- E01 CHAIN LINK FENCE
- E02 FIRE HYDRANT
- E03 D.F. - DSA # 02-26093 TO BE REMODELED IN THIS APPL
- E04 TRUNCATED DOMES - DSA# 02-115590
- E05 BOYS RESTROOM - DSA # 02-26093 TO BE REMODELED IN THIS APPL.
- E06 GIRLS RESTROOM - DSA # 02-26093 TO BE REMODELED IN THIS APPL.


REMOVAL / DEMOLITION

- R01 CHAIN LINK FENCE & GATE
- R02 CONG. PAVING


NEW / ALTERATION

- N01 CONG. PAVING - SEE DTL. 546/A1.3
- N02 ACC. BARRIER AT HIGH D.F. - SEE DTL. 4/A1.3, SIM.
- N03 ACC. BARRIER AT LOW D.F. - SEE DTL. 4/A1.3, SIM.
- N04 PROVIDE FLUSH TRANSITION - SEE DTL. 2/A1.3

LEGEND

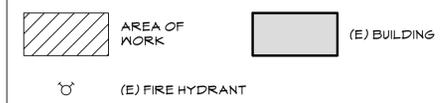

Marshall Avenue

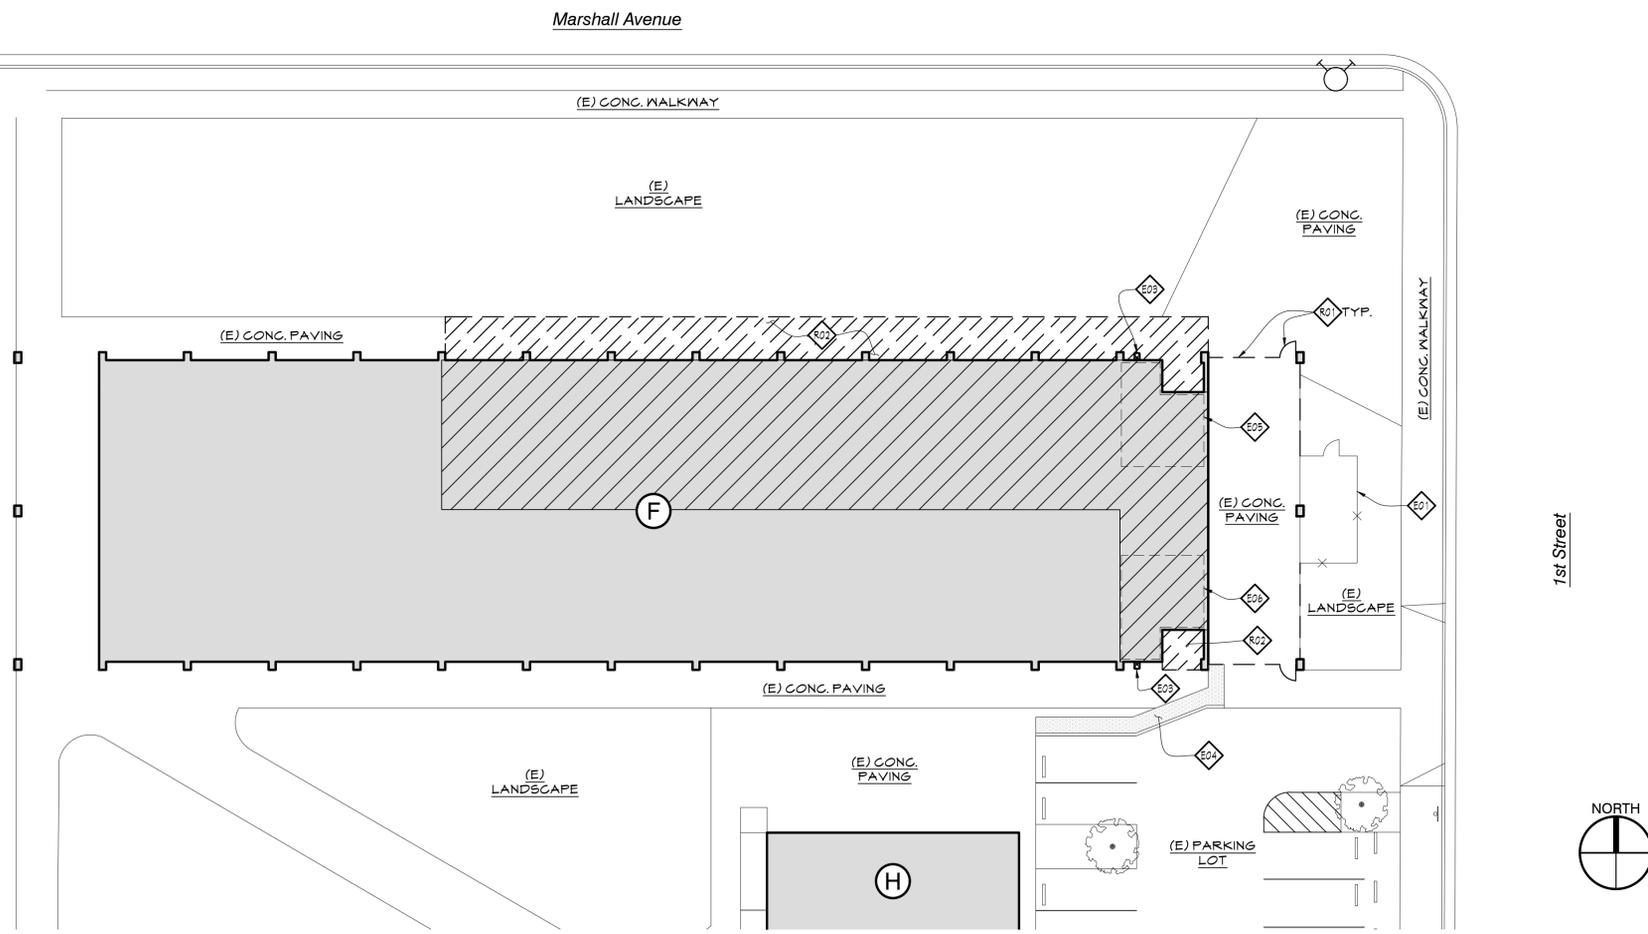

ENLARGED SITE PLAN - DEMOLITION

SCALE: 1/16" = 1'-0" 1

APPROVALS

PO Box 1900
 Yuba City, CA 95992-1900
 530.298.7298
 www.spinc-arch.com



SYNTHESIS PARTNERS, LLC
 Managers • Architects


OWNER

Woodland Joint Unified School District
 435 6th Street
 Woodland, CA 95695

PROJECT

CLASSROOM CONVERSIONS
 at
 WOODLAND EDUCATION CENTER
 575 Hays Street
 Woodland, CA 95695

KEY PLAN

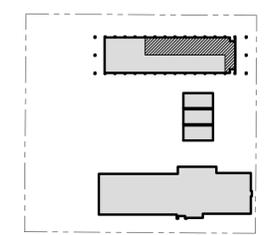

THIS IS A PRELIMINARY SET FOR REVIEW ONLY NOT FOR CONSTRUCTION




NO.	REVISION DESCRIPTION	DATE

ENLARGED SITE PLANS


A1.2

DATE 2023-03-01
 PROJECT NO. 21-W04-01


©2023 Synthesis Partners, LLC. All Rights Reserved.
 These record drawings have been prepared based upon information submitted, in part, by others. While this information is believed to be reliable, the Architect is not responsible for their accuracy, nor for errors or omissions which may have been incorporated into these documents as a result.

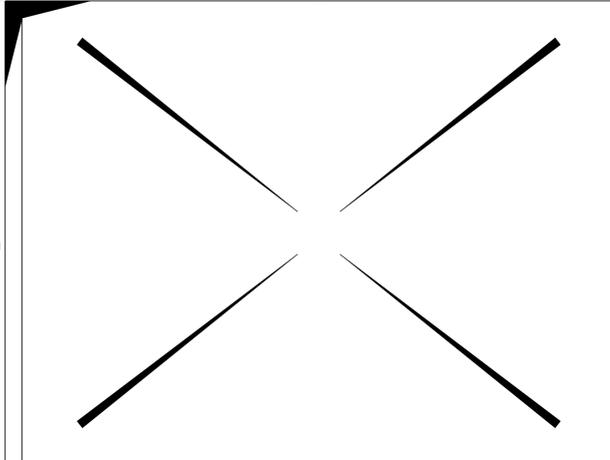


NOT USED SCALE: NONE 16

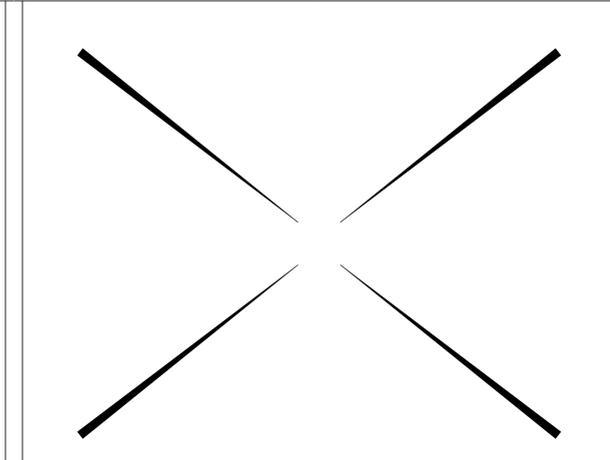


NOT USED SCALE: NONE 12

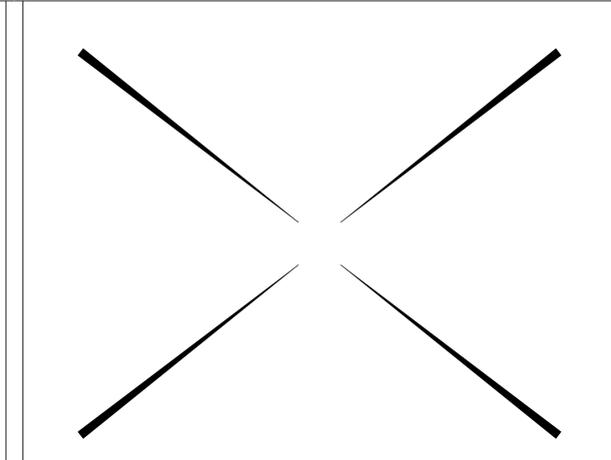


NOT USED SCALE: NONE 8

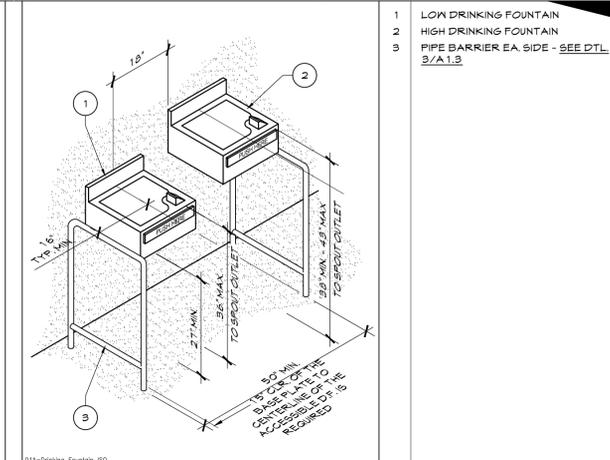


ACCESSIBLE WALL MOUNTED D.F. SCALE: 1/2" = 1'-0" 4

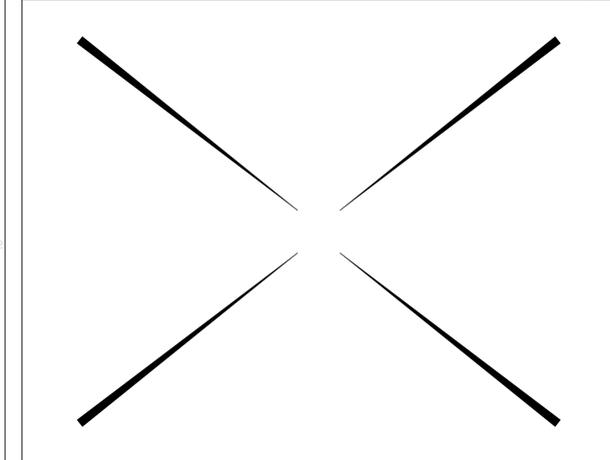


NOT USED SCALE: NONE 15

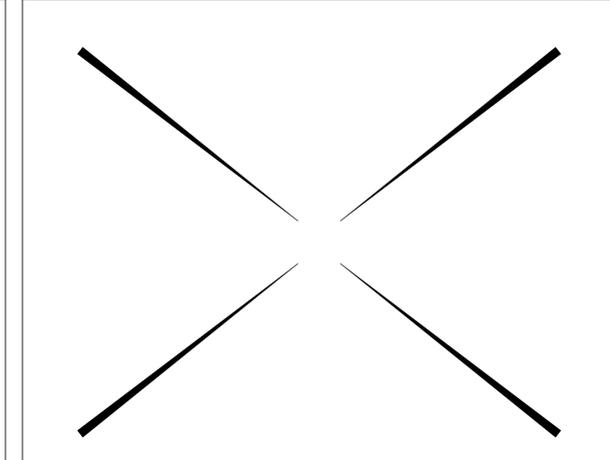


NOT USED SCALE: NONE 11

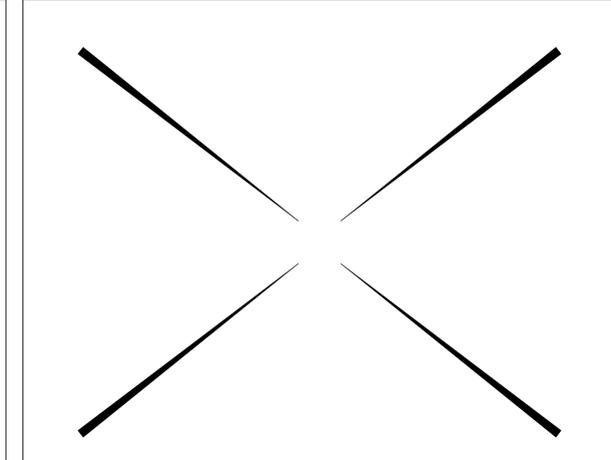


PIPE BARRIER AND ANCHOR SCALE: 3/4" = 1'-0" 7

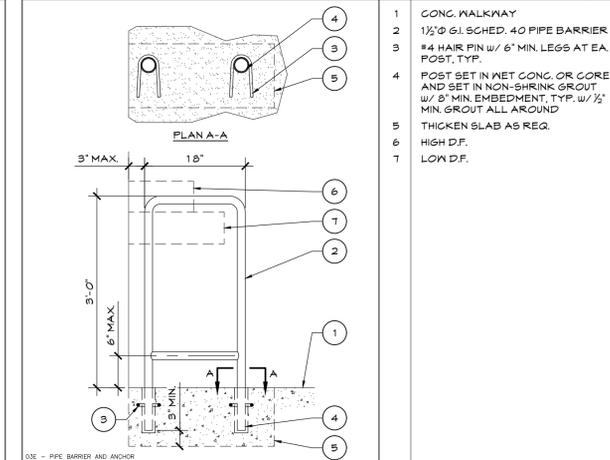


PIPE BARRIER AND ANCHOR SCALE: 3/4" = 1'-0" 3

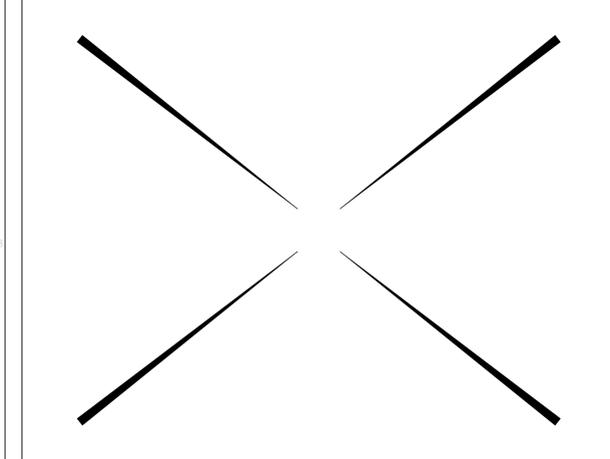


NOT USED SCALE: NONE 14

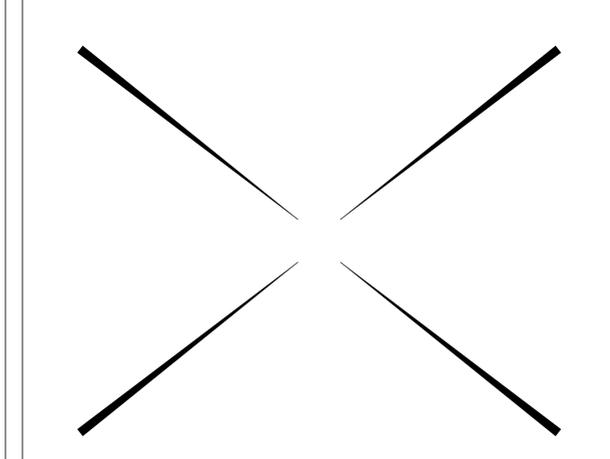


NOT USED SCALE: NONE 10

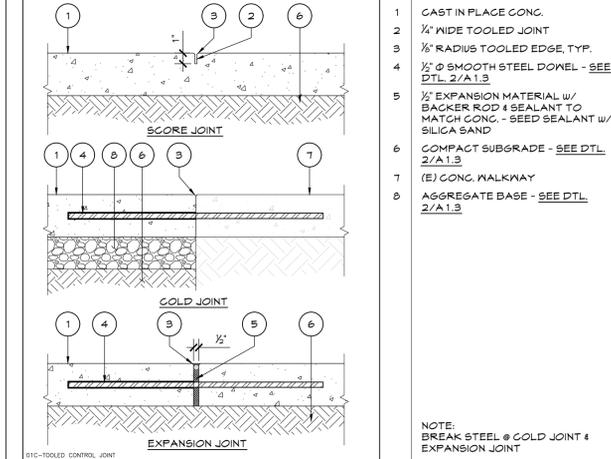


TOOLED CONTROL JOINTS SCALE: 1-1/2" = 1'-0" 6

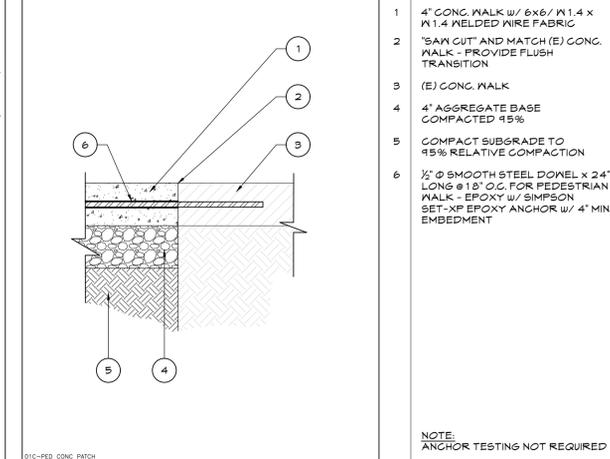


PEDESTRIAN WALK CONCRETE PATCH SCALE: 1 1/2" = 1'-0" 2

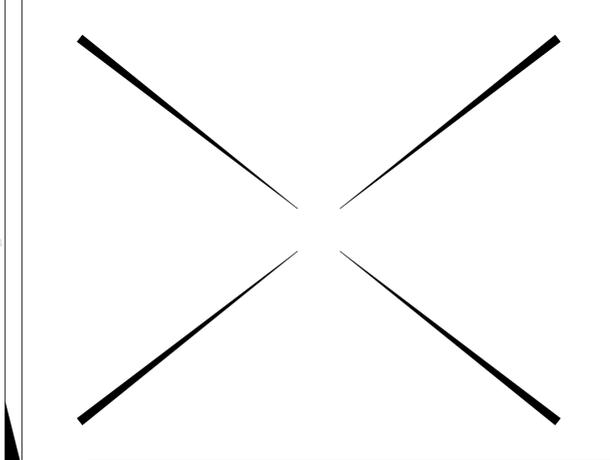


NOT USED SCALE: NONE 13

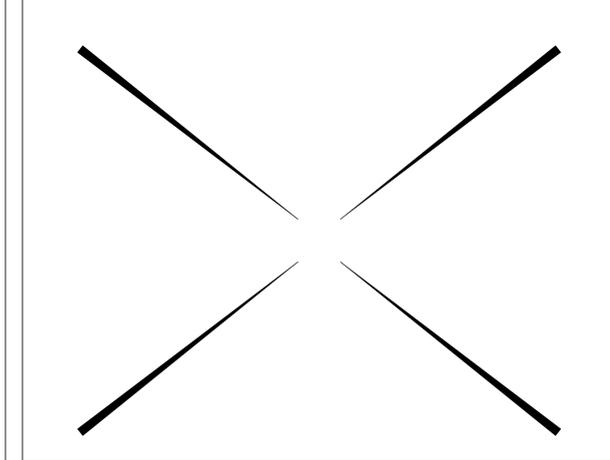

NOT USED SCALE: NONE 9

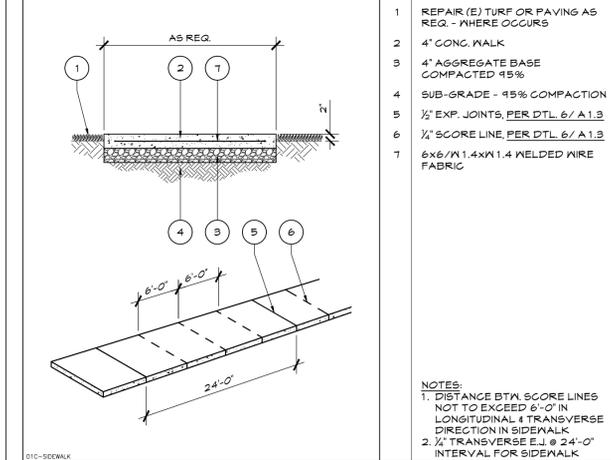

CONCRETE SIDEWALK SCALE: 1/2" = 1'-0" 5

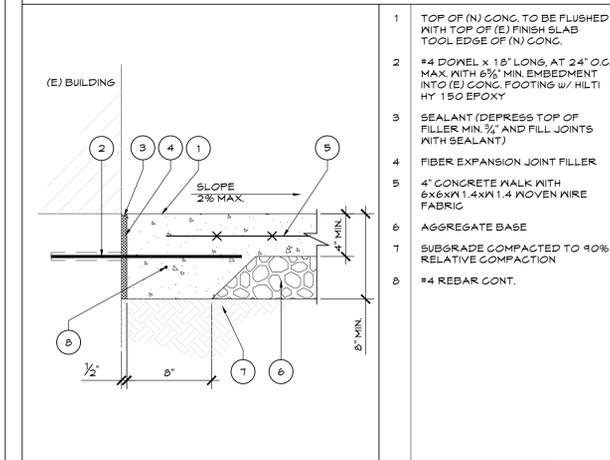

CONCRETE AT BUILDING SCALE: 1/2" = 1'-0" 1

©2023 Synthesis Partners, LLC. All Rights Reserved. These record drawings have been prepared based upon information submitted, in part, by others. While this information is believed to be reliable, the Architect is not responsible for their accuracy, nor for errors or omissions which may have been incorporated into these documents as a result.

APPROVALS

PO Box 1900
Yuba City, CA 95992-1900
530.298.7298
www.spinc-arch.com

ARCHITECTURAL • COMMERCIAL • RESIDENTIAL • INTERIOR • CONSTRUCTION MANAGEMENT

SYNTHESIS PARTNERS, LLC
Managers • Architects

OWNER

Woodland Joint Unified School District
435 6th Street
Woodland, CA 95695

PROJECT

CLASSROOM CONVERSIONS
at
WOODLAND EDUCATION CENTER
575 Hays Street
Woodland, CA 95695

KEY PLAN

NORTH

THIS IS A PRELIMINARY SET FOR REVIEW ONLY NOT FOR CONSTRUCTION

NO.	REVISION DESCRIPTION	DATE

SITE DETAILS

DATE 2023-03-01
PROJECT NO. 21-W04-01

A1.3

ROOM FINISH SCHEDULE																		
MARK	ROOM NAME	WALLS																
		FLOOR		BASE		NORTH		EAST		SOUTH		WEST		CEILING		NOMINAL CEILING HEIGHT	COUNTERTOPS	CASEWORK
		MAT'L	FIN.	MAT'L	FIN.													
F06	CULINARY CLASSROOM	F3	A4	B1	A4	*	A1	*	A1	*	A1	*	A1	*	A1	±9'-4"	P1	D1
F07	CULINARY CLASSROOM	F3	A4	B2	A4	*	A1	W2	A2	W2	A2	W2	A2	*	A1	±9'-4"	-	-
F08	DENTAL CLASSROOM	F2	A2	B1	A2	*	A1	*	A1	*	A1	*	A1	*	A1	±9'-4"	P1	D1
F09	MANUFACTURING LAB	F1	A3	B1	A2	*	A1	*	A1	*	A1	*	A1	*	A1	±9'-4"	-	-
F10	MANUFACTURING CLASSROOM	F2	A2	B1	A2	*	A1	*	A1	*	A1	*	A1	*	A1	±9'-4"	P1	D1
F18	DRY STORAGE	F3	A4	B1	A2	*	A1	*	A1	*	A1	*	A1	*	A1	±9'-4"	-	-

*INDICATES (E) TO REMAIN

ROOM FINISH CODES	
FLOOR	FINISHES
F1 (E) CONC.	A1 PRIME 4 PAINT
F2 MCT O/ (E) CONC.	A2 FACTORY FINISH
F3 EPOXY O/ (E) CONC.	A3 CLEAN 4 SEAL
	A4 NON-SLIP FINISH
WALLS	CEILING
W1 CLEAN EXISTING	C1 GYP. BD.
W2 FRP MAINSCOT	
COUNTERTOPS	BASE
P1 PLASTIC LAMINATE	B1 4" TOP SET RUBBER BASE
P2 STAINLESS STEEL	B2 6" EPOXY W/ MTL. COVE STRIP
CASEWORK	
D1 PLASTIC LAMINATE	

DOOR AND FRAME SCHEDULE															
MARK	LOCATION	DOOR					(E) FRAME					FIRE RATING LABEL	NOTES		
		SIZE			TYPE	MAT'L	GLAZING	LOUVER		TYPE	MAT'L			DETAIL	
		WD	HGT	THK				WD	HT.					HEAD	SILL
F18A	DRY STORAGE	3'-0"	7'-0"	1 3/4"	A	HM	-	--	--	A	PM	3/A9.1	-	--	--
F18B	DRY STORAGE	3'-0"	7'-0"	1 3/4"	A	HM	-	--	--	A	PM	3/A9.1	-	--	--


DOOR SCHEDULE CODES		
GLASS	MATERIAL	FINISH
CL CLEAR PLATE	HM HOLLOW METAL	PT PAINT, FACTORY PRIMED
CT CLEAR TEMPERED	PM PRESSED METAL	PF PREFINISHED
OS OBTURED	FM PRESSED METAL	PT PAINT
	SF STORE FRONT	

NOTE:
TEMPERED GLAZING TO MEET THE TESTING AND LABELING REQUIREMENTS OF 2019 CBC, 2406

DOOR HARDWARE SCHEDULE											
TAG	HINGE	LOCKSET	PANIC	CLOSER	STOP	WEATHERSTRIP	DOOR BOTTOM	THRESHOLD	FINISH	KICKPLATE	NOTES
F18A	1	2	-	-	2	-	-	-	1	1	-
F18B	1	2	-	-	2	-	-	-	1	1	-

DESCRIPTION	QUANTITY	MANUFACTURER / MODEL
HINGE	1	HAGER AB850
LOCKSET	1	SCHLAGE ND15FD
	2	SCHLAGE ND10S
KICK PLATE	1	ROCKWOOD K1050
CLOSER	1	LCN 4040XP W/ MTL. COVER
STOP	1	TRIMCO 128 1 FLOOR STOP
WEATHERSTRIP	1	PEMCO 3055SR
DOOR BOTTOM	1	PEMCO 211PK
THRESHOLD	1	PEMCO 2005T
FINISH	1	626/U526/MILL/AL

DOOR HARDWARE SCHEDULE NOTES:
1. DOOR PAIRS SHALL HAVE ONE INOPERABLE LEAF W/ ROCKWOOD 2845 FLUSH BOLT AND ONE OPERABLE LEAF W/ SCHEDULED LEVER LATCH HARDWARE. PROVIDE ROCKWOOD 2672 BAR COORDINATOR W/ 2601C MOUNTING BRACKETS.

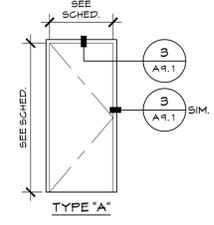

DOOR AND FRAME TYPE SCALE: 1/4" = 1'-0" 1

- FINISH NOTES**
- ANY FINISHES OR COLORS NOT INDICATED IN THE BID DOCUMENTS SHALL BE SUBMITTED FOR APPROVAL BY THE ARCHITECT PRIOR TO BIDDING.
 - INSTALL ALL FINISHES PER MANUFACTURER'S WRITTEN INSTRUCTIONS.
 - RESILIENT FLOORING SHALL HAVE A MIN COEFFICIENT OF FRICTION OF 0.5 PER ASTM D2047.
 - CARPETING SHALL BE DIRECT GLUE-DOWN LEVEL OR TEXTURED LOOP W/ PILE HEIGHT LESS THAN 1/2".
 - ALL TRANSITIONS BETWEEN FLOORING SHALL BE FLUSH OR LESS THAN 1/4" VERTICAL TRANSITION OR 1/2" MAXIMUM TRANSITION W/ 1:2 BEVEL.
 - CASEWORK FULL HARDWARE SHALL BE 4" U-SHAPED PULLS.
 - ALL INTERIOR WALL AND CEILING FINISHES SHALL BE CLASS 'A' MATERIALS PER ASTM E84 OR UL 723.
 - ALL CARPET SHALL BE DIRECT-GLUED AND BE CLASS I OR II PER NFPA 253 AND SHALL COMPLY WITH ASTM STANDARD E648 AND HAVE A SPECIFIC OPTICAL DENSITY SMOKE RATING NOT TO EXCEED 450 PER ASTM E662.

- DOOR HARDWARE NOTES**
- HARDWARE SHALL BE CENTERED BETWEEN 36" AND 44" A.F.F.
 - PRESSURE TO OPERATE DOORS SHALL NOT EXCEED 5.0 LBS.
 - IF THE DOOR HAS A CLOSER, THEN THE SNEEP PERIOD OF THE CLOSER SHALL BE ADJUSTED SO THAT FROM AN OPEN POSITION OF 90°, THE DOOR WILL TAKE AT LEAST 5 SECONDS TO MOVE TO A POINT 12" FROM THE LATCH, MEASURED TO THE LANDING EDGE OF THE DOOR.
 - FLOORS OR LANDINGS SHALL NOT BE MORE THAN 1/2" LOWER THAN THE THRESHOLD OF THE DOORWAY. CHANGE IN LEVEL BETWEEN 1/4" & 1/2" SHALL BE BEVELED W/ A SLOPE NO GREATER THAN 1 UNIT VERTICAL TO 2 UNITS HORIZONTAL. CHANGES IN LEVEL GREATER THAN 1/2" SHALL BE ACCOMPLISHED BY MEANS OF A RAMP.
 - ALL FLOOR STOPS SHALL NOT BE LOCATED IN THE P.O.T. & SHALL BE 4" MAX. FROM WALLS
 - KEY ALL LOCKS IN SCOPE TO OWNER'S REQUIREMENTS. CONTRACTOR TO COORDINATE W/ OWNER FOR KEYING REQUIREMENTS.
 - ALL EXTERIOR DOOR LANDINGS AT GRADE SHALL HAVE A SMOOTH TRANSITION TO ADJACENT PAVED SURFACE.
 - NO THUMB LATCHES OR KEYED CYLINDER DEAD BOLTS ALLOWED ON ANY DOORS UNLESS OPERATED BY A SINGLE ACTION W/ A LEVER FROM THE INSIDE OF THE AREA SERVED.
 - REGARDLESS OF THE OCCUPANT LOAD SERVED EXIT DOORS SHALL BE OPENABLE FROM THE INSIDE W/O THE USE OF A KEY OR ANY SPECIAL EFFORT.
 - MANUALLY-OPERATED EDGE OR SURFACE-MOUNTED FLUSH BOLTS & SURFACE BOLTS OR ANY TYPE OF DEVICE THAT MAY BE USED TO CLOSE OR RESTRAIN THE DOOR OTHER THEN THE OPERATION OF THE LOCKING DEVICE SHALL NOT BE USED & ARE PROHIBITED.
 - EXIT DOORS USED AS PAIRS W/ APPROVED AUTOMATIC FLUSH BOLTS SHALL NOT HAVE DOOR KNOBS OR SURFACE-MOUNTED HARDWARE ON THE INACTIVE LEAF.
 - POST A SIGN THAT READS, " THIS DOOR TO REMAIN UNLOCKED DURING BUSINESS HOURS." USE LETTERS 1-INCH HIGH ON A CONTRASTING BACKGROUND AT THE MAIN EXIT.
 - ALL COMPONENTS OF FIRE-RATED DOOR ASSEMBLIES SHALL BEAR THE LABEL OF AN APPROVED TESTING AGENCY, INCLUDING DOOR, FRAME, LATCH, & CLOSING DEVICES.
 - SUBMIT MANUFACTURER'S INSTALLATION INSTRUCTIONS FOR FIRE DOORS TO THE BUILDING INSPECTOR.
 - HAND-ACTIVATED DOOR OPENING HARDWARE, HANDLES, PULLS, LATCHES, LOCKS, AND OTHER OPERATING DEVICES ON ACCESSIBLE DOORS SHALL HAVE A SHAPE THAT IS EASY TO GRASP WITH ONE HAND AND DOES NOT REQUIRE TIGHT GRASPING, TIGHT PINCHING OR TWISTING OF THE WRIST TO OPERATE. LATCHING AND LOCKING DOORS THAT ARE HAND-ACTIVATED AND WHICH ARE IN A PATH OF TRAVEL SHALL BE OPERABLE WITH A SINGLE EFFORT BY LEVER-TYPE HARDWARE, PANIC BARS, PUSH-PULL ACTUATING BARS OR OTHER HARDWARE DESIGNED TO PROVIDE PASSAGE. LOCKED EXIT DOORS SHALL OPERATE AS ABOVE IN EGRESS DIRECTION.
 - ALL DOORS TO ROOMS OR SPACES WITH AN OCCUPANT LOAD OF 5 OR MORE SHALL BE EQUIPPED WITH HARDWARE THAT IS LOCKABLE FROM THE INSIDE PER CBC 1010.1.11 & AB 3205.

©2023 Synthesis Partners, LLC. All Rights Reserved
These record drawings have been prepared based upon information submitted, in part, by others. While this information is believed to be reliable, the Architect is not responsible for their accuracy, nor for errors or omissions which may have been incorporated into these documents as a result.


PO Box 1900
Yuba City, CA 95992-1900
530.298.7298
www.spinc-arch.com



SYNTHESIS PARTNERS, LLC
Managers • Architects

OWNER
Woodland Joint Unified School District
435 6th Street
Woodland, CA 95695

PROJECT
CLASSROOM CONVERSIONS
at
WOODLAND EDUCATION CENTER
575 Hays Street
Woodland, CA 95695

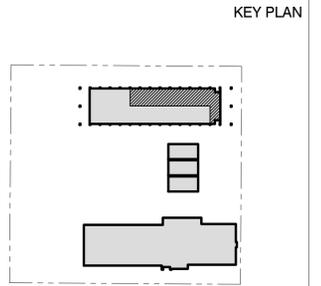


THIS IS A PRELIMINARY SET FOR REVIEW ONLY NOT FOR CONSTRUCTION

NO.	REVISION DESCRIPTION	DATE

SCHEDULES


DATE 2023-03-01
PROJECT NO. 21-W04-01

A2.0

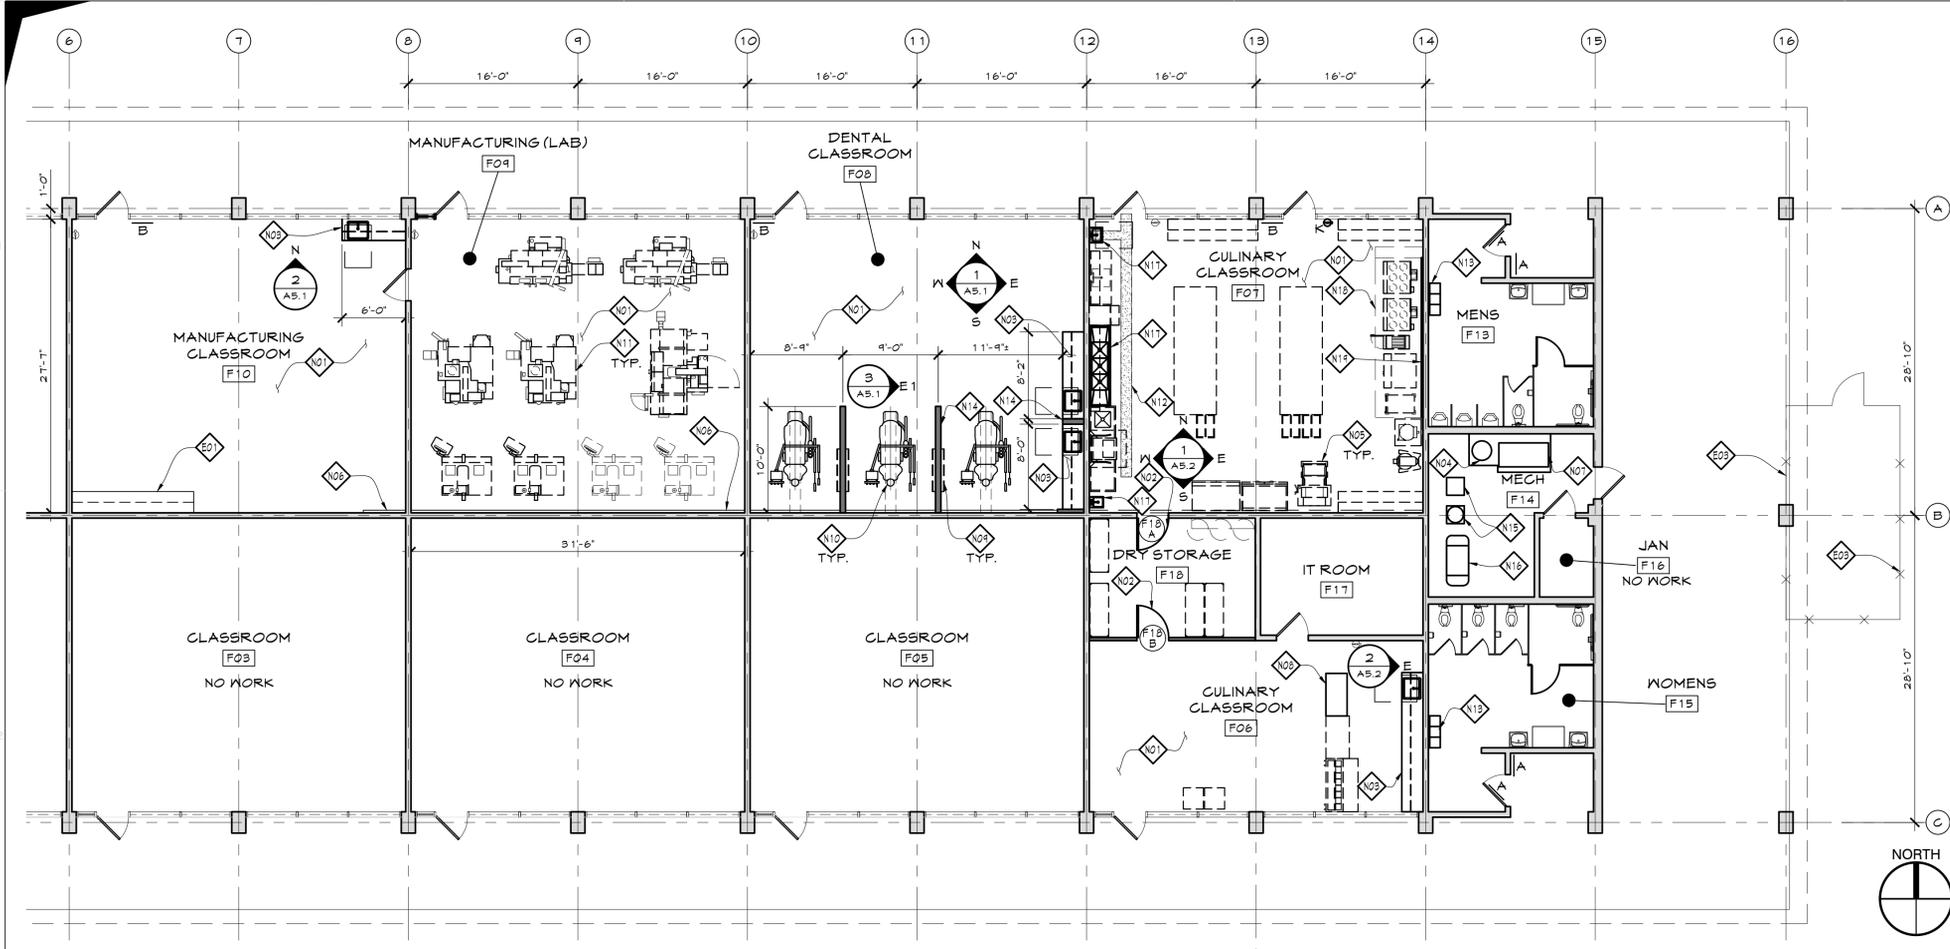

FLOOR PLAN - ALTERATION

SCALE: 1/8" = 1'-0" 2

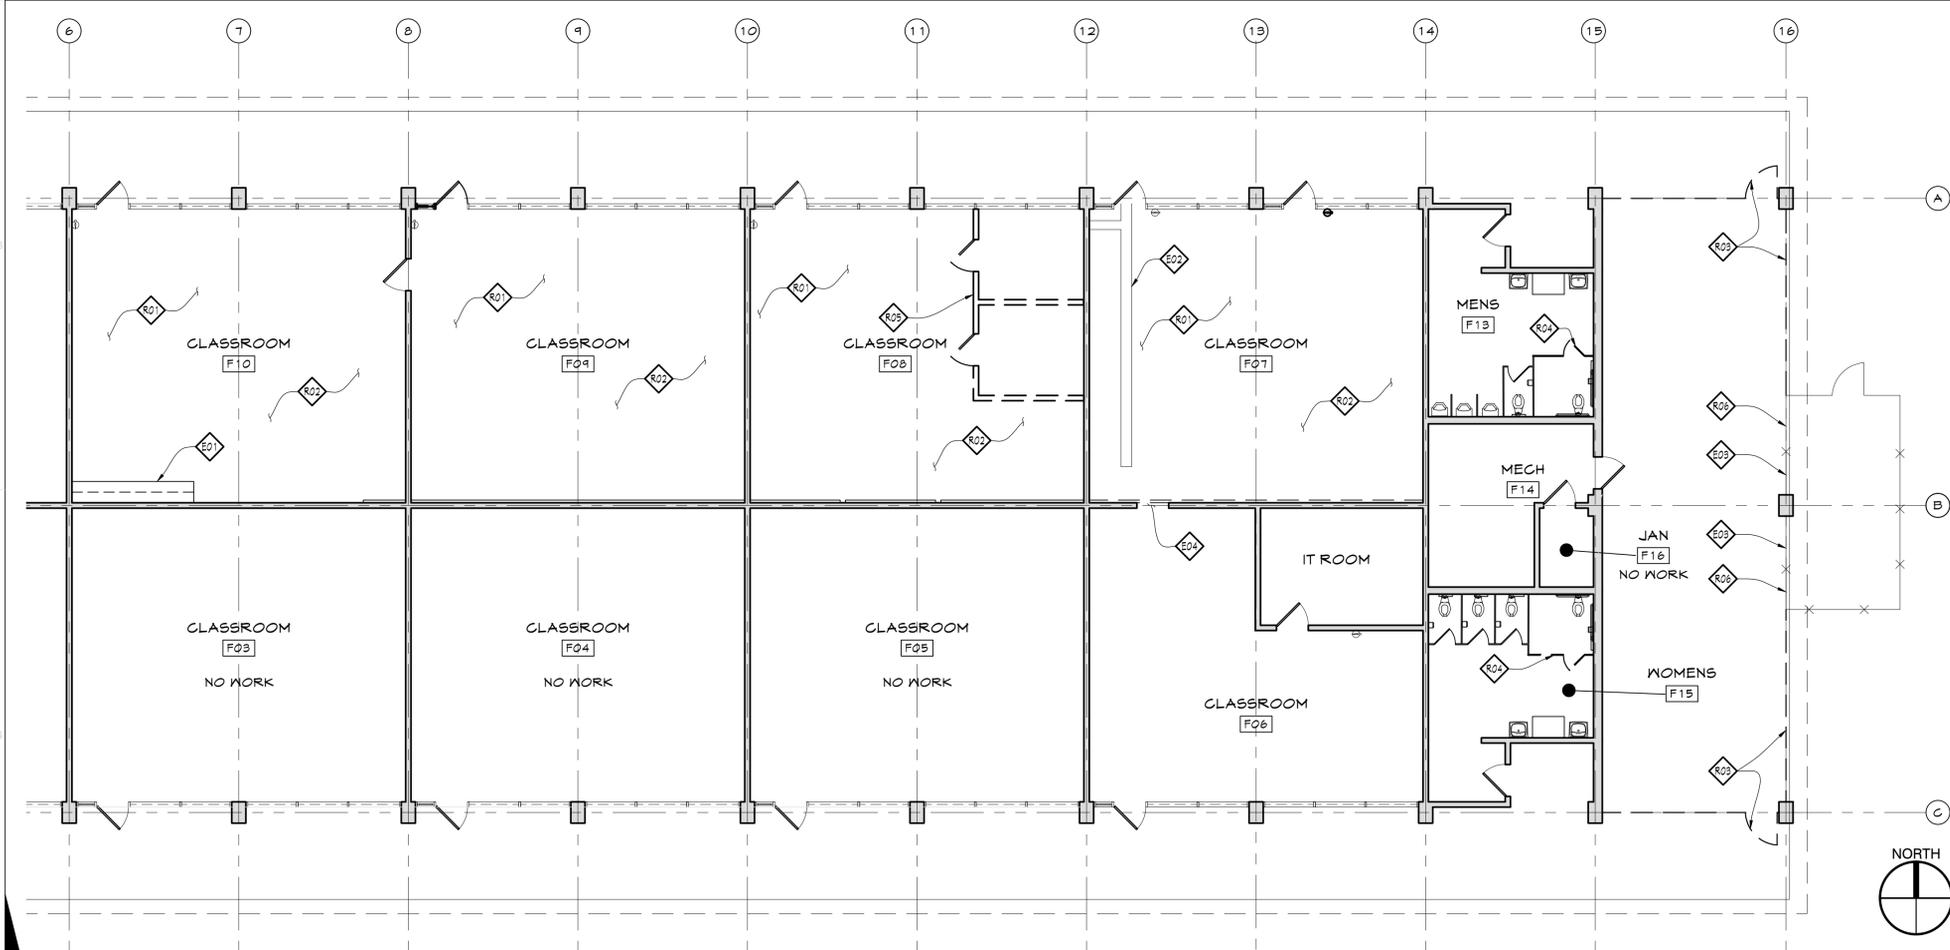

FLOOR PLAN - DEMOLITION

SCALE: 1/8" = 1'-0" 1

KEYNOTES

- EXISTING**
 - E01 CASEWORK TO REMAIN
 - E02 OPEN SLAB FOR FUTURE WORK
 - E03 CHAIN LINK FENCE TO REMAIN
 - E04 WALL OPENING FOR (N) DOOR
- REMOVAL / DEMOLITION**
 - R01 WALL BASE, TYP.
 - R02 FLOORING & ADHESIVE WILL BE REMOVED BY OWNER PRIOR TO CONSTRUCTION
 - R03 CHAIN LINK FENCE & GATE
 - R04 TOILET PARTITION & DOOR
 - R05 INTERIOR WALLS
 - R06 HOG PANEL PANELS ON (E) FENCE
 - R07 CASEWORK & RELOCATE SINK
- NEW / ALTERATION**
 - N01 FLOORING - SEE SHT. A2.0 - ROOM FINISH SCHEDULE
 - N02 DOOR
 - N03 CASEWORK - SEE INTERIOR ELEVATION
 - N04 WATER HEATER - SEE PLUMB. DWG.
 - N05 CULINARY EQUIPMENT, OFOI - SEE EQPT. PLAN SHT. A2.3
 - N06 UTILITY CHASE - SEE DTL. 2/A9.1
 - N07 MANUFACTURING AIR COMPRESSOR, OFCI - SEE EQPT. PLAN SHT. A2.3
 - N08 ISLAND COUNTER
 - N09 X-RAY HOUSING CABINET, OFOI - SEE EQPT. PLAN SHT. A2.3
 - N10 DENTAL CHAIR, OFOI - SEE EQPT. PLAN SHT. A2.3
 - N11 MANUFACTURING EQUIPMENT, OFOI - SEE EQPT. PLAN SHT. A2.3
 - N12 PATCH CONG. - SEE DTL. 13/A9.1
 - N13 (3) 1/3 HEIGHT LOCKERS - SEE DTL. 10/A9.1
 - N14 2X6 WALL W/ 3/8" GYP. BD. BOTH SIDES - SEE DTL. 6/A9.1
 - N15 DENTAL VACUUM SYSTEM, OFCI - SEE EQPT. PLAN SHT. A2.3
 - N16 DENTAL AIR COMPRESSOR, OFCI - SEE EQPT. PLAN SHT. A2.3
 - N17 CULINARY EQPT. SINK, OFCI - SEE EQPT. PLAN SHT. A2.3
 - N18 EXHAUST HOOD, OFCI - SEE EQPT. PLAN SHT. A2.3
 - N19 5/5 LINER PANEL, OFCI - SEE EQPT. PLAN SHT. A2.3

SIGNAGE LEGEND

- A RESTROOM SIGN - SEE DTL. 7/A9.1
- B ALS SIGN - SEE DTL. 4/A9.1

FIRE EXTINGUISHER LEGEND

- (E) 2A:10BC:G FIRE EXTINGUISHER
- (N) TYPE K FIRE EXTINGUISHER

LEGEND

- (E) DOOR
- (N) DOOR, FRAME & HARDWARE
- 30'x48" CLR. FLR. SPACE
- 60'x56" CLR. FLR. SPACE

©2023 Synthesis Partners, LLC. All Rights Reserved.
 These record drawings have been prepared based upon information submitted, in part, by others. While this information is believed to be reliable, the Architect is not responsible for their accuracy, nor for errors or omissions which may have been incorporated into these documents as a result.

APPROVALS

PO Box 1900
 Yuba City, CA 95992-1900
 530.298.7298
 www.spinc-arch.com

ARCHITECTURAL • COMMERCIAL • RESIDENTIAL • INTERIOR • CONSTRUCTION MANAGEMENT




OWNER

Woodland Joint Unified School District
 435 6th Street
 Woodland, CA 95695

PROJECT

CLASSROOM CONVERSIONS
 at
 WOODLAND EDUCATION CENTER
 575 Hays Street
 Woodland, CA 95695

KEY PLAN

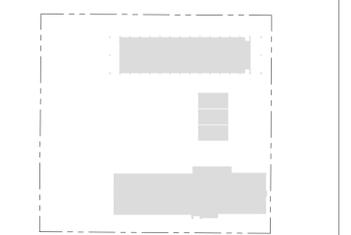

THIS IS A PRELIMINARY SET FOR REVIEW
 ONLY NOT FOR CONSTRUCTION




NO.	REVISION DESCRIPTION	DATE

FLOOR PLANS


DATE 2023-03-01
 PROJECT NO. 21-W04-01

A2.1

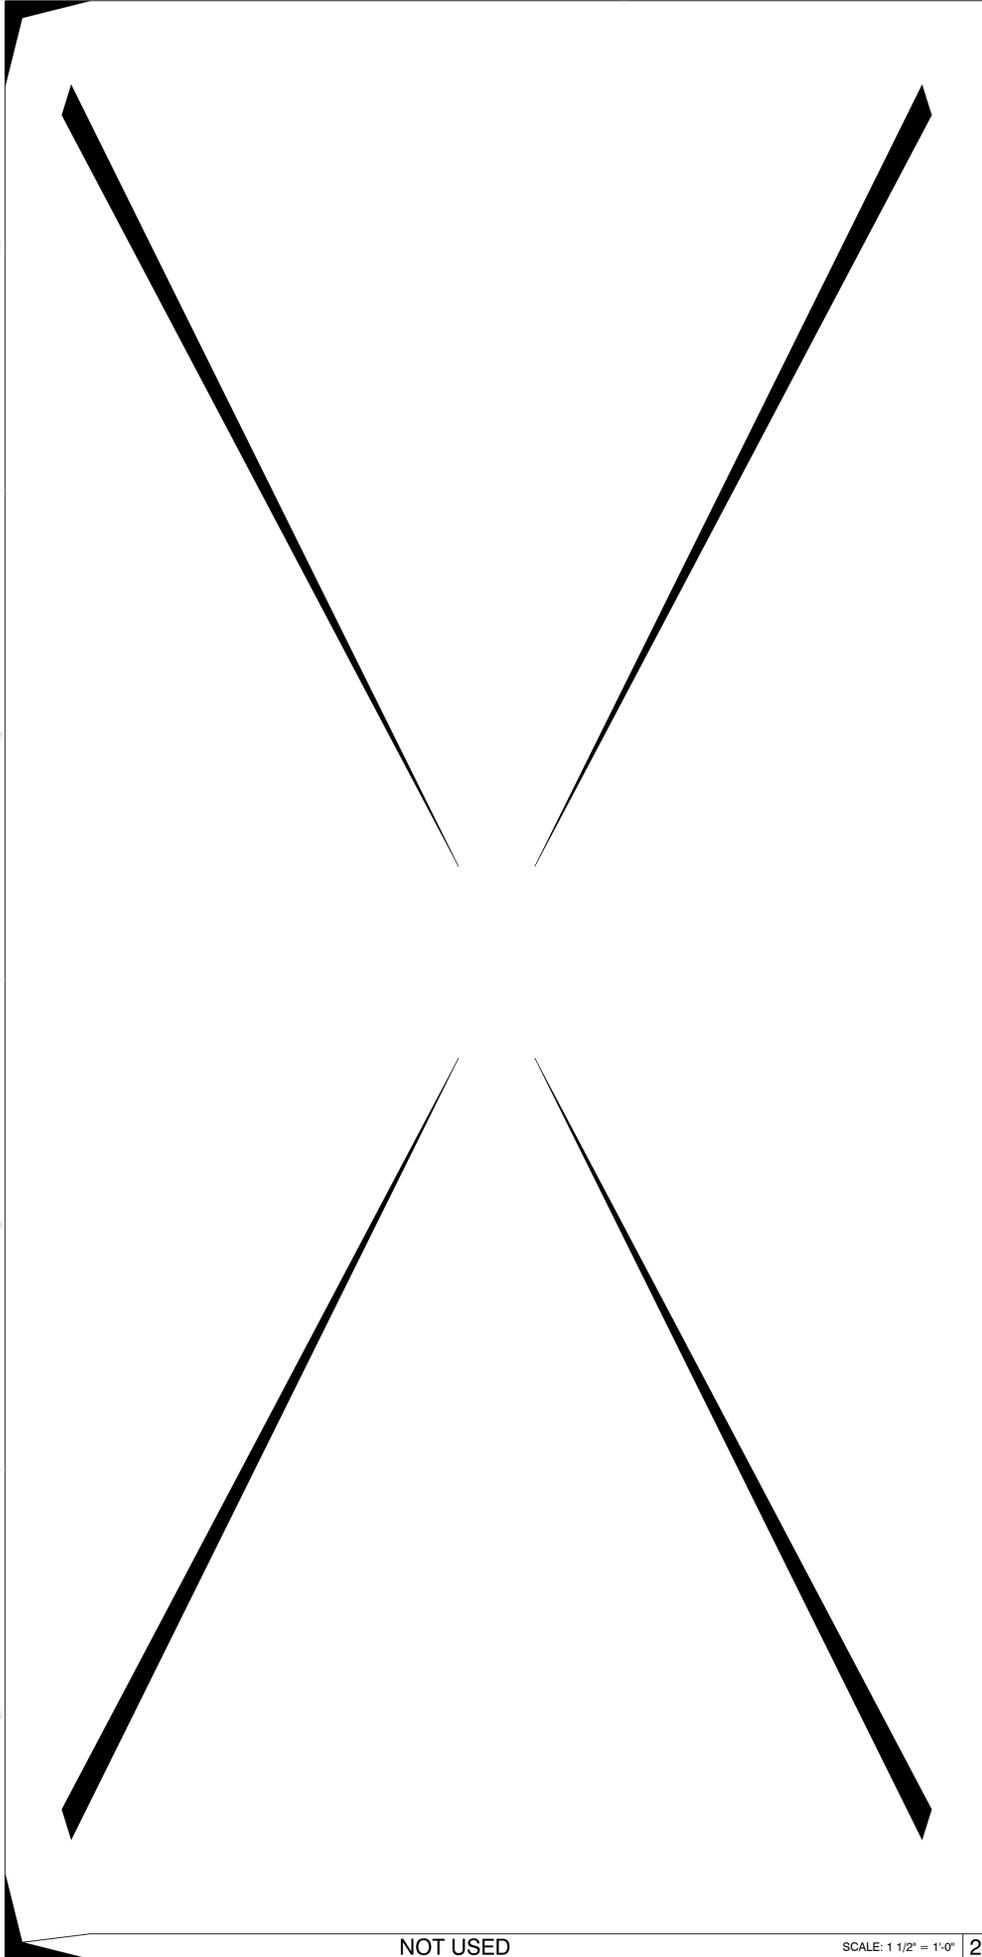

NOT USED

SCALE: 1 1/2" = 1'-0" 2

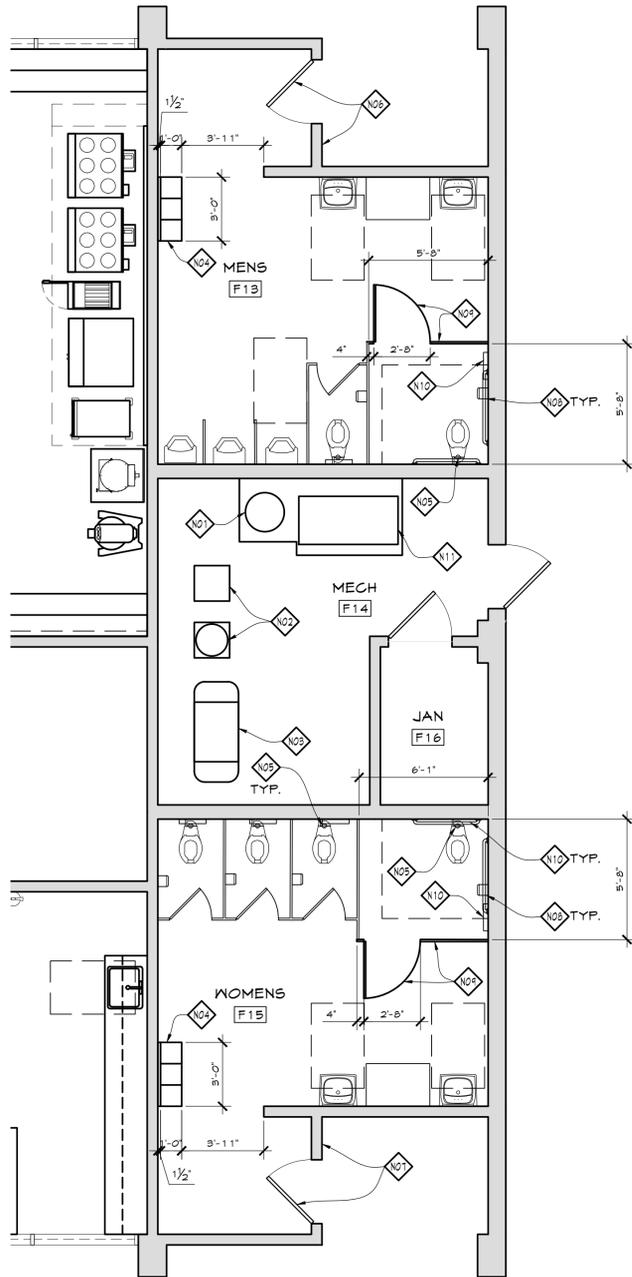

ENLARGED MENS, MECH, JAN & WOMENS FLOOR PLAN

SCALE: 1/4" = 1'-0" 1



KEYNOTES

- ◆ NEW / ALTERATION
- NO1 WATER HEATER - SEE PLUMB. DWGS.
- NO2 DENTAL VACUUM SYSTEM, OFCI
- NO3 DENTAL AIR COMPRESSOR, OFCI
- NO4 (3) 1/3 HEIGHT LOCKERS - SEE DTL. 10/A9.1
- NO5 REPLACE TH FLUSH VALVE w/ AN AUTOMATIC FLUSH VALVE - SEE PLUMBING DWGS.
- NO6 INSTALL MENS RESTROOM SIGNS - SEE DTL. 8/A9.1
- NO7 INSTALL WOMENS RESTROOM SIGNS - SEE DTL. 7/A9.1
- NO8 REMOVE/ REINSTALL THE TOILET PAPER DISPENSER - SEE DTL. 9/A9.1
- NO9 TOILET PARTITION 4 3/2" WIDE MIN. DOOR TO MATCH (E)
- NO10 REMOVE/ REINSTALL THE SEAT COVER DISPENSER - SEE DTL. 9/A9.1
- NO11 MANUFACTURING AIR COMPRESSOR, OFCI

LEGEND

- (E) DOOR
- (N) DOOR, FRAME & HARDWARE
- 30'x48" CLR. FLR. SPACE
- 60'x56" CLR. FLR. SPACE

©2023 Synthesis Partners, LLC. All Rights Reserved.
 These record drawings have been prepared based upon information submitted, in part, by others. While this information is believed to be reliable, The Architect is not responsible for their accuracy, nor for errors or omissions which may have been incorporated into these documents as a result.

APPROVALS

PO Box 1900
 Yuba City, CA 95992-1900
 530.298.7298
 www.spinc-arch.com




OWNER

Woodland Joint Unified School District
 435 6th Street
 Woodland, CA 95695

PROJECT

CLASSROOM CONVERSIONS
 at
 WOODLAND EDUCATION CENTER
 575 Hays Street
 Woodland, CA 95695

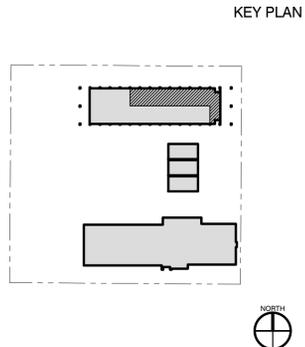


THIS IS A PRELIMINARY SET FOR REVIEW ONLY NOT FOR CONSTRUCTION

NO.	REVISION DESCRIPTION	DATE

ENLARGED FLOOR PLAN

DATE 2023-03-01
 PROJECT NO. 21-W04-01

A2.2

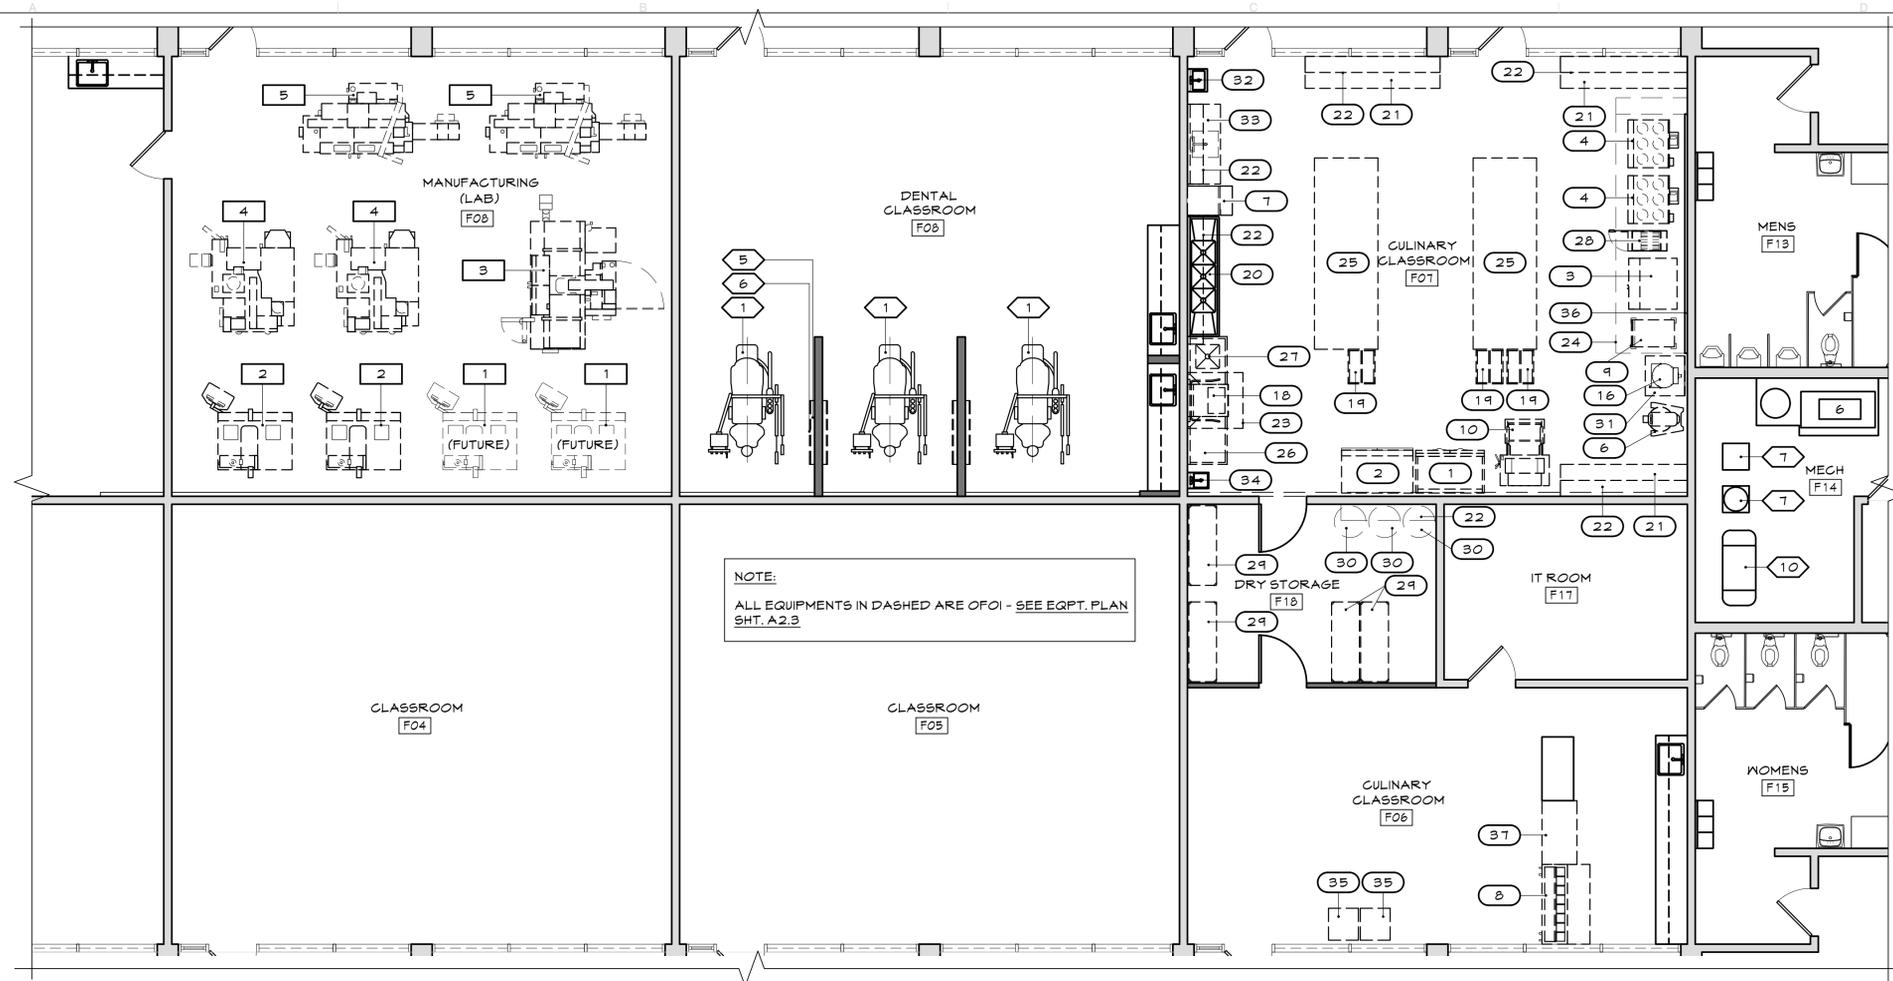

CULINARY EQUIPMENT SCHEDULE

ITEM NUMBER	QTY.	ITEM DESCRIPTION	MANUFACTURER	NOTES
1	1	2-DOOR REFRIGERATOR	BEVERAGE AIR	
2	1	2-DOOR FREEZER	ENTREE	
3	1	OVEN	DOYON	
4	2	RANGE	IMPERIAL	
5	1	MEAT SLICER	BIZERBA	COUNTERTOP ITEM
6	1	PLANETARY MIXER	GLOBE	
7	1	ICE MACHINE	MANITOWOC	
8	1	PREP TABLE	BEVERAGE AIR	
9	1	PROOFING CABINET	SERVE-WARE	
10	1	DOUGH SHEETER	AMPTO	
11	1	PLANETARY MIXER	GLOBE	COUNTERTOP ITEM
12	1	PLANETARY MIXER	SERV-WARE	COUNTERTOP ITEM
13	4	INDUCTION TABLE TOP STOVE BURNER	VOLLRATH	COUNTERTOP ITEM
14	1	FOOD PROCESSOR	ROBOT COUPE	COUNTERTOP ITEM
15	1	MICROWAVE OVEN	AMANA	COUNTERTOP ITEM
16	1	PIZZA OVEN	TURBOCHEF	
17	1	TOASTER	WARING	COUNTERTOP ITEM
18	1	DISHWASHER	JACKSON MWS	
19	3	SHEET PAN RACK	WINHOLT EQUIPMENT	
20	1	3-COMPARTMENT SINK	GSN USA	LENGTH VARIES
21	3	S/S WORKTABLE W/ UNDERSHELF	CUSTOM	LENGTH VARIES
22	8	12" S/S UPPER SHELF	CUSTOM	LENGTH VARIES
23	1	CONDENSATE HOOD	CAPTIVE-AIRE	
24	1	42"X180" EXHAUST HOOD	CAPTIVE-AIRE	INCL. ANSUL FIRE SUPPRESSION SYSTEM
25	2	48"X144" S/S WORK TABLE W/ UNDERSHELF	CUSTOM	
26	1	DISHWASHER SIDE TABLE	CUSTOM	
27	1	DISHWASHER SIDE TABLE	CUSTOM	
28	1	FRYER	VULCAN	
29	5	WIRE SHELVING	CALIFORNIA COOKING	LENGTH VARIES
30	3	INGREDIENT BIN	RUBBERMAID	
31	1	30"X30" S/S WORK TABLE	-	
32	1	HANDWASHING SINK 1	-	
33	1	60" S/S COUNTER W/ 20"X20" FOOD PREP SINK	-	

CULINARY EQUIPMENT SCHEDULE

ITEM NUMBER	QTY.	ITEM DESCRIPTION	MANUFACTURER	NOTES
34	1	HANDWASHING SINK 2	-	
35	2	REFRIGERATOR - BEVERAGE COOLER	PREMIUM	
36	1	S/S LINER PANEL	-	
37	1	48" CURVED GLASS BAKERY DISPLAY CASE	AVANTGO	

DENTAL EQUIPMENT SCHEDULE

ITEM NUMBER	QTY.	ITEM DESCRIPTION	MANUFACTURER	NOTES
1	3	CHAIR	ADS DENTAL	
2	3	LIGHTS	ADS DENTAL	PART OF NO. 1 ITEM
3	1	COCOON	-	COUNTERTOP ITEM
4	1	CAMERA	-	COUNTERTOP ITEM
5	2	XRAY	MIDMARK	
6	2	XRAY PASS THROUGH CABINET	DGI INTERNATIONAL	
7	1	VACUUM	TRU-VAC	
8	-	-	-	
9	2	AUTOCLAVE	TUTTNAUER	COUNTERTOP ITEM
10	1	AIR COMPRESSOR	ATLAS COPCO AIR COMPRESSOR	
11	1	ULTRASONIC CLEANER	MIDMARK	COUNTERTOP ITEM

MANUFACTURING LAB EQUIPMENT SCHEDULE

ITEM NUMBER	QTY.	ITEM DESCRIPTION	MANUFACTURER	NOTES
1	2	ROUTER MILL	TORMACH	(2) FUTURE
2	2	ROUTER MILL	TORMACH	
3	1	TOOL ROOM CNC MILL	HAAS	
4	2	CNN MILL	HAAS	
5	2	CNC LATHE	HAAS	
6	1	AIR COMPRESSOR	ATLAS COPCO AIR COMPRESSOR	

MEP COMPONENT ANCHORAGE NOTE

ALL MECHANICAL, PLUMBING, AND ELECTRICAL COMPONENTS SHALL BE ANCHORED AND INSTALLED PER THE DETAILS ON THE DSA-APPROVED CONSTRUCTION DOCUMENTS. THE FOLLOWING COMPONENTS SHALL BE ANCHORED OR BRACED TO MEET THE FORCE AND DISPLACEMENT REQUIREMENTS PRESCRIBED IN THE 2019 CBC SECTIONS 1617A.1.18 THROUGH 1617A.1.26 AND ASCE 7-16 CHAPTERS 13, 26, AND 30:

- ALL PERMANENT EQUIPMENT AND COMPONENTS.
- TEMPORARY, MOVABLE OR MOBILE EQUIPMENT THAT IS PERMANENTLY ATTACHED (E.G., HARD WIRED) TO THE BUILDING UTILITY SERVICES SUCH AS ELECTRICITY, GAS OR WATER. PERMANENTLY ATTACHED SHALL INCLUDE ALL ELECTRICAL CONNECTIONS EXCEPT PLUGS FOR 110/220 VOLT RECEPTACLES HAVING A FLEXIBLE CABLE.
- TEMPORARY, MOVABLE OR MOBILE EQUIPMENT WHICH IS HEAVIER THAN 400 POUNDS OR HAS A CENTER OF MASS LOCATED 4 FEET OR MORE ABOVE THE ADJACENT FLOOR OR ROOF LEVEL THAT DIRECTLY SUPPORT THE COMPONENT IS REQUIRED TO BE RESTRAINED IN A MANNER APPROVED BY DSA.

THE FOLLOWING MECHANICAL AND ELECTRICAL COMPONENTS SHALL BE POSITIVELY ATTACHED TO THE STRUCTURE BUT NEED NOT DEMONSTRATE DESIGN COMPLIANCE WITH THE REFERENCES NOTED ABOVE. THESE COMPONENTS SHALL HAVE FLEXIBLE CONNECTIONS PROVIDED BETWEEN THE COMPONENT AND ASSOCIATED DUCTWORK, PIPING, AND CONDUIT. FLEXIBLE CONNECTIONS MUST ALLOW MOVEMENT IN BOTH TRANSVERSE AND LONGITUDINAL DIRECTIONS:

A. COMPONENTS WEIGHING LESS THAN 400 POUNDS AND HAVING A CENTER OF MASS LOCATED 4 FEET OR LESS ABOVE THE ADJACENT FLOOR OR ROOF LEVEL THAT DIRECTLY SUPPORT THE COMPONENTS. COMPONENTS WEIGHING LESS THAN 20 POUNDS, OR IN THE CASE OF DISTRIBUTED SYSTEMS, LESS THAN 5 POUNDS PER FOOT, WHICH ARE SUSPENDED FROM A ROOF OR FLOOR OR HUNG FROM A WALL.

THE ANCHORAGE OF ALL MECHANICAL, ELECTRICAL AND PLUMBING COMPONENTS SHALL BE SUBJECT TO THE APPROVAL OF THE DESIGN PROFESSIONAL IN GENERAL RESPONSIBLE CHARGE OR STRUCTURAL ENGINEER DELEGATED RESPONSIBILITY AND ACCEPTANCE BY DSA. THE PROJECT INSPECTOR WILL VERIFY THAT ALL COMPONENTS AND EQUIPMENT HAVE BEEN ANCHORED IN ACCORDANCE WITH THE ABOVE REQUIREMENTS.

©2023 Synthesis Partners, LLC. All Rights Reserved. These record drawings have been prepared based upon information submitted, in part, by others. While this information is believed to be reliable, the Architect is not responsible for their accuracy, nor for errors or omissions which may have been incorporated into these documents as a result.

PO Box 1900
Yuba City, CA 95992-1900
530.298.7298
www.spinc-arch.com



SYNTHESIS PARTNERS, LLC
Managers • Architects

APPROVALS


OWNER

Woodland Joint Unified School District
435 6th Street
Woodland, CA 95695

PROJECT

CLASSROOM CONVERSIONS
at
WOODLAND EDUCATION CENTER
575 Hays Street
Woodland, CA 95695

KEY PLAN

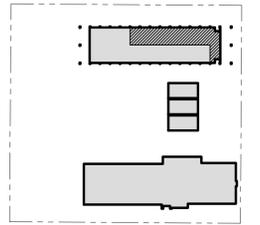

THIS IS A PRELIMINARY SET FOR REVIEW ONLY NOT FOR CONSTRUCTION

NO.	REVISION DESCRIPTION	DATE


EQUIPMENT SCHEDULES

A2.3

EQUIPMENT PLAN

SCALE: ##### 1

DATE: 2023-03-01
PROJECT NO.: 21-W04-01

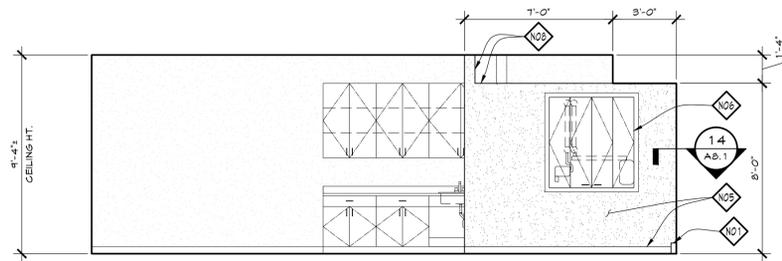

EAST 1

PROVIDE LOCKS ON ALL CABINETS

KEYNOTES

EXISTING


- E01 WINDOW
- E02 DOOR

NEW / ALTERATION

- N01 UTILITY CHASE - SEE DTL. 2/A9.1
- N02 2x6 WALL W/ 3/8" GYP. BD. BOTH SIDES - SEE DTL. 6/A9.1
- N03 DENTAL CHAIR, OFOI - SEE EQPT. PLAN SHT. A2.3
- N04 CASEWORK
- N05 WALL PAINT & BASE - SEE SHT. A2.0 - ROOM FINISH SCHEDULE
- N06 X-RAY HOUSING CABINET, OFOI - SEE EQPT. PLAN SHT. A2.3
- N07 FIRE EXTINGUISHER
- N08 2x6 WALL W/ 3/8" GYP. BD. BOTH SIDES - SEE DTL. 6/A9.1

ROOM F08 - DENTAL CLASSROOM

SCALE: 1/4" = 1'-0" 3

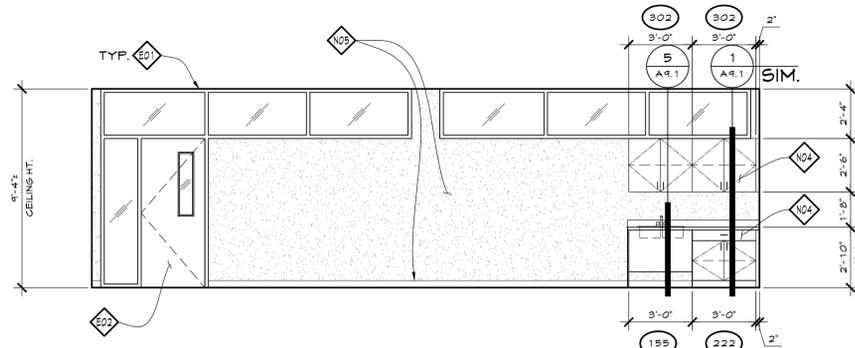


NORTH


PROVIDE LOCKS ON ALL CABINETS

ROOM F10 - MANUFACTURING CLASSROOM

SCALE: 1/4" = 1'-0" 2

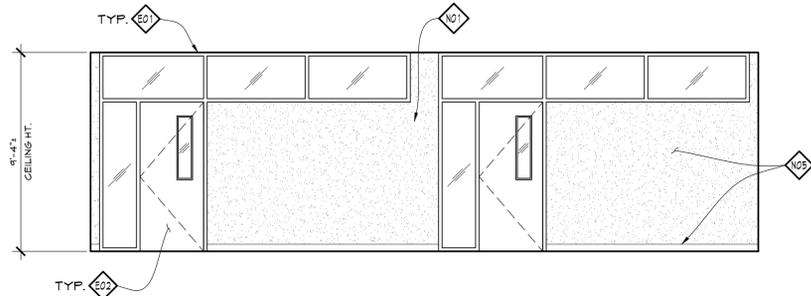


NORTH

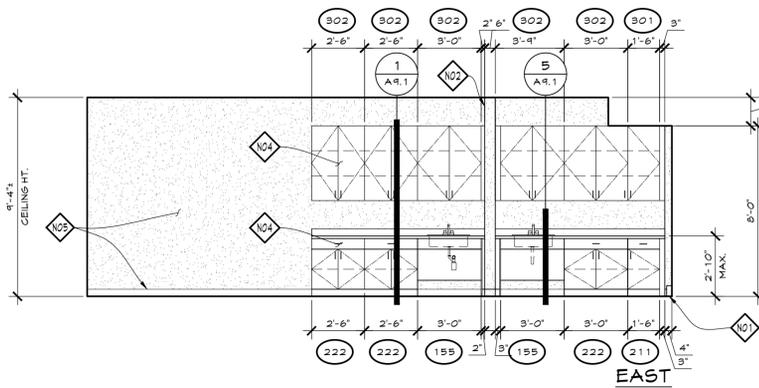


EAST

PROVIDE LOCKS ON ALL CABINETS

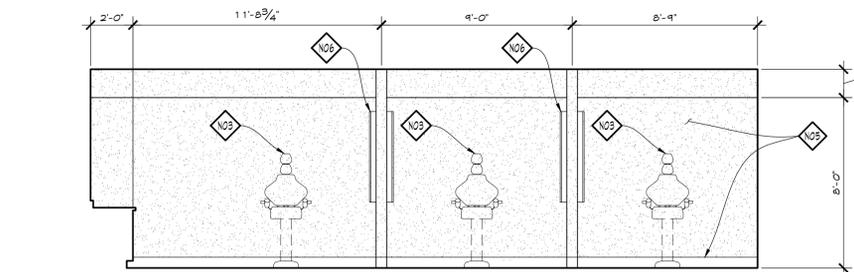

SOUTH

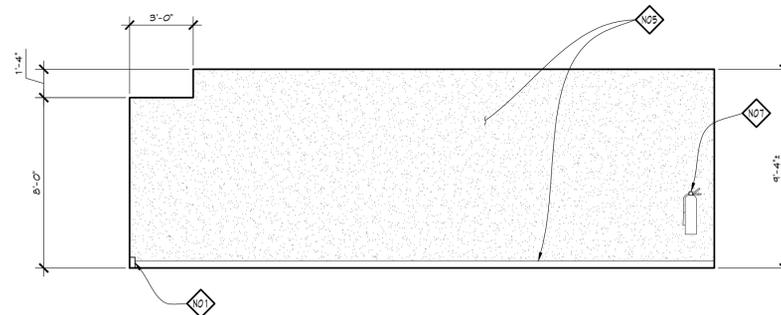

WEST

ROOM F08 - DENTAL CLASSROOM

SCALE: 1/4" = 1'-0" 1

©2023 Synthesis Partners, LLC. All Rights Reserved. These record drawings have been prepared based upon information submitted, in part, by others. While this information is believed to be reliable, the Architect is not responsible for their accuracy, nor for errors or omissions which may have been incorporated into these documents as a result.

PO Box 1900
Yuba City, CA 95992-1900
530.298.7298
www.spinc-arch.com

ARCHITECTURAL • COMMERCIAL • RESIDENTIAL • INTERIORS • CONSTRUCTION MANAGEMENT



SYNTHESIS PARTNERS, LLC
Managers • Architects

APPROVALS


OWNER

Woodland Joint Unified School District
435 6th Street
Woodland, CA 95695

PROJECT

CLASSROOM CONVERSIONS
at
WOODLAND EDUCATION CENTER
575 Hays Street
Woodland, CA 95695

KEY PLAN

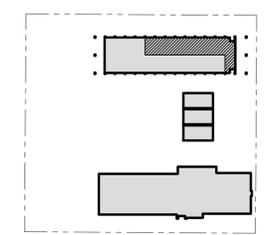

THIS IS A PRELIMINARY SET FOR REVIEW ONLY NOT FOR CONSTRUCTION




NO.	REVISION DESCRIPTION	DATE


INTERIOR ELEVATIONS

A5.1


DATE 2023-03-01
PROJECT NO. 21-W04-01

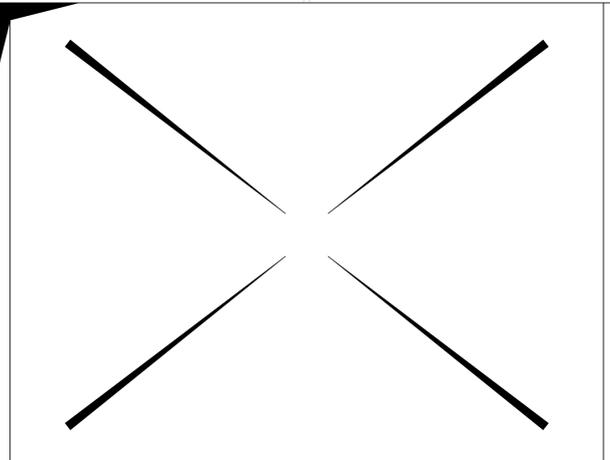


NOT USED SCALE: NONE 15

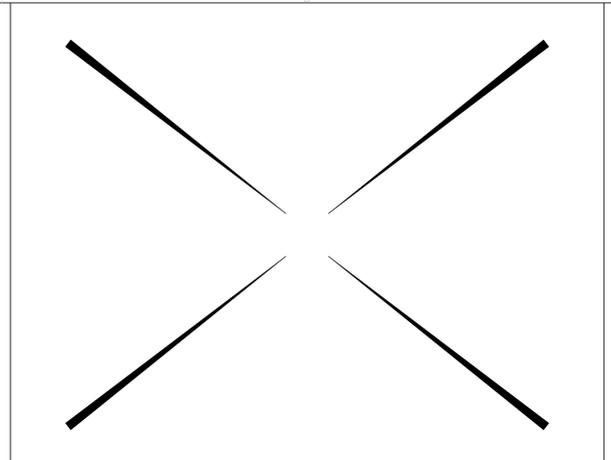


NOT USED SCALE: NONE 12

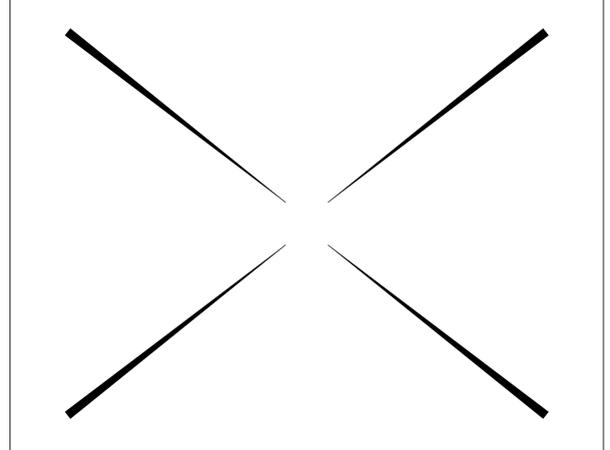


NOT USED SCALE: NONE 14

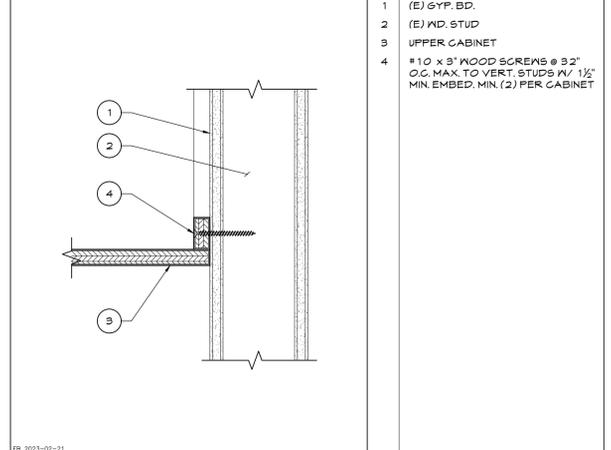


UPPER CABINET CONNECTION SCALE: 3\"/>

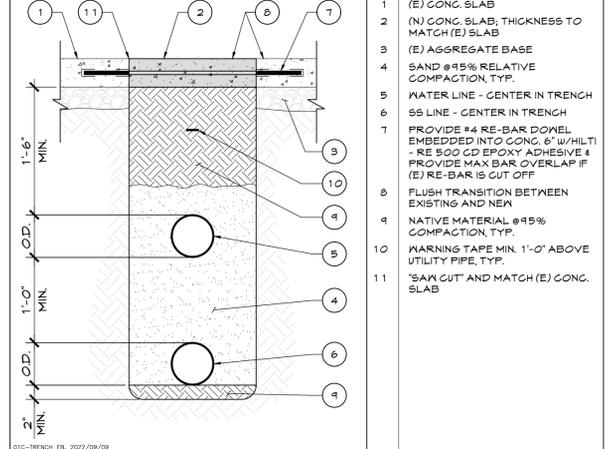


TYP. TRENCH INFILL SCALE: 1\"/>

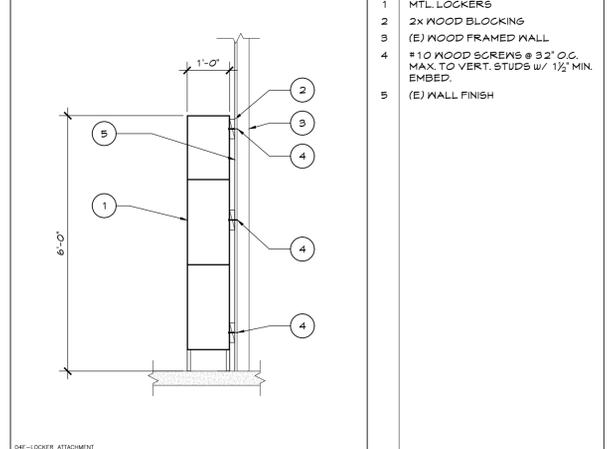


LOCKER ANCHORAGE SCALE: 1/2\"/>

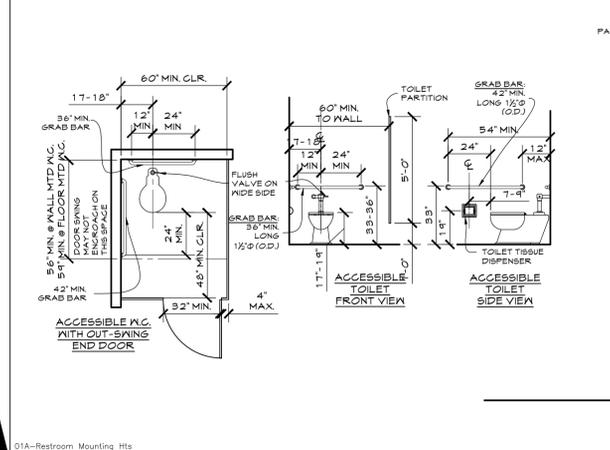


ACCESSIBLE MOUNTING HEIGHTS SCALE: 1/4\"/>

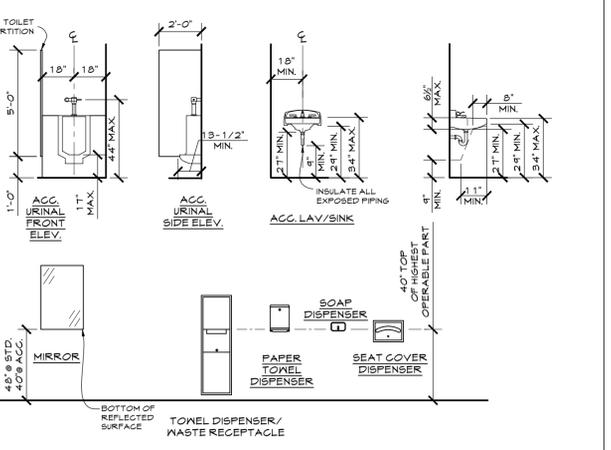


ACCESSIBLE COUNTER @ SINK SCALE: 1\"/>

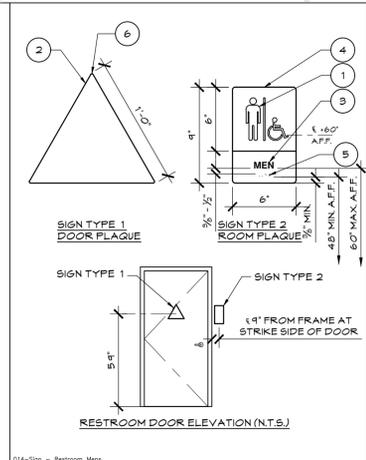

MENS ACCESSIBLE RESTROOM SIGN SCALE: 1 1/2\"/>

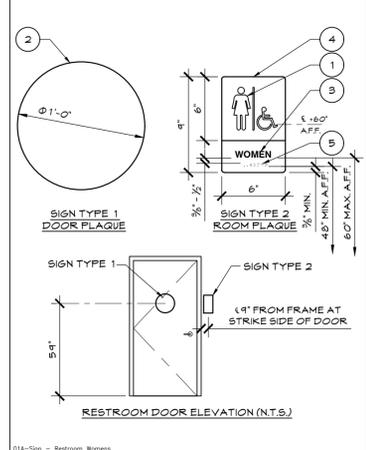


WOMENS ACCESSIBLE RESTROOM SIGN SCALE: 1 1/2\"/>

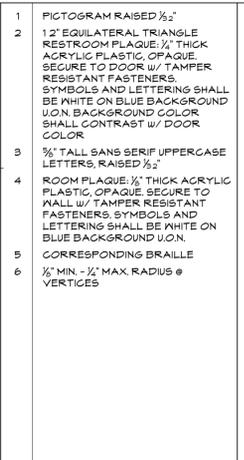


ASSISTIVE LISTENING SYSTEM SIGN SCALE: 3\"/>




PRESSED METAL DOOR HEAD & JAMB SCALE: 3\"/>

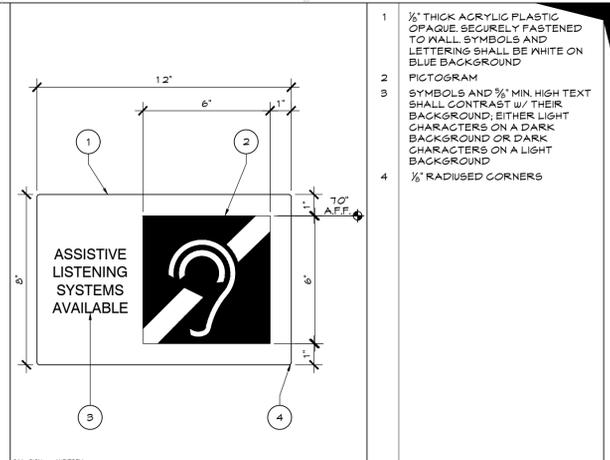

WOOD STUD WALL w/ POST SCALE: 1\"/>

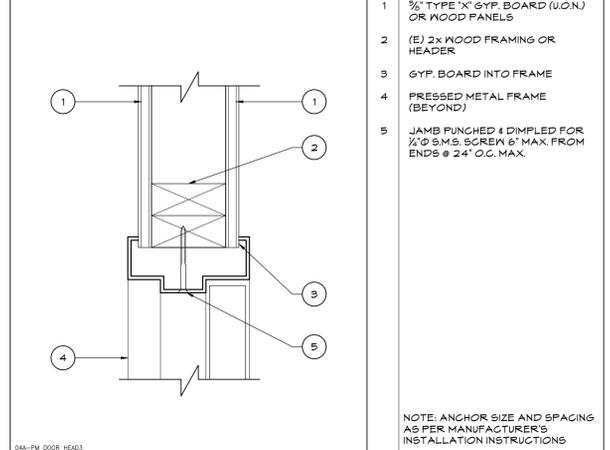

COUNTER & CABINET SECTION SCALE: 1/2\"/>

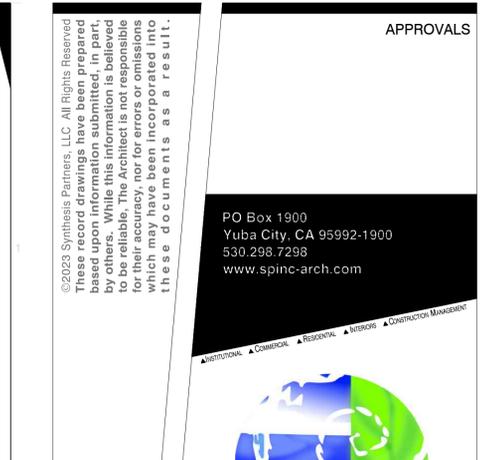

APPROVALS

©2023 Synthesis Partners, LLC. All Rights Reserved. These record drawings have been prepared based upon information submitted, in part, by others. While this information is believed to be reliable, the Architect is not responsible for their accuracy, nor for errors or omissions which may have been incorporated into these documents as a result.


PO Box 1900
Yuba City, CA 95992-1900
530.298.7298
www.spinc-arch.com

SYNTHESIS PARTNERS, LLC
Managers • Architects

OWNER
Woodland Joint Unified School District
435 6th Street
Woodland, CA 95695

PROJECT
CLASSROOM CONVERSIONS
at
WOODLAND EDUCATION CENTER
575 Hays Street
Woodland, CA 95695

KEY PLAN

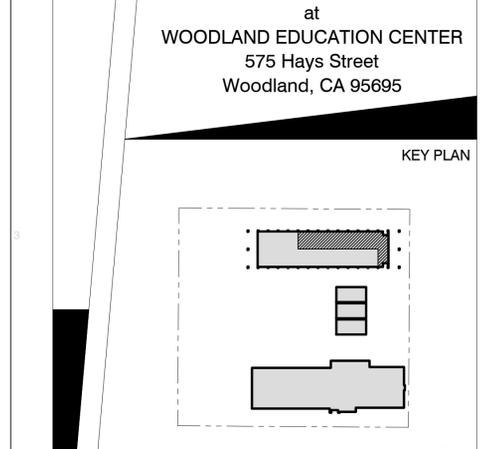

KEY PLAN

THIS IS A PRELIMINARY SET FOR REVIEW ONLY NOT FOR CONSTRUCTION

ARCHITECT
MICHAEL UNTER
7-311-22
6-19752
STATE OF CALIFORNIA

NO.	REVISION DESCRIPTION	DATE

INTERIOR DETAILS

A9.1

DATE: 2023-03-01
PROJECT NO.: 21-W04-01

INTERIOR DETAILS

GENERAL NOTES

DESIGN CRITERIA

1. CODE: 2022 CALIFORNIA BUILDING CODE (CBC)

2. DESIGN LIVE LOADS:

AREA	LIVE LOAD	REMARKS
ROOF		
A) FLAT TO < 4:12	Lr = 20 PSF	REDUCIBLE PER CODE
B) 4:12 TO < 12:12	Lr = 12-20 PSF	REDUCIBLE PER CODE
FLOOR	L = 0 PSF	REDUCIBLE PER CODE

3. SNOW DESIGN PARAMETERS:

N/A

4. WIND DESIGN PARAMETERS:

ULTIMATE DESIGN WIND SPEED (3-SEC GUST)	Vult = 100 MPH
NOMINAL DESIGN WIND SPEED (3-SEC GUST)	Vasd = 77 MPH
RISK CATEGORY	III
EXPOSURE CATEGORY	C
INTERNAL PRESSURE COEFFICIENT	±0.18
ANALYSIS METHOD	DIRECTIONAL PROCEDURE

ROOF PRESSURE FOR COMPONENTS & CLADDING:

N/A

5. EARTHQUAKE DESIGN PARAMETERS:

4.1. SEISMIC IMPORTANCE FACTOR	Ie = 1.25
4.2. RISK CATEGORY	III
4.3. SOIL SITE CLASSIFICATION	'D'
4.4. SEISMIC DESIGN CATEGORY	'D'
4.5. MAPPED SPECTRAL RESPONSE ACCEL	
A) SHORT PERIOD	Se = 1.011g
B) 1-SEC PERIOD	Si = 0.354g
5.6 DESIGN SPECTRAL RESPONSE ACCEL	
A) SHORT PERIOD	Sds = 0.209g
B) 1-SEC PERIOD	Sdi = 0.401g
5.7 SEISMIC FORCE RESISTING SYSTEM	WOOD SHEARWALLS
5.8 SEISMIC BASE SHEAR	V = N/A
5.9 SEISMIC RESPONSE COEFFICIENT	Cs = N/A
5.10 RESPONSE MODIFICATION FACTOR	R = 6.5
5.11 COMPONENT AMPLIFICATION FACTOR	
A) CONDENSER & HVAC	Ap = 2.5
5.12 COMPONENT RESPONSE MODIFICATION FACTOR	
A) CONDENSER & HVAC	Rp = 6.0
5.13 ANALYSIS PROCEDURE	EQUIVALENT LATERAL FORCE

DEMOLITION

- SHORE OR BRACE TRUSSES, BEAMS, COLUMNS, AND WALLS AS REQUIRED TO MAINTAIN THE STABLE INTEGRITY OF THE EXISTING STRUCTURE PRIOR TO DEMOLITION. IT IS THE CONTRACTOR'S SOLE RESPONSIBILITY TO DESIGN AND PROVIDE COMPETENT SHORING AND BRACING FOR ALL LOADS IMPOSED DURING AND AFTER DEMOLITION THROUGH COMPLETION OF NEW CONSTRUCTION.
- ALL DIMENSIONS GIVEN TO AND OF THE EXISTING STRUCTURE ARE APPROXIMATE. VERIFY BY FIELD MEASUREMENTS THE DIMENSIONS OF THE EXISTING STRUCTURE. WHERE ACTUAL CONDITIONS DEVIATE FROM THE DETAILS SHOWN ON THE DRAWINGS, NOTIFY THE STRUCTURAL ENGINEER FOR INSTRUCTIONS PRIOR TO PROCEEDING WITH WORK.
- DEMOLITION AND REMOVAL OF EXISTING CONSTRUCTION SHALL BE MADE IN SUCH A MANNER AS TO AVOID OR MINIMIZE DAMAGE TO ADJACENT CONSTRUCTION.
- EXTENT OF DEMOLITION IS TO BE AS INDICATED ON PLANS, SECTIONS AND DETAILS. DEMOLITION IS TO INCLUDE REMOVAL AND DISPOSAL CONSTRUCTION.

STRUCTURAL STEEL

- FABRICATION, ERECTION AND MATERIALS SHALL CONFORM TO THE SPECIFICATIONS AND STANDARDS OF THE AISC, AS CONTAINED IN THE "AISC 360-10 SPECIFICATIONS OF STRUCTURAL STEEL BUILDING" & THE "AISC MANUAL OF STEEL CONSTRUCTION", 14TH EDITION AND CALIFORNIA BUILDING CODE LATEST EDITION.
- STRUCTURAL STEEL SHALL CONFORM TO THE FOLLOWING SPECIFICATIONS, U.O.N.

SHAPES	
WIDE FLANGES (W, WT, S, M)	ASTM A992
CHANNEL (C), MISC CHANNEL (MC), ANGLES (L)	ASTM A36
HOLLOW STRUCTURAL STEEL (HSS)	ASTM A500, Gr. B
STEEL CIRCULAR PIPES (P)	ASTM A53, TYPE E OR S, GR. B
PLATES & BARS	
COLUMN BASE PLATES	ASTM A36
BRACE GUSSET PLATES	ASTM A36
BEAM SHEAR CONNECTION PLATES	ASTM A36
COLUMN CONTINUITY PLATES	ASTM A572, Gr. 50
BEAM STIFFENER PLATES	ASTM A36
DECK CLOSURE PLATES	ASTM A36
STAINLESS STEEL PLATES & BARS	ASTM A276
OTHER	ASTM A36
NUTS, BOLTS, RODS & WASHERS	
GENERAL BOLTS	ASTM A325-N
SLIP CRITICAL BOLTS (SEE NOTE #4 BELOW)	ASTM A325-SC
HIGH STRENGTH BOLTS	ASTM A325-N OR A490
MACHINE BOLTS (GENERAL USE)	ASTM A307
BENT & HEADED ANCHOR BOLTS	ASTM F1554, Gr. 36, 55, OR 105
PARTIAL & FULLY THREADED ANCHOR RODS	ASTM F1554, Gr. 36, 55, OR 105
FULLY THREADED RODS (GENERAL USE)	ASTM A36 (A307 Gr. A for 3/8" Ø)
WELDED SHEAR CONNECTORS	ASTM A108, Gr. 1015 thru 1020
WELDED TREADED STUDS	ASTM A108, Gr. 1015 thru 1020
NUTS FOR BOLTS & MACHINE BOLTS	ASTM A563
HARDENED WASHERS	ASTM F436
UNHARDENED WASHERS	ASTM F844
PLAIN WASHERS	ASTM B18.22.1
BEVELED WASHERS	ASTM B18.23.1

- BOLTED CONNECTIONS SHALL CONSIST OF UNFINISHED BOLTS PER THE TABLE ABOVE UNLESS NOTED OTHERWISE. ANCHOR BOLTS CAST IN CONCRETE OR MASONRY SHALL BE HEADED BOLTS w/ CUT THREAD, FULL DIAMETER BODY STYLE CONFORMING TO ASTM F1554 U.O. UNLESS NOTED OTHERWISE. ANCHOR BOLTS SHALL BE GRADE 55 PER SI SUPPLEMENTARY REQUIREMENTS. ALL BOLTED CONNECTIONS AND BASE PLATES SHALL HAVE STANDARD CUT WASHERS UNLESS NOTED OTHERWISE. WASHERS AT BASE SHALL BE PLACED AT TOP AND BOTTOM OF PLATE.
- "SLIP"-CRITICAL BOLTED CONNECTIONS:
 - "SLIP"-CRITICAL CONNECTIONS (A325-SC DESIGN VALUES w/ SPECIAL INSPECTION) ARE REQUIRED AT ALL BRACED FRAME CONNECTIONS, AT ALL CONNECTIONS ALONG CHORD LINES AND DRAG LINES (AS NOTED ON PLANS) AND U.O. AT ALL BOLTS IN OVERSIZED OR SLOTTED HOLES.
 - THE SPECIAL INSPECTOR MUST BE PRESENT DURING INSTALLATION AND TIGHTENING OPERATION OF "SLIP"-CRITICAL CONNECTIONS.
- ALL STRUCTURAL STEEL SHALL RECEIVE MINIMUM OF ONE SHOP COAT OF RED PRIMER w/ A MINIMUM DRY FILM THICKNESS OF 2.0 MILS. DO NOT SHOP PRIME OR PAINT AREAS TO BE FIELD WELDED, FIREPROOFED, GALVANIZED, TO RECEIVE SLIP-CRITICAL HIGH STRENGTH BOLTS, OR TO BE EMBEDDED IN CONCRETE. PRIOR TO PRIMING OR PAINTING, CLEAN STRUCTURAL STEEL & AS REQUIRED BY THE PRIMER & PAINT MANUFACTURER, PROVIDE ADDITIONAL PAINTING AS NOTED IN THE SPECIFICATIONS.
- ALL STRUCTURAL STEEL SHALL BE ERECTED PLUMB AND TRUE TO LINE. TEMPORARY BRACING SHALL BE INSTALLED AND SHALL BE LEFT IN PLACE UNTIL OTHER MEANS ARE PROVIDED TO ADEQUATELY BRACE THE STRUCTURE. CONTRACTOR RESPONSIBLE FOR REVIEWING ALL BASE PLATE AND SUPPORT CONDITIONS DURING ERECTION AND BRACING AS REQUIRED. SEE AISC AND OSHA REQUIREMENTS.
- PLACE NON-SHRINK GROUT UNDER ALL BASE PLATES BEFORE ADDING VERTICAL LOAD. SEE CONCRETE NOTES FOR NON-SHRINK GROUT REQUIREMENTS.
- STRUCTURAL STEEL BELOW GRADE SHALL HAVE 3" MINIMUM OF CONCRETE COVER.
- PROVIDE 1/2" Ø STITCH BOLTS AND RING FILLS, SPACE AT NOT MORE THAN 24" CG FOR ALL DOUBLE ANGLE MEMBERS.
- AT WOOD TO STEEL PARALLEL CONTACT, ATTACH w/ 1/2" Ø WELDED THREADED STUDS AT MAXIMUM 3'2" CG, & 6" FROM ENDS OF WOOD MEMBER, TYPICAL UNLESS NOTED OTHERWISE.
- HOLES FOR UNFINISHED BOLTS SHALL BE OF THE SAME NOMINAL DIAMETER OF THE BOLTS PLUS 1/16". USE STANDARD AISC GAGE AND PITCH FOR BOLTS EXCEPT AS NOTED OTHERWISE. HOLES FOR ANCHOR BOLTS EMBEDDED IN CONCRETE SHALL BE OF THE SAME NOMINAL BOLT DIAMETER PLUS 3/16" UNLESS NOTED OTHERWISE.
- WELDING SHALL BE DONE BY THE ELECTRIC ARC PROCESS IN ACCORDANCE w/ AMERICAN WELDING SOCIETY STANDARDS, USING ONLY CERTIFIED WELDERS. ALL GROOVE WELDS SHALL HAVE COMPLETE PENETRATION UNLESS NOTED OTHERWISE. ALL EXPOSED WELDS SHALL BE GRIND SMOOTH. ALL WELDING TO BE DONE USING E70XX ELECTRODES. IN ADDITION, WELDING OF ASTM A572 GRADE 50 STEEL AND ASTM A992 STEEL SHALL BE DONE w/ ELECTRODES CAPABLE OF DEPOSITING WELD METAL w/ A MAXIMUM DIFFUSIBLE HYDROGEN CONTENT OF 10ml/100g (HI6). WELD LENGTHS CALLED FOR ON PLANS ARE THE NET EFFECTIVE LENGTHS REQUIRED.
- MINIMUM FILLET WELDS:
 - 3/8" @ t < 1/2"
 - 1/2" @ t < 3/4"
 - 3/8" @ t > 3/4"
- WELDING PROCEDURES SPECIFICATIONS (WPS) FOR SHOP AND FIELD PRE-QUALIFIED WELD JOINTS AND WELD JOINTS QUALIFIED BY TEST SHALL BE PREPARED FOR REVIEW PRIOR TO FABRICATION. ALL WELDING PROCEDURES THAT MEET THESE REQUIREMENTS OF AWS D1.1 SEC. 5.1 SHALL BE CONSIDERED AS PRE-QUALIFIED. QUALIFICATION TESTING IS REQUIRED WHEN THE DEPTH OF A PARTIAL PENETRATION OR COMPLETE PENETRATION WELD IS 2" OR GREATER.
- STRUCTURAL STEEL & FASTENERS THAT ARE PERMANENTLY EXPOSED TO WEATHER SHALL BE EITHER PRIMED AND PAINTED OR HOT DIPPED GALVANIZED IN ACCORDANCE w/ ASTM A780.
- WHEN STRUCTURAL STEEL & CONNECTIONS WILL BE EXPOSED TO VIEW IN THE COMPLETED BUILDING, THEY SHALL BE FABRICATED, ERECTED & FINISHED IN COMPLIANCE w/ ARCHITECTURALLY EXPOSED STRUCTURAL STEEL (AESS) GUIDELINES & SECTION 10 OF THE AISC 303-05 "CODE OF STANDARD PRACTICE FOR STEEL BUILDINGS AND BRIDGES".

WOOD

- ALL SAWN LUMBER SHALL BE DOUGLAS FIR-LARCH AS GRADED BY THE WEST COAST LUMBER INSPECTION BUREAU (NCLIB) IN ACCORDANCE w/ STANDARD GRADING RULES NO. 17 TYPICAL UNLESS NOTED OTHERWISE. ALL MEMBERS SHALL HAVE A MINIMUM GRADE OF NO. 1 EXCEPT 2x4 AND 2x6 WALL STUDS, PLATES, AND BLOCKING MAY BE NO. 2.
- ALL STRUCTURAL SHEATHING USED FOR SHEARWALLS AND ROOF SHEATHING SHALL CONFORM TO THE REQUIREMENTS FOR THEIR TYPE IN DOC P51, DOC P52 OR ANSI/APA PRF 210. EACH PANEL OR MEMBER SHALL BE IDENTIFIED FOR GRADE, BOND CLASSIFICATION, AND PERFORMANCE CATEGORY BY THE TRADEMARKS OF AN APPROVED TESTING AND GRADING AGENCY.
- ALL FOUNDATION PLATES OR SILLS ON CONCRETE SLABS WHICH ARE IN DIRECT CONTACT w/ EARTH, AND PLATES OR SILLS ON CONCRETE OR MASONRY FOUNDATIONS, SHALL BE PRESSURE TREATED.
- ALL WOOD SHALL HAVE A MOISTURE CONTENT OF NOT MORE THAN 19% WHEN SHEATHING IS APPLIED.
- 8" MINIMUM CLEARANCE SHALL BE MAINTAINED AT ALL EXTERIOR WALLS BETWEEN FINISH GRADE AND BOTTOM OF WOOD WALLS.
- BEARING AND SHEARWALLS SHALL HAVE DOUBLE TOP PLATES LAPPED AT WALL CORNERS AND INTERSECTIONS AND PLATES SHALL BE INTERNAILED w/ (3)-16d AT SUCH LOCATIONS. FOR PLATE SPLICE DETAILS, SEE DRAWINGS.
- SILL PLATE ANCHOR BOLTS SHALL BE INSTALLED w/ PLATE WASHERS 3x3x0.229 BETWEEN NUT AND PLATE.
- PROVIDE SOLID BLOCKING BETWEEN JOIST AND RAFTERS AT ALL SUPPORTS.
- PROVIDE BLOCKING AT ALL CEILING LEVELS.
- JOIST UNDER AND PARALLEL TO PARTITION SHALL BE DOUBLED AND NAILED TOGETHER.
- HOLES FOR BOLTS IN WOOD SHALL BE BORED w/ A BIT OF THE SAME NOMINAL DIAMETER AS THE BOLT PLUS 1/16".
- HOLES FOR LAG SCREWS SHALL BE BORED AS FOLLOWS:
 - THE CLEARANCE HOLE FOR THE SHANK SHALL HAVE THE SAME DIAMETER AS THE SHANK, AND THE SAME DEPTH OF PENETRATION AS THE LENGTH OF UNTHREADED SHANK.
 - THE LEAD HOLE FOR THE THREADED PORTION SHALL HAVE A DIAMETER EQUAL TO 60% TO 70% OF THE SHANK DIAMETER AND A LENGTH EQUAL TO AT LEAST THE LENGTH OF THE THREADED PORTION.
- LAG SCREWS AND WOOD SCREWS SHALL BE SCREWED AND NOT DRIVEN INTO PLACE. SOAP MAY BE USED TO LUBRICATE THE SCREWS.
- ALL BOLTS AND LAG SCREWS SHALL BE PROVIDED w/ METAL WASHERS UNDER HEADS AND NUTS WHICH BEAR IN WOOD. APPLIES ALSO TO INSERTED EXPANDING FASTENERS, RED HEAD, ETC.

BOLT DIAMETER	M1 WASHERS	STEEL WASHER
3/8" Ø	2 3/4" Øx3/16"	3"x3"x3/16"
1/2" Ø	3" Øx1/8"	3"x3"x3/16"
3/4" Ø	3 1/2" Øx1/8"	3 1/2"x3 1/2"x3/16"
1" Ø	4" Øx1/2"	3 3/4"x3 3/4"x3/16"

- ALL BOLTS AND LAG SCREWS SHALL BE TIGHTENED AT INSTALLATION AND RETIGHTENED BEFORE CLOSING IN OR AT COMPLETION OF JOB.
- LAY ALL STRUCTURAL SHEATHING ON ROOF AND FLOORS w/ FACE GRAIN PERPENDICULAR TO SUPPORT TYPICAL UNLESS OTHERWISE. USE PLY-CLIPS AT UNSUPPORTED SHEATHING EDGES.
- CONNECTOR HARDWARE MODEL NUMBER ARE THOSE FOR SIMPSON

STRONG-TIE COMPANY. ALL JOIST HANGERS SHALL BE SIMPSON U SERIES UNLESS NOTED OTHERWISE. EQUIVALENT CONNECTORS w/ ICC ACCEPTANCE MAY BE SUBMITTED FOR REVIEW AS AN ALTERNATE.

18. NOTIFY ARCHITECT AFTER WALL, FLOOR, AND ROOF SHEATHING NAILING HAS BEEN COMPLETED AND A MINIMUM OF 48 HOURS PRIOR TO CONCEALING SHEATHING.

19. FASTENERS, NUTS AND WASHERS IN CONTACT w/ SBX/DOT AND ZINC BORATE TREATED WOOD IN INTERIOR DRY CONDITIONS MAY BE CARBON STEEL. FASTENERS IN OTHER PRESERVATIVE-TREATED WOOD (ANCHOR BOLTS, NAILS, SCREWS) SHALL BE APPROVED SILICON BRONZE OR COPPER, STAINLESS STEEL OR HOT-DIPPED ZINC-COATED STEEL PER CBC 2304.9.5. U.O.N.

APPROVALS

PO Box 1900
Yuba City, CA 95992-1900
530.298.7298
www.spinc-arch.com

ARCHITECTURAL • COMMERCIAL • RESIDENTIAL • INTERIOR • CONSTRUCTION MANAGEMENT



SYNTHESIS PARTNERS, LLC
Managers • Architects


OWNER

Woodland Joint Unified School District
435 6th Street
Woodland, CA 95695

PROJECT

CLASSROOM CONVERSIONS
at
WOODLAND EDUCATION CENTER
575 Hays Street
Woodland, CA 95695

KEY PLAN

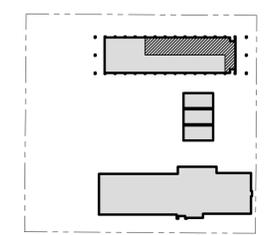

THIS IS A PRELIMINARY SET FOR REVIEW ONLY NOT FOR CONSTRUCTION




NO.	REVISION DESCRIPTION	DATE

GENERAL NOTES


S0.1

DATE 2023-03-01
PROJECT NO. 21-W04-01

©2023 Synthesis Partners, LLC. All Rights Reserved. These record drawings have been prepared based upon information submitted, in part, by others. While this information is believed to be reliable, The Architect is not responsible for their accuracy, nor for errors or omissions which may have been incorporated into these documents as a result.

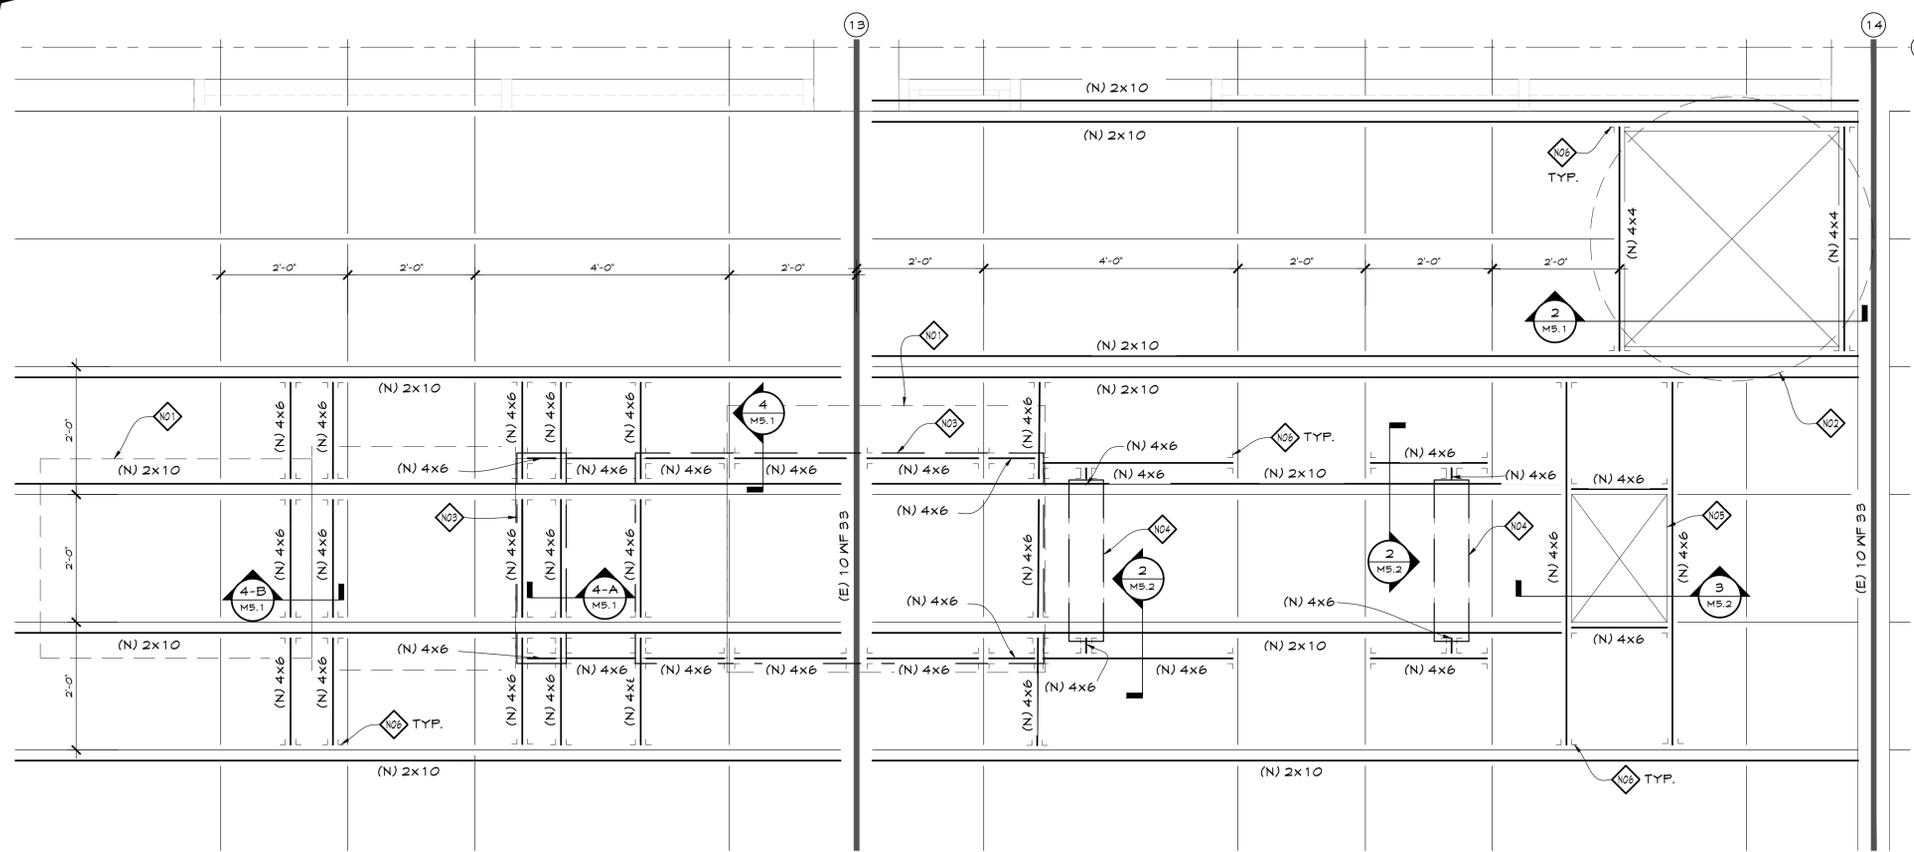

PARTIAL ENLARGED ROOF FRAMNG PLAN SCALE: 3/4" = 1'-0" 2

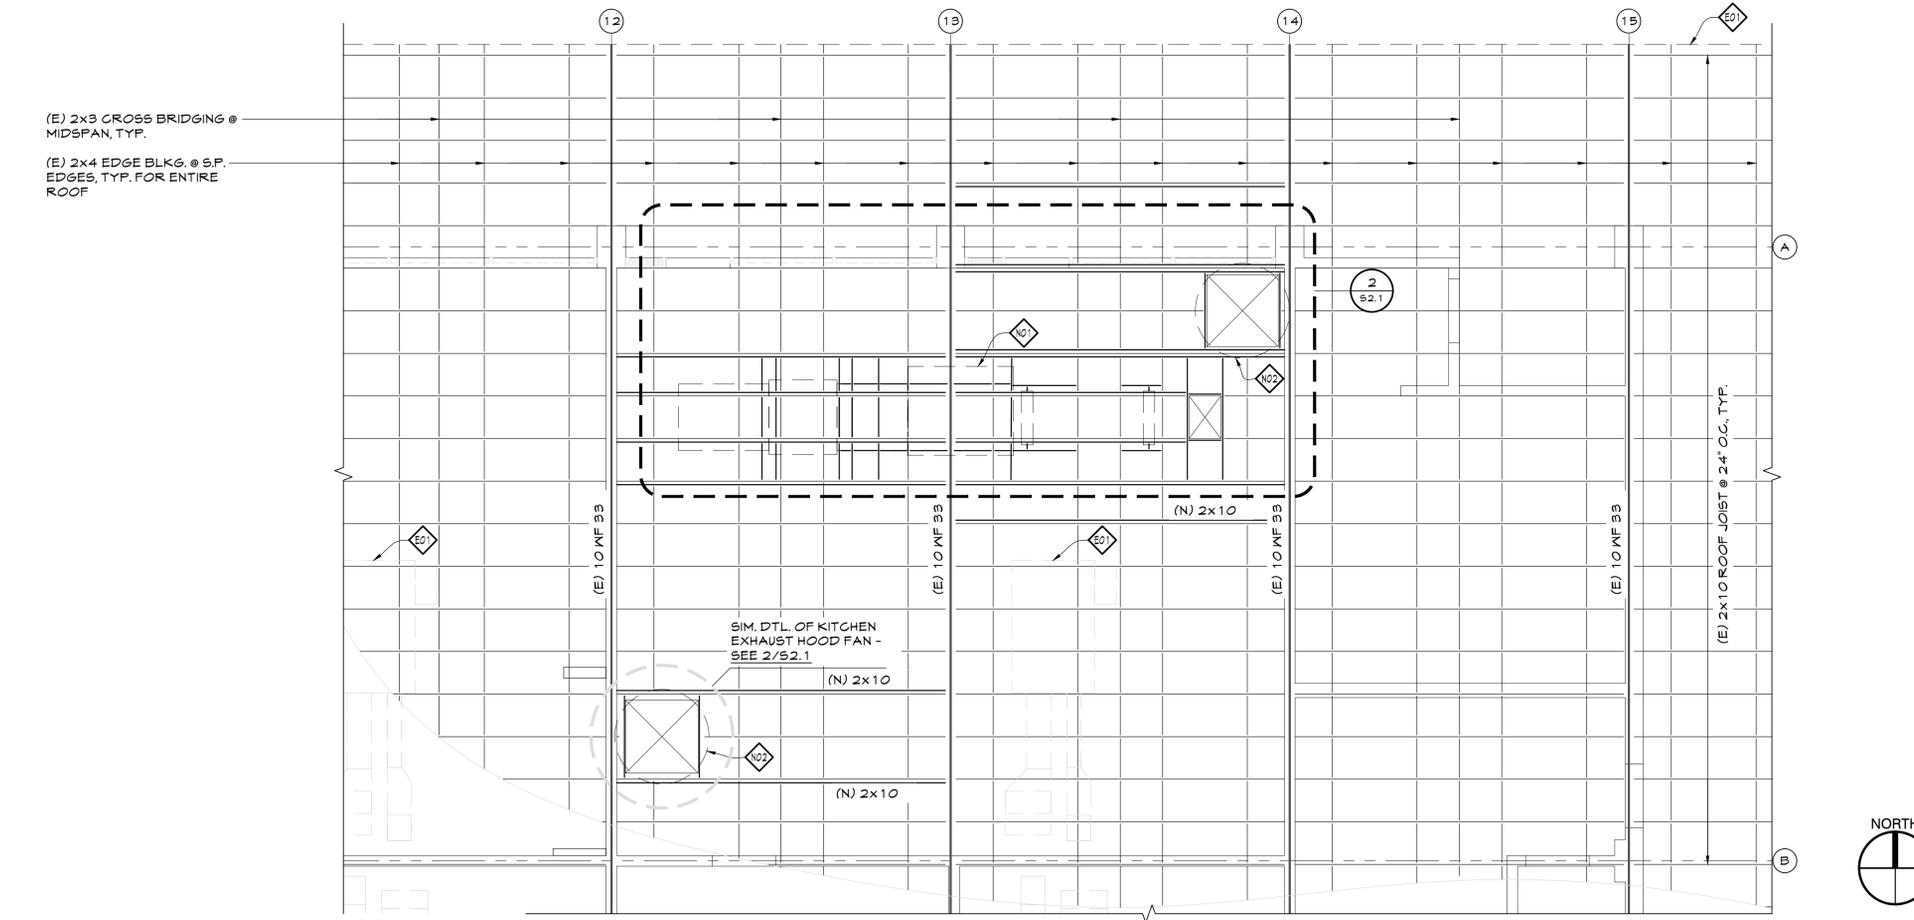

PARTIAL ROOF FRAMNG PLAN SCALE: 1/4" = 1'-0" 1

KEYNOTES

EXISTING

- E01 (2) 2x10 FACIA
- E02 AC EQUIPMENT ON ROOF

NEW / ALTERATION

- N01 MAKE UP AIR UNIT - SEE MECH. DWGS.
- N02 KITCHEN EXHAUST HOOD FAN - SEE MECH. DWGS.
- N03 ROOF CURB - SEE MECH. DWGS.
- N04 DUCT SUPPORT - SEE MECH. DWGS.
- N05 DUCT THRU ROOF - SEE MECH. DWGS.
- N06 A35 EA. SIDE END OF BLKG., TYP.

©2023 Synthesis Partners, LLC. All Rights Reserved.
 These record drawings have been prepared based upon information submitted, in part, by others. While this information is believed to be reliable, the Architect is not responsible for their accuracy, nor for errors or omissions which may have been incorporated into these documents as a result.

PO Box 1900
 Yuba City, CA 95992-1900
 530.298.7298
 www.spinc-arch.com

ARCHITECTURAL • COMMERCIAL • RESIDENTIAL • INTERIOR • CONSTRUCTION MANAGEMENT



SYNTHESIS PARTNERS, LLC
 Managers • Architects

APPROVALS


OWNER

Woodland Joint Unified School District
 435 6th Street
 Woodland, CA 95695

PROJECT

CLASSROOM CONVERSIONS
 at
 WOODLAND EDUCATION CENTER
 575 Hays Street
 Woodland, CA 95695

KEY PLAN

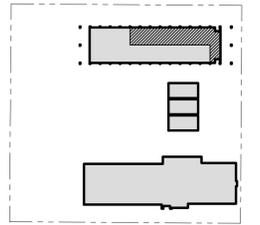

THIS IS A PRELIMINARY SET FOR REVIEW ONLY NOT FOR CONSTRUCTION




NO.	REVISION DESCRIPTION	DATE


PARTIAL ROOF FRAMNG PLANS

S2.1


DATE 2023-03-01
 PROJECT NO. 21-W04-01

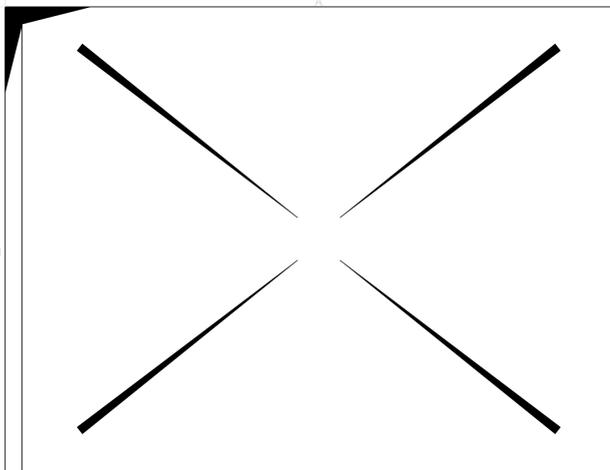


NOT USED SCALE: NONE 16

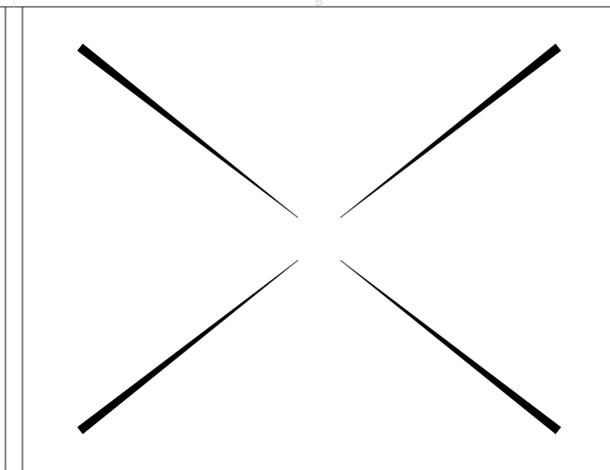


NOT USED SCALE: NONE 12

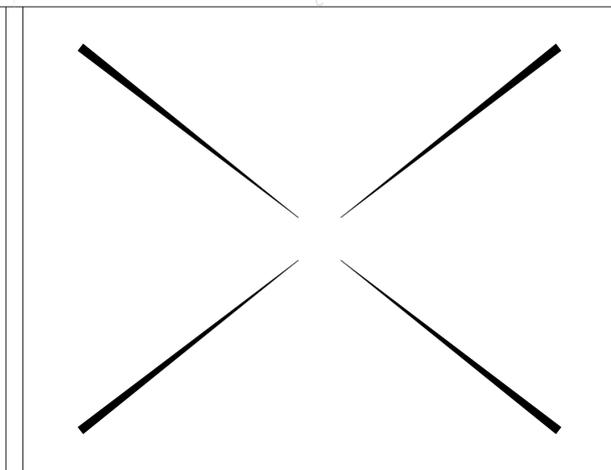


NOT USED SCALE: NONE 8

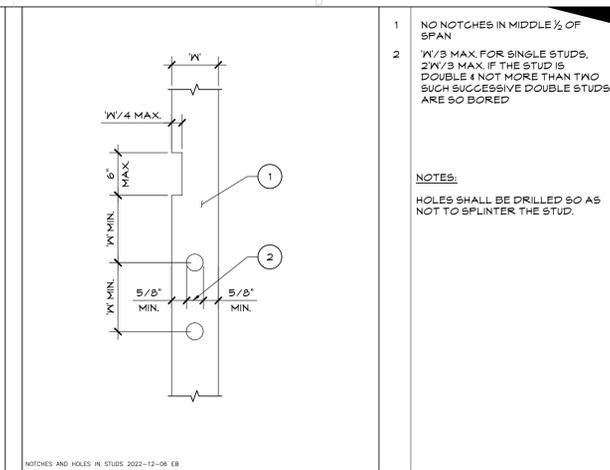


NOTCHES AND HOLES IN STUDS SCALE: 1" = 1'-0" 4

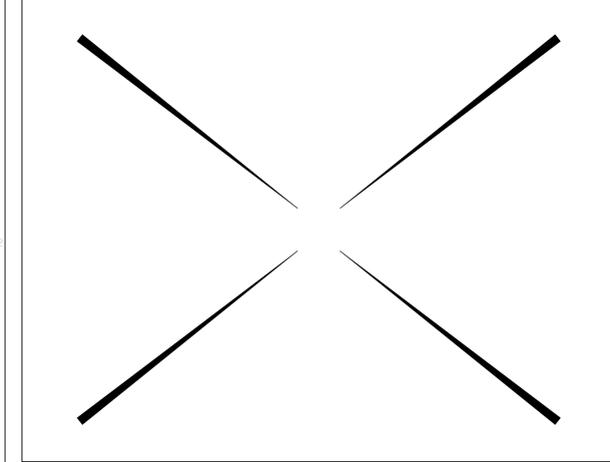


NOT USED SCALE: NONE 15

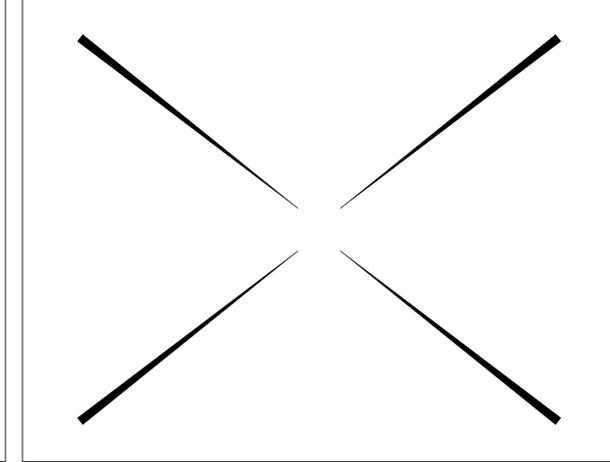


NOT USED SCALE: NONE 11

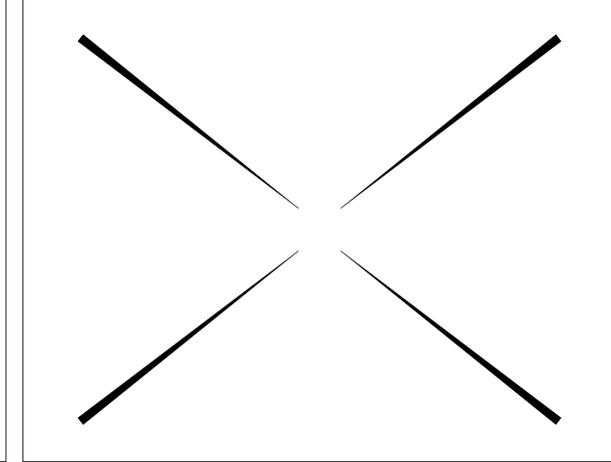


NOT USED SCALE: NONE 7

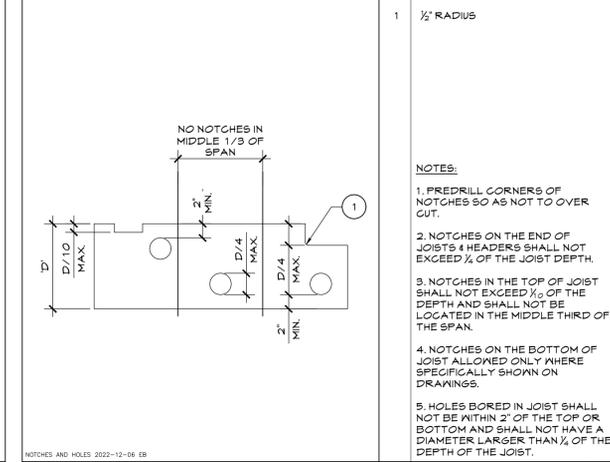


NOTCHES AND HOLES IN JOISTS SCALE: 1" = 1'-0" 3

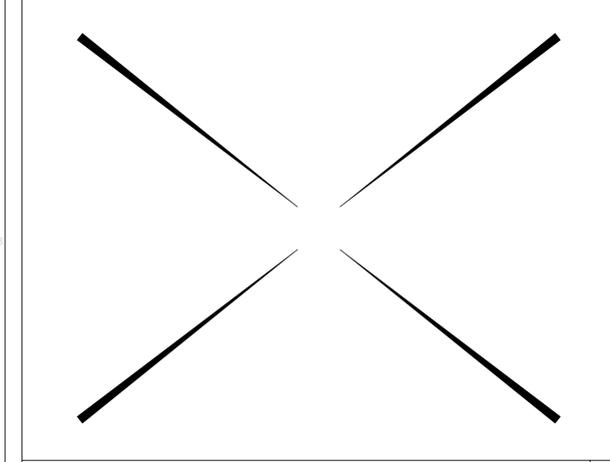


NOT USED SCALE: NONE 14

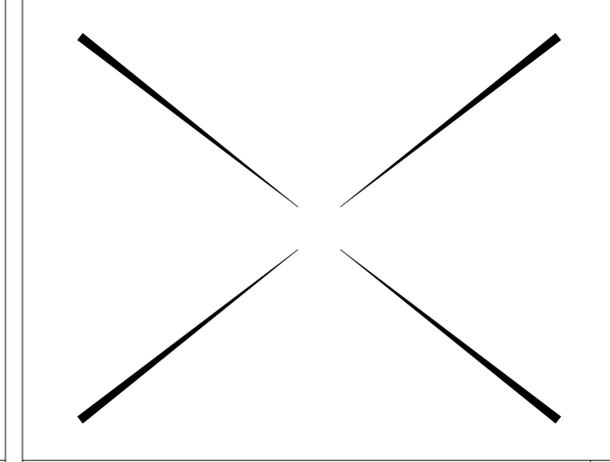


NOT USED SCALE: NONE 10

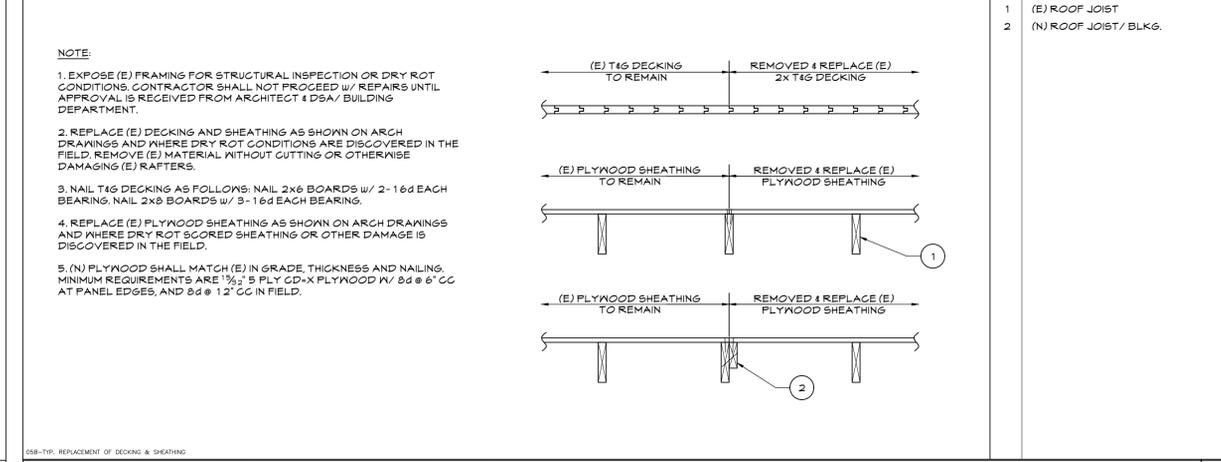


TYPICAL REPLACEMENT OF DECKING & SHEATHING SCALE: 1/2" = 1'-0" 2

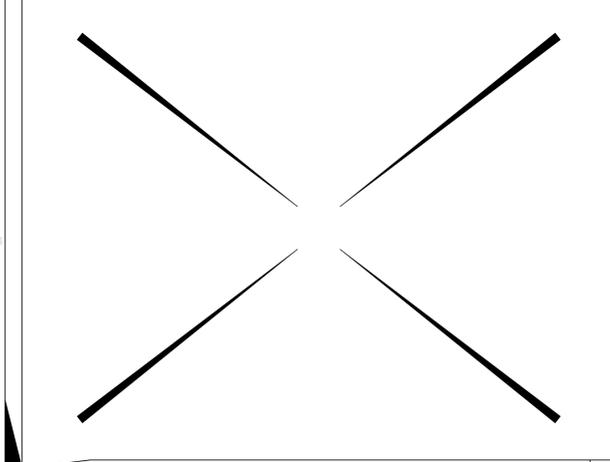


NOT USED SCALE: NONE 13

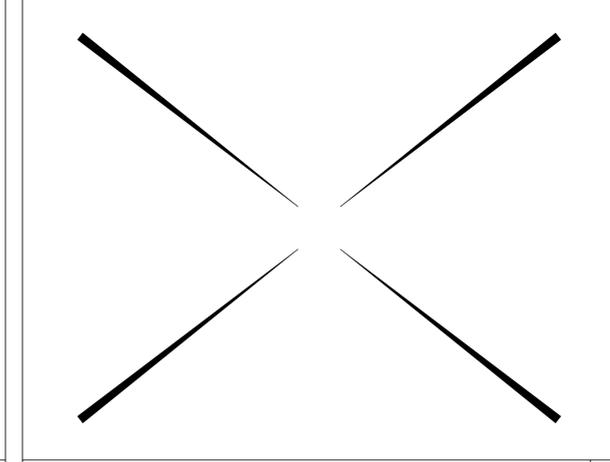

NOT USED SCALE: NONE 9

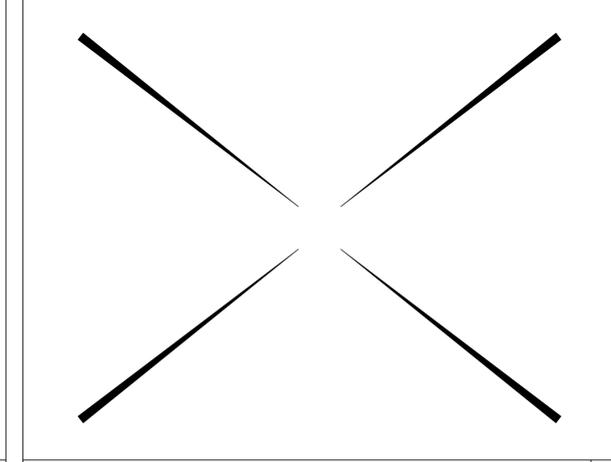

NOT USED SCALE: NONE 5

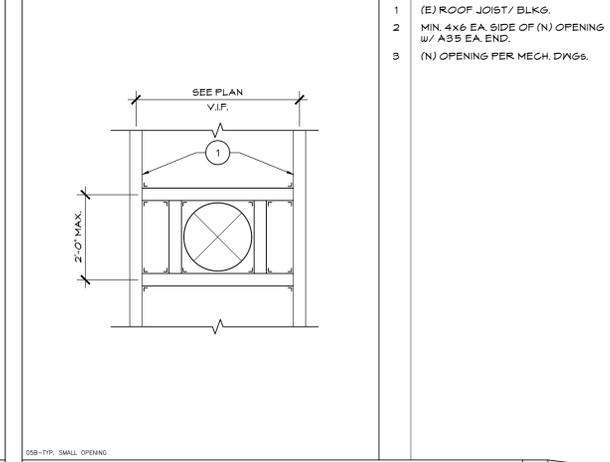

TYPICAL SMALL OPENING SCALE: 1/2" = 1'-0" 1

©2023 Synthesis Partners, LLC. All Rights Reserved. These record drawings have been prepared based upon information submitted, in part, by others. While this information is believed to be reliable, the Architect is not responsible for their accuracy, nor for errors or omissions which may have been incorporated into these documents as a result.

PO Box 1900
Yuba City, CA 95992-1900
530.298.7298
www.spinc-arch.com


ARCHITECTURAL • COMMERCIAL • RESIDENTIAL • INTERIOR • CONSTRUCTION MANAGEMENT



SYNTHESIS PARTNERS, LLC
Managers • Architects

OWNER
Woodland Joint Unified School District
435 6th Street
Woodland, CA 95695

PROJECT
CLASSROOM CONVERSIONS
at
WOODLAND EDUCATION CENTER
575 Hays Street
Woodland, CA 95695

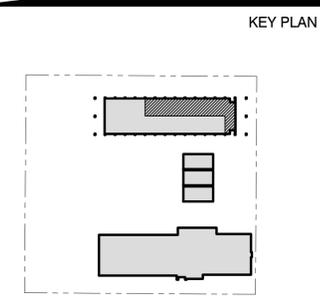

THIS IS A PRELIMINARY SET FOR REVIEW ONLY NOT FOR CONSTRUCTION

NO.	REVISION DESCRIPTION	DATE

DETAILS & NOTES

DATE 2023-03-01
PROJECT NO. 21-W04-01
S2.2

CAPTRATE SOLO FILTERS

CAPTRATE FILTERS ARE BUILT IN COMPLIANCE WITH:

- NFPA #86
- NSF STANDARD #2
- UL STANDARD #1046
- INT. MECH. CODE (IMC)

RESISTANCE VS. AIRFLOW

RESISTANCE VS. AIRFLOW

SPECIFICATION: CAPTRATE® GREASE-STOP SOLO FILTER



THE CAPTRATE GREASE-STOP SOLO FILTER IS A SINGLE-STAGE FILTER FEATURING A UNIQUE 3-BAFFLE DESIGN IN CONJUNCTION WITH A SLOTTED REAR BAFFLE DESIGN, TO DELIVER EXCEPTIONAL FILTRATION EFFICIENCY.

FILTER IS CONSTRUCTED OF 430 STAINLESS STEEL, AND SIZED TO FIT INTO STANDARD 2-INCH DEEP HOOD CHANNEL(S).

UNITS SHALL INCLUDE STAINLESS STEEL HANDLES AND A FASTENING DEVICE TO SECURE THE TWO COMPONENTS WHEN ASSEMBLED.

***GREASE EXTRACTION EFFICIENCY PERFORMANCE SHALL REMOVE AT LEAST 70% OF GREASE PARTICLES FIVE MICRONS IN SIZE, AND 90% GREASE PARTICLES SEVEN MICRONS IN SIZE AND LARGER, WITH A CORRESPONDING PRESSURE DROP NOT TO EXCEED 1.0 INCHES OF WATER GAUGE.

NOMINAL SIZE (H x W)	ACTUAL DIMENSIONS (H x W x D)	FREE AREA (SQ. FEET)	WEIGHT (POUNDS)	VELOCITY (FEET PER MINUTE)	STATIC PRESSURE (WATER GAUGE)
20 x 20	19-5/8" x 19-5/8" x 1-7/8"	228	11	180	0.25
20 x 16	19-5/8" x 15-5/8" x 1-7/8"	178	8.9	145	0.25
16 x 20	15-5/8" x 19-5/8" x 1-7/8"	178	9.1	145	0.25
16 x 16	15-5/8" x 15-5/8" x 1-7/8"	139	7.4	125	0.25
12 x 20	11-5/8" x 19-5/8" x 1-7/8"	123	6.8	100	0.30
12 x 16	11-5/8" x 15-5/8" x 1-7/8"	96	5.6	85	0.30
10 x 20	9-5/8" x 19-5/8" x 1-7/8"	100	5.6	85	0.30
10 x 16	9-5/8" x 15-5/8" x 1-7/8"	78	4.6	67	0.30

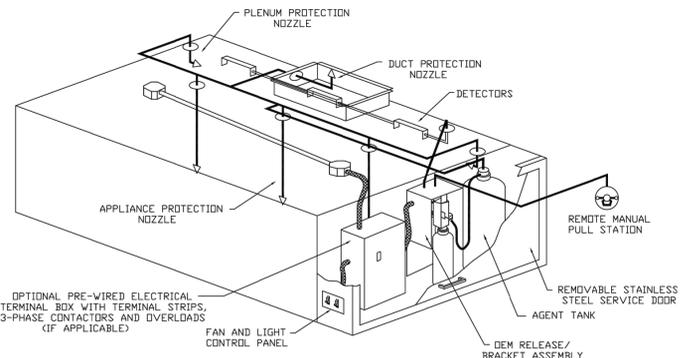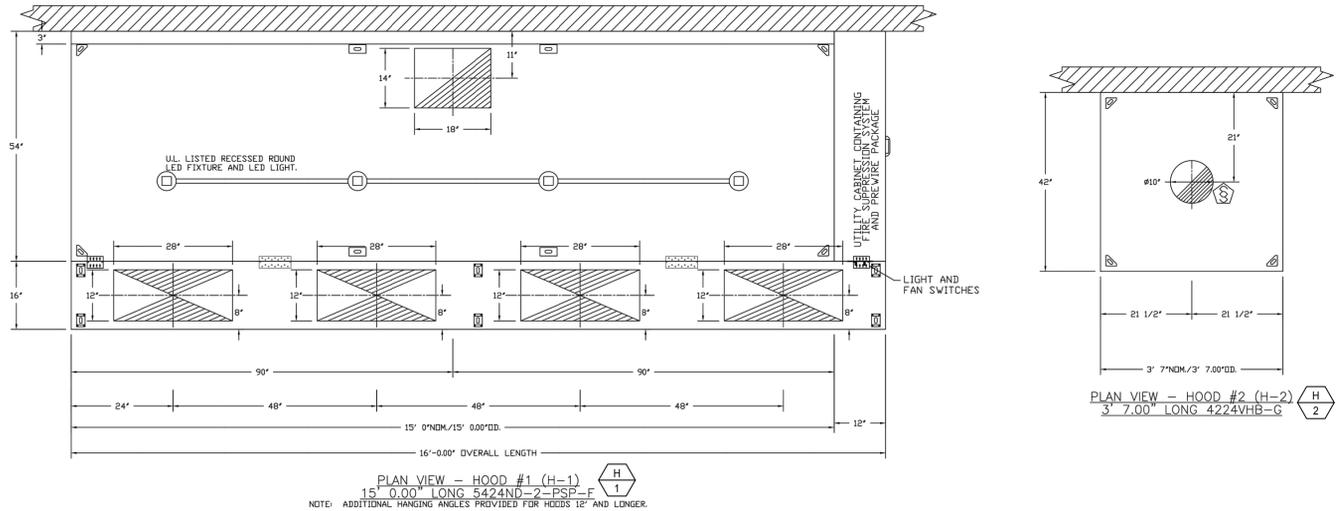

HOOD OPTIONS

HOOD NO	TAG	OPTION
1	H-1	FIELD WRAPPER 17.00" HIGH FRONT, LEFT, RIGHT. BACKSPLASH 80.00" HIGH X 192.00" LONG 430 SS VERTICAL.

PERFORATED SUPPLY PLENUM(S)

HOOD NO	TAG	PDS	LENGTH	WIDTH	HEIGHT	TYPE	RISER(S)			
							WIDTH	LENG	DIA	CFM
1	H-1	Front	192"	16'	6'	MUA	12"	28"	746	0.209"
						MUA	12"	28"	746	0.209"
						MUA	12"	28"	746	0.209"

HOOD INFORMATION - JOB#5688675

HOOD NO	TAG	MODEL	MANUFACTURER	LENGTH	MAX COOKING TEMP	TYPE	APPLIANCE DUTY	DESIGN CFM/FT	TOTAL EXH CFM	EXHAUST PLENUM				TOTAL SUPPLY CFM	HOOD CONSTRUCTION	HOOD CONFIG			
										WIDTH	LENG	HEIGHT	RISER(S)			END TO END	RDW		
1	H-1	5424	CAPTIVEAIRE	15' 0"	600 DEG	I	HEAVY	240	3600	14'	18'	4'	3600	2057	-1.272'	2985	430 SS WHERE EXPOSED	ALONE	ALONE
2	H-2	4224	CAPTIVEAIRE	3' 7"	700 DEG	II	N/A	150	538	4'	10'	538	986	-0.073'	0	430 SS 100Z	ALONE	ALONE	

HOOD INFORMATION

HOOD NO	TAG	TYPE	FILTER(S)			LIGHT(S)			UTILITY CABINET(S)			FIRE SYSTEM PIPING	HOOD HANGING WEIGHT				
			QTY	HEIGHT	LENGTH	EFFICIENCY @ 7 MICRONS	QTY	TYPE	WIRE GUARD	LOCATION	SIZE			FIRE SYSTEM	ELECTRICAL	SWITCHES	
1	H-1	CAPTRATE SOLO FILTER	11	20"	16'	85% SEE FILTER SPEC	4	RECESSED ROUND	ND	RIGHT	12"x54"x24"	ANSUL R-102	3.0	DCV-1111	1 LIGHT 1 FAN	YES	978 LBS
2	H-2						0									NO	136 LBS

These products and others are available for demonstration at the Northern CA display center --For more information or questions Contact--
Captive Aire Systems
1110 Burnett Ave, Suite G, Concord, CA 94520
Phone: (925)962-1999, Fax: (925)566-8565
Email: reg92@captiveaire.com

CAPTIVEAIRE

Northern California Office
1110 Burnett Ave, Suite G, Concord, CA 94520 PHONE: (925) 962-1999 FAX: (925) 566-8565 EMAIL: reg92@captiveaire.com

Woodland Culinary Classroom
575 Hays Street,
Woodland, CA, 95695

REVISIONS

NO.	DESCRIPTION	DATE

DATE: 11/18/2022
DWG.#: 5668675
DRAWN BY:
SCALE: 3/4" = 1'-0"
MASTER DRAWING
SHEET NO. 1

APPROVALS

PO Box 1900
Yuba City, CA 95992-1900
530.298.7298
www.spinc-arch.com

SYNTHESIS PARTNERS, LLC
Managers • Architects

WESTON & ASSOCIATES
MECHANICAL ENGINEERS
601 UNIVERSITY AVE., SUITE 200 | SACRAMENTO, CA 95825
WESTON & ASSOCIATES #22-033

OWNER

Woodland Joint Unified School District
435 6th Street
Woodland, CA 95695

PROJECT

CLASSROOM CONVERSIONS
at
WOODLAND EDUCATION CENTER
575 Hays Street
Woodland, CA 95695

KEY PLAN

DATE: 2022-07-24
PROJECT NO: 21-W04-01

M0.2

PO Box 1900
Yuba City, CA 95992-1900
530.298.7298
www.spinc-arch.com



SYNTHESIS PARTNERS, LLC
Managers • Architects


WESTON & ASSOCIATES
MECHANICAL ENGINEERS
601 UNIVERSITY AVE., SUITE 200 | SACRAMENTO, CA 95825
WESTON & ASSOCIATES #22-033

OWNER

Woodland Joint Unified School District
435 6th Street
Woodland, CA 95695

PROJECT
CLASSROOM CONVERSIONS
at
WOODLAND EDUCATION CENTER
575 Hays Street
Woodland, CA 95695

KEY PLAN

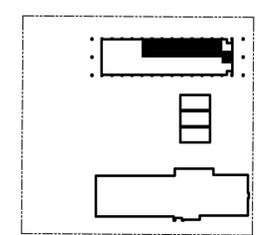

FOR PEAN REVIEW ONLY
NOT FOR CONSTRUCTION

NO.	REVISION DESCRIPTION	DATE

MECHANICAL SCHEDULES & NOTES

M0.4

DATE: 2022-07-24
PROJECT NO.: 21-W04-01

CAPTIVE

Northern California Office

1110 Burnett Ave, Suite G, Concord, CA 94520 PHONE: (925) 962-1999 FAX: (925) 966-8565 EMAIL: reg92@captiveaire.com

Woodland Culinary Classroom

575 Hays Street,

Woodland, CA, 95695

DATE: 11/18/2022

DWG.#: 5668675

DRAWN BY:

SCALE: 3/4" = 1'-0"

MASTER DRAWING

SHEET NO. 3

EXHAUST FAN INFORMATION - JOB#5668675

FAN UNIT NO	TAG	QTY	FAN UNIT MODEL #	MANUFACTURER	CFM	ESP	RPM	MOTOR ENCL	HP	BHP	PHASE	VOLT	FLA	DISCHARGE VELOCITY	WEIGHT (LBS)	SDNES
1	KEF-1	1	DU240HFA	CAPTIVEAIR	3600	1.500	867	ODP, PREMIUM	3.000	1.8240	3	208	10.2	818 FPM	304	14.6
2	KEF-2	1	DUI2HFA	CAPTIVEAIR	538	0.250	1454	TEAD-ECM	0.250	0.0920	1	115	2.9	382 FPM	58	8.6

MUA FAN INFORMATION - JOB#5668675

FAN UNIT NO	TAG	QTY	FAN UNIT MODEL #	BLOWER	HOUSING	MIN CFM	DESIGN CFM	ESP	RPM	MOTOR ENCL	HP	BHP	PHASE	VOLT	FLA	MCA	MDCP	EVAP FLOW RATE (GAL/HR)	EVAP COOLER ENTERING DB TEMP	EVAP COOLER LEAVING DB TEMP	EVAP COOLER ENTERING WB TEMP	EVAP COOLER LEAVING WB TEMP	WEIGHT (LBS)	SDNES
3	MAU-1	1	A2-1BT-200-20D	20MF-2-MDD	A2-1BT-200	1300	3240	0.500	1527	ODP, PREMIUM	3.000	2.1160	3	208	9.5	11.9A	20A	4.63	98.0°F	70.0°F	78.0°F	70.0°F	1295	14.6

GAS FIRED MAKE-UP AIR UNIT(S)

FAN UNIT NO	TAG	INPUT BTUs	OUTPUT BTUs	TEMP RISE	REQUIRED INPUT GAS PRESSURE	GAS TYPE	BURNER EFFICIENCY(%)
3	MAU-1	189293	153327	41°F	7 IN. W.C. - 14 IN. W.C.	NATURAL	81

FAN OPTIONS

FAN UNIT NO	TAG	QTY	DESCRIPTION
1	KEF-1	1	GREASE BOX
		1	2 YEAR PARTS WARRANTY
2	KEF-2	1	GREASE BOX
		1	ECM WIRING PACKAGE - EXHAUST - MANUAL DR 0-10VDC REFERENCE SPEED CONTROL -MSC-(TELCD), CCW ROTATION
3	MAU-1	1	2 YEAR PARTS WARRANTY
		1	INLET PRESSURE GAUGE, 0-35"
		1	MANIFOLD PRESSURE GAUGE, 0 TO 10" WC, 1 FURNACE
		1	STANDARD ELECTRICAL CONNECTION (MAIN AND CONTROL PANEL) FOR STANDING POWER - SINGLE MODULE. IF A NON-DCV PREWIRE IS USED ON THE 1BT HEATER, THE #28, #47, #51, #44, OR #22 PREWIRE OPTION MUST BE SELECTED. DO NOT PROVIDE SUPPLY STARTER IN PREWIRE.
		1	MOTORIZED BACKDRAFT DAMPER FOR A2-1 HOUSING - MEETS AMCA CLASS 1A RATING
		1	1BT/MUA EVAP INTERLOCK
		1	FREEZE PROTECTION DRAIN KIT FOR 1BT/MUA WITH EVAPORATIVE COOLERS
		1	1BT SIZE 1 & 2 SIDE DISCHARGE
		1	2 YEAR ENTIRE UNIT PARTS WARRANTY, 25 YEAR STAINLESS STEEL FURNACE PARTS WARRANTY


FAN ACCESSORIES

FAN UNIT NO	TAG	EXHAUST				SUPPLY						
		GREASE CUP	GRAVITY DAMPER	WALL MOUNT	SIDE DISCHARGE	GRAVITY DAMPER	MOTORIZED DAMPER	WALL MOUNT				
1	KEF-1	YES										
2	KEF-2	YES										
3	MAU-1				YES		YES					

CURB ASSEMBLIES

NO	DN FAN	TAG	WEIGHT	ITEM	SIZE
1	# 1	KEF-1	48 LBS	CURB	31.500"W X 31.500"L X 20.000"H ALONG LENGTH, RIGHT VENTED HINGED.
2	# 2	KEF-2	29 LBS	CURB	17.500"W X 17.500"L X 20.000"H ALONG LENGTH, RIGHT VENTED HINGED.
3	# 3	MAU-1	117 LBS	CURB	31.000"W X 79.000"L X 20.000"H ALONG WIDTH, RIGHT INSULATED.
	# 3			RAIL	6.000"W X 31.000"L X 20.000"H RIGHT.
	# 3			RAIL	4.000"W X 4.000"L X 36.000"H RIGHT.

FAN #1 DU240HFA - EXHAUST FAN (KEF-1)

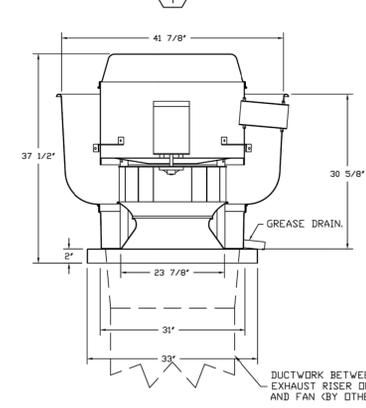


TOP VIEW

- FEATURES:**
- DIRECT DRIVE CONSTRUCTION (NO BELTS/PULLEYS).
 - ROOF MOUNTED FANS.
 - RESTAURANT MODEL.
 - UL705 AND UL762 AND UL-C-5645
 - VARIABLE SPEED CONTROL.
 - INTERNAL WIRING.
 - THERMAL OVERLOAD PROTECTION (SINGLE PHASE).
 - HIGH HEAT OPERATION 300°F (149°C).
 - GREASE CLASSIFICATION TESTING.
 - NEMA 3R SAFETY DISCONNECT SWITCH.

NORMAL TEMPERATURE TEST
EXHAUST FAN MUST OPERATE CONTINUOUSLY WHILE EXHAUSTING AIR AT 300°F (149°C) UNTIL ALL FAN PARTS HAVE REACHED THERMAL EQUILIBRIUM AND WITHOUT ANY DETERIORATING EFFECTS TO THE FAN WHICH WOULD CAUSE UNSAFE OPERATION.


ABNORMAL FLARE-UP TEST
EXHAUST FAN MUST OPERATE CONTINUOUSLY WHILE EXHAUSTING BURNING GREASE VAPORS AT 600°F (316°C) FOR A PERIOD OF 15 MINUTES WITHOUT THE FAN BECOMING DAMAGED TO ANY EXTENT THAT COULD CAUSE AN UNSAFE CONDITION.

- OPTIONS**
- GREASE BOX.
 - 2 YEAR PARTS WARRANTY.

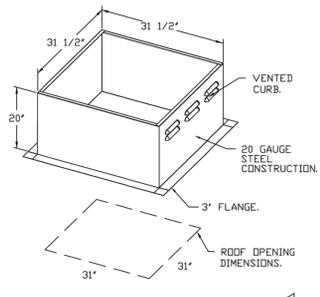

PITCHED CURBS ARE AVAILABLE FOR PITCHED ROOFS.
SPECIFY PITCH:
EXAMPLE: 7/12 PITCH = 30° SLOPE.

FAN #2 DUI2HFA - EXHAUST FAN (KEF-2)

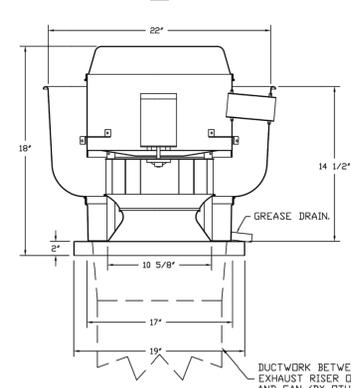


TOP VIEW

- FEATURES:**
- DIRECT DRIVE CONSTRUCTION (NO BELTS/PULLEYS).
 - ROOF MOUNTED FANS.
 - RESTAURANT MODEL.
 - UL705 AND UL762 AND UL-C-5645
 - VARIABLE SPEED CONTROL.
 - INTERNAL WIRING.
 - THERMAL OVERLOAD PROTECTION (SINGLE PHASE).
 - HIGH HEAT OPERATION 300°F (149°C).
 - GREASE CLASSIFICATION TESTING.
 - NEMA 3R SAFETY DISCONNECT SWITCH.

NORMAL TEMPERATURE TEST
EXHAUST FAN MUST OPERATE CONTINUOUSLY WHILE EXHAUSTING AIR AT 300°F (149°C) UNTIL ALL FAN PARTS HAVE REACHED THERMAL EQUILIBRIUM AND WITHOUT ANY DETERIORATING EFFECTS TO THE FAN WHICH WOULD CAUSE UNSAFE OPERATION.

ABNORMAL FLARE-UP TEST
EXHAUST FAN MUST OPERATE CONTINUOUSLY WHILE EXHAUSTING BURNING GREASE VAPORS AT 600°F (316°C) FOR A PERIOD OF 15 MINUTES WITHOUT THE FAN BECOMING DAMAGED TO ANY EXTENT THAT COULD CAUSE AN UNSAFE CONDITION.

- OPTIONS**
- GREASE BOX.
 - ECM WIRING PACKAGE - EXHAUST - MANUAL DR 0-10VDC REFERENCE SPEED CONTROL -MSC-(TELCD), CCW ROTATION.
 - 2 YEAR PARTS WARRANTY.

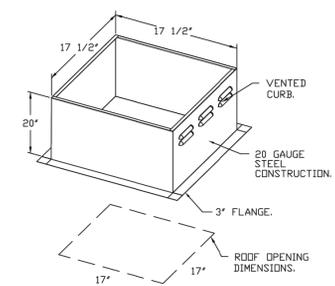

PITCHED CURBS ARE AVAILABLE FOR PITCHED ROOFS.
SPECIFY PITCH:
EXAMPLE: 7/12 PITCH = 30° SLOPE.




These products and others are available for demonstration at the Northern CA display center --For more information or questions Contact--
Captive Air Systems
1110 Burnett Ave, Suite G, Concord, CA 94520
Phone: (925)962-1999, Fax (925)566-8565
Email reg92@captiveaire.com

- FAN #3 AB-1BT-200-200 - HEATER (MAU-1)
- INDIRECT BENT TUBE GAS FURNACE HEATER WITH 20" MIXED FLOW DIRECT DRIVE FAN, 1 FURNACE, ELECTRONIC FULL MODULATION, CONSTANT BOX EFFICIENCY, AND 6:1 MAX TURNDOWN FOR NG, (5:1 MAX TURNDOWN FOR LP). STAINLESS STEEL BURNER AND HEAT EXCHANGER.
 - EVAP COOLER (LPD CELDEK) - W/INTAKE HOOD W/EZ FILTERS.
 - SIDE DISCHARGE - AIR FLOW RIGHT -> LEFT.
 - GAS PRESSURE GAUGE, 0-35", 2.5" DIAMETER, 1/4" THREAD SIZE, REAR THREAD.
 - GAS PRESSURE GAUGE, 0 TO 10 INCHES WC, 2.5" DIAMETER, 1/8" THREAD SIZE, REAR THREAD.
 - SEPARATE 120V ELECTRICAL CONNECTION FOR ALL 1BT HEATERS WITH 1 MODULE FOR STANDING POWER. 120V MUST BE RUN BY ELECTRICIAN FROM BUILDING PANEL TO MA SWITCH.
 - MOTORIZED BACK-BRAKT DAMPER 22.75" X 24" FOR SIZE 2 STANDARD & MODULAR HEATER UNITS W/EXTENDED SHAFT, STANDARD GALVANIZED CONSTRUCTION, 3/4" REAR FLANGE, LDW LEAKAGE, LF120S ACTUATOR INCLUDED.
 - LAYER CONTROL FOR 1BT EVAP.
 - FREEZE PROTECTION DRAIN CONTROL KIT FOR EVAPORATIVE COOLERS. INCLUDES 3-WAY WATER SOLENOID VALVE 83166064 (SHIPPED LOOSE), PRESSURE SWITCH INSTALLED UPSTREAM OF 2WAY SOLENOID IN UNIT, BRASS TEE AND 2 NPT HALF INCH NIPPLES. FIELD WIRING REQUIRED BY OTHERS FOR 3-WAY VALVE, FOR BOTH CELDEK AND STANDARD V-BANK TYPE CONFIGURATIONS.
 - USED WITH SIZE 1 AND SIZE 2 SIDE DISCHARGE 1BT MODULES.
 - HINGED DOUBLE WALL INSULATED DOOR ASSEMBLY (BURNER/BLOWER/EVAP SECTION).
 - 2 YEAR ENTIRE UNIT PARTS WARRANTY, 25 YEAR STAINLESS STEEL FURNACE PARTS WARRANTY
 - 1BT - US PATENT 877119 B2.

NOTE: SUPPLY DUCT MUST BE INSTALLED TO MEET SMACNA STANDARDS. A MINIMUM STRAIGHT DUCT LENGTH MUST BE MAINTAINED DOWNSTREAM OF UNIT DISCHARGE AS OUTLINED IN AMCA PUBLICATION 201. WHEN USING RECTANGULAR DUCTWORK, ELBOWS MUST BE RADIUS THROAT, RADIUS BACK WITH TURNING VANES. FLEXIBLE DUCTWORK AND SQUARE THROAT/SQUARE BACK ELBOWS SHOULD NOT BE USED. ANY TRANSITION AND/OR TURNS IN THE DUCTWORK WILL CAUSE SYSTEM EFFECT. SYSTEM EFFECT WILL DRAMATICALLY INCREASE STATIC PRESSURE AND REDUCE AIRFLOW. DO NOT RELY ON UNIT TO SUPPORT DUCT IN ANY WAY. FAILURE TO PROPERLY SIZE DUCTWORK MAY CAUSE SYSTEM EFFECTS AND REDUCE PERFORMANCE OF THE EQUIPMENT. SUGGESTED STRAIGHT DUCT SIZE IS 26" X 26".

SUPPLY SIDE HEATER INFORMATION:

WINTER TEMPERATURE = 34°F, TEMP. RISE = 41°F.
 BTUs CALCULATED OFF ACTUAL AIR DENSITY.
 OUTPUT BTU@ AT ALTITUDE OF 0.0 FT. = 153705.
 INPUT BTU@ AT ALTITUDE OF 0.0 FT. = 189759.
 OUTPUT BTU@ AT ALTITUDE OF 68 FT. = 133387.
 INPUT BTU@ AT ALTITUDE OF 68 FT. = 189293.

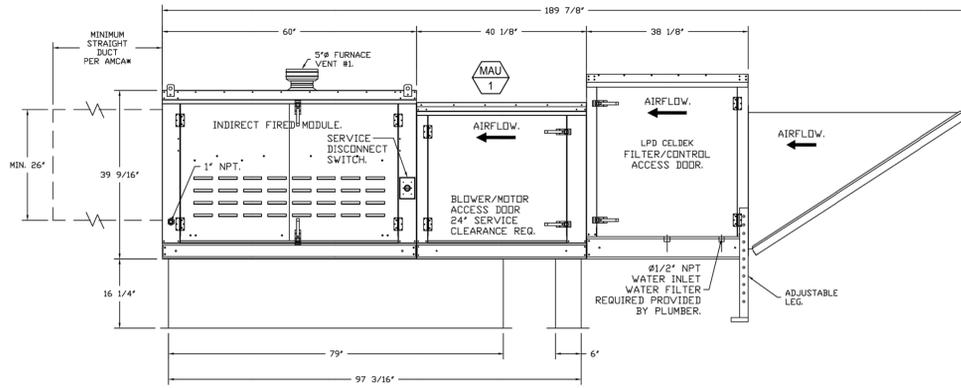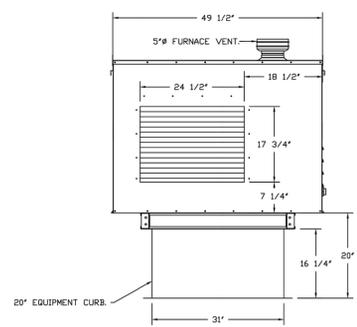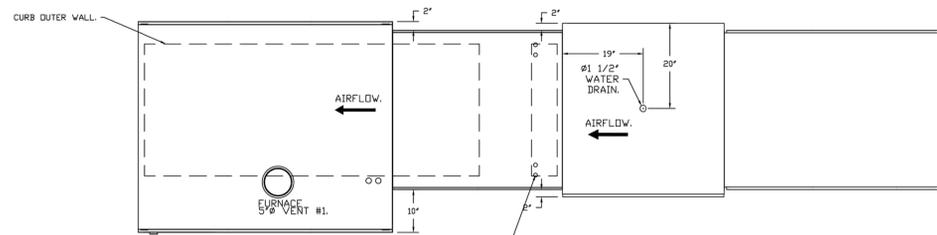

These products and others are available for demonstration at the Northern CA display center --For more information or questions Contact--
 Captive Air Systems
 1110 Burnett Ave, Suite G, Concord, CA 94520
 Phone: (925)966-1999, Fax: (925)966-8565
 Email: reg92@captiveaire.com

REVISIONS

NO.	DESCRIPTION	DATE

CAPTIVE AIR SYSTEMS
 www.captiveair.com
 Northern California Office
 1110 Burnett Ave, Suite G, Concord, CA, 94520 PHONE: (925) 962-1999 FAX: (925) 966-8566 EMAIL: reg92@captiveaire.com

Woodland Culinary Classroom
 575 Hays Street,
 Woodland, CA, 95695

DATE: 11/18/2022
 DWG.#: 5668673
 DRAWN BY:
 SCALE: 3/4" = 1'-0"
 MASTER DRAWING

SHEET NO. 4

APPROVALS

PO Box 1900
 Yuba City, CA 95992-1900
 530.298.7298
 www.spinc-arch.com

INTERNATIONAL • COMMERCIAL • RESIDENTIAL • INTERIOR • CONSTRUCTION MANAGEMENT

SYNTHESIS PARTNERS, LLC
 Managers • Architects

WESTON & ASSOCIATES
 MECHANICAL ENGINEERS
 601 UNIVERSITY AVE., SUITE 260 | SACRAMENTO, CA 95825
 WESTON & ASSOCIATES #22-033

OWNER
 Woodland Joint Unified School District
 435 6th Street
 Woodland, CA 95695

PROJECT
 CLASSROOM CONVERSIONS
 at
 WOODLAND EDUCATION CENTER
 575 Hays Street
 Woodland, CA 95695




KEY PLAN

MECHANICAL SCHEDULES & NOTES

DATE 2022-07-24
 PROJECT NO. 21-W04-01

M0.5

ELECTRICAL PACKAGE -- JOB#5668675												
NO	TAG	PACKAGE #	LOCATION	SWITCHES		OPTION	FANS CONTROLLED					
				LOCATION	QUANTITY		FAN TAG	TYPE	#	HP	VOLTS	FLA
1		DCV-1111	UTILITY CABINET RIGHT	04" UTILITY CABINET RIGHT	1 LIGHT	SMART CONTROLS DCV	KEF-1	EXHAUST	3	3.000	208	10.2
				HOOD # 1	1 FAN			SUPPLY	3	0.250	208	1.2

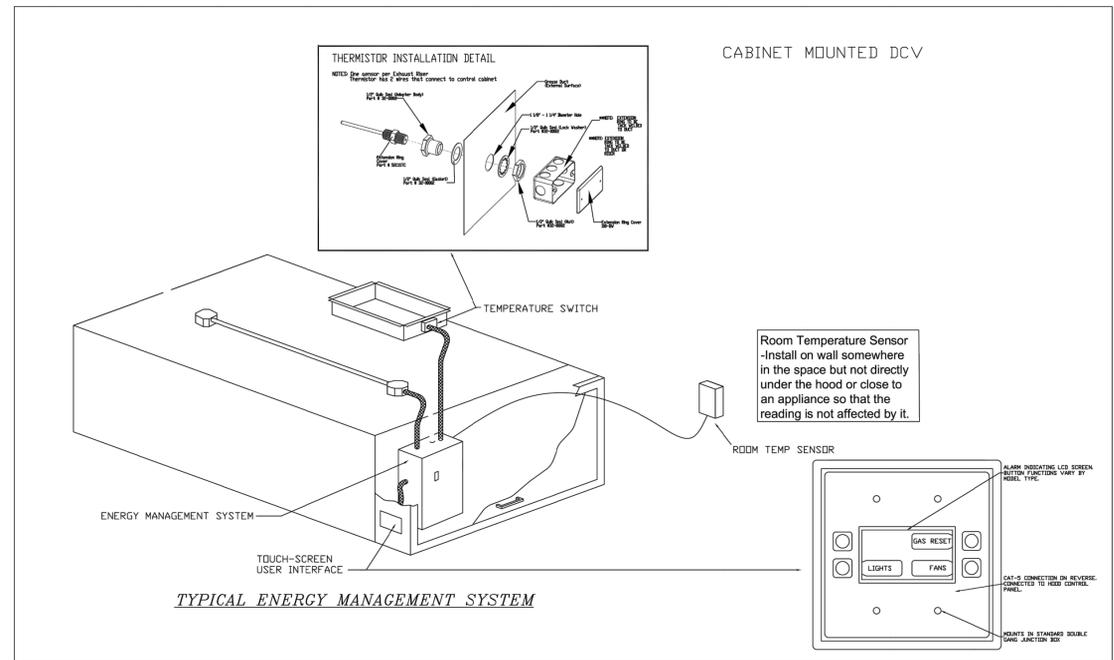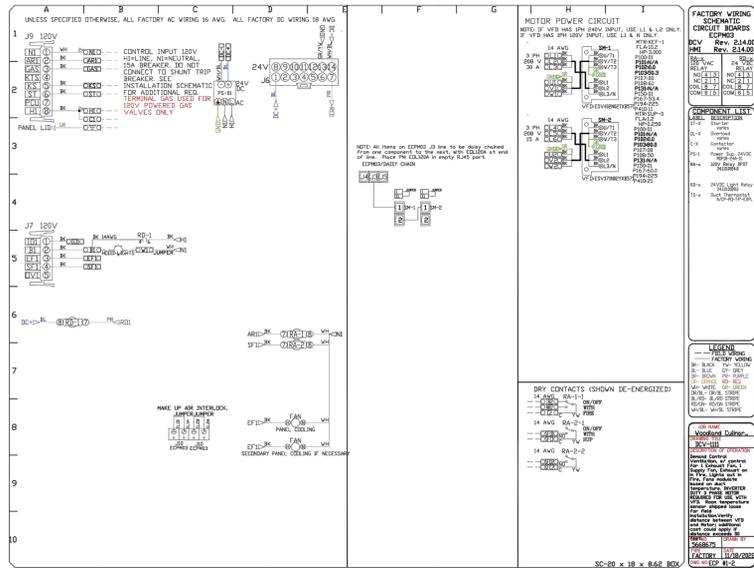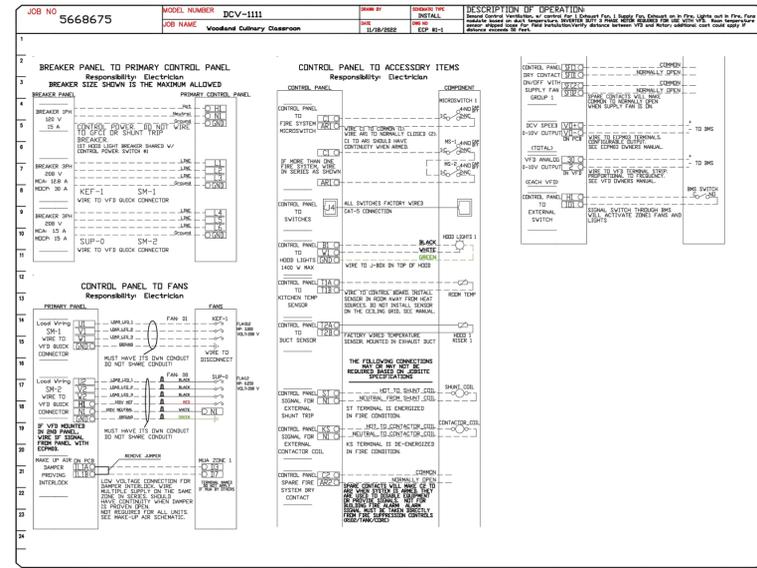

These products and others are available for demonstration at the Northern CA display center -- For more information or questions Contact--
 Captive Aire Systems
 1110 Burnett Ave, Suite G, Concord, CA 94520
 Phone: (925)962-1999, Fax: (925)566-8565
 Email: reg2@captiveaire.com

REVISIONS

NO.	DESCRIPTION	DATE

CAPTIVE AIRE
 Northern California Office
 1110 Burnett Ave, Suite G, Concord, CA 94520
 PHONE: (925) 962-1999 FAX: (925) 566-8565 EMAIL: reg2@captiveaire.com

Woodland Culinary Classroom
 575 Hays Street,
 Woodland, CA, 95695

DATE: 11/18/2022
DWG.#: 5668675
DRAWN BY:
SCALE: 3/4" = 1'-0"
MASTER DRAWING

SHEET NO.
 5

APPROVALS


PO Box 1900
 Yuba City, CA 95992-1900
 530.298.7298
 www.spinc-arch.com

SYNTHESIS PARTNERS, LLC
 Managers • Architects

WESTON & ASSOCIATES
 MECHANICAL ENGINEERS
 601 UNIVERSITY AVE., SUITE 200 | SACRAMENTO, CA 95825
 WESTON & ASSOCIATES #22-033

OWNER
 Woodland Joint Unified School District
 435 6th Street
 Woodland, CA 95695

PROJECT
 CLASSROOM CONVERSIONS
 at
 WOODLAND EDUCATION CENTER
 575 Hays Street
 Woodland, CA 95695

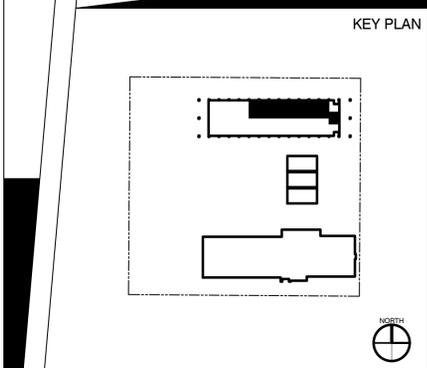

FOR PEAN REVIEW ONLY
NOT FOR CONSTRUCTION


RENEWAL DATE: 12/31/2023

NO.	REVISION DESCRIPTION	DATE

MECHANICAL SCHEDULES & NOTES



M0.6

DATE: 2022-07-24
PROJECT NO.: 21-W04-01

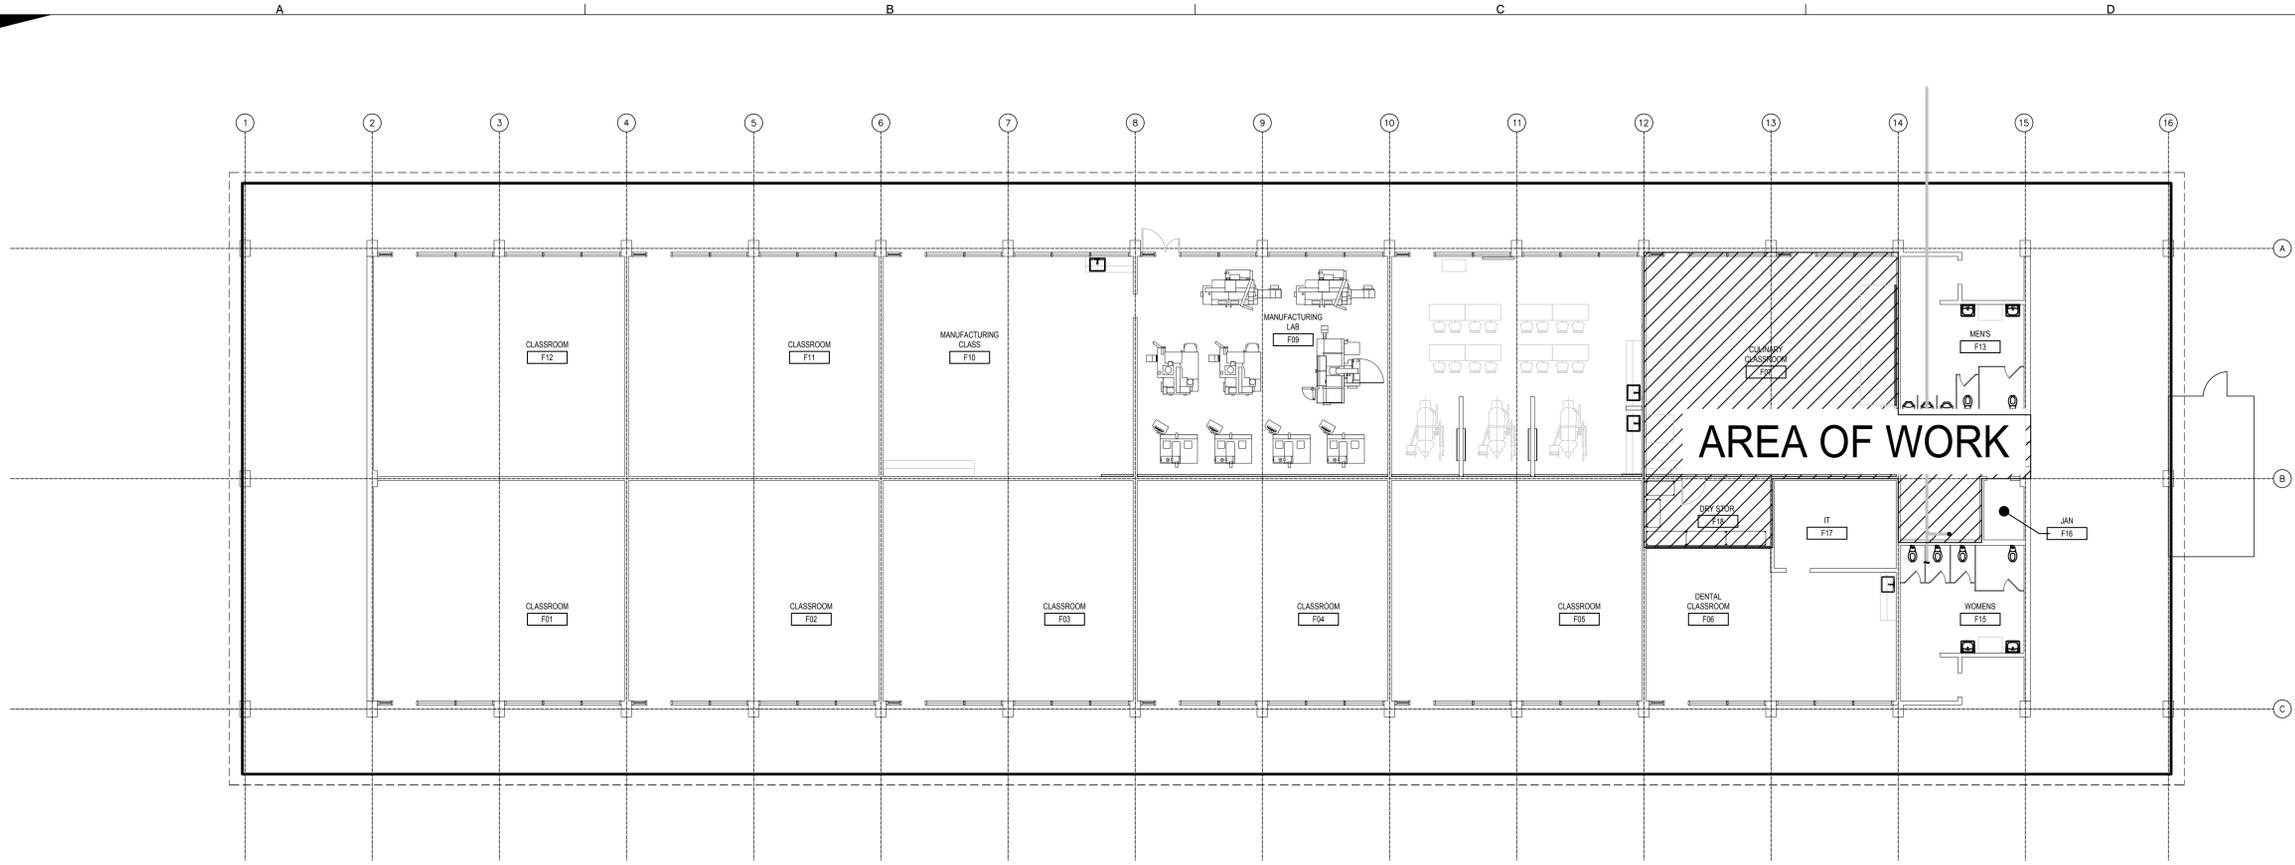


OVERALL MECHANICAL FLOOR PLAN

SCALE: 3/32" = 1'-0"

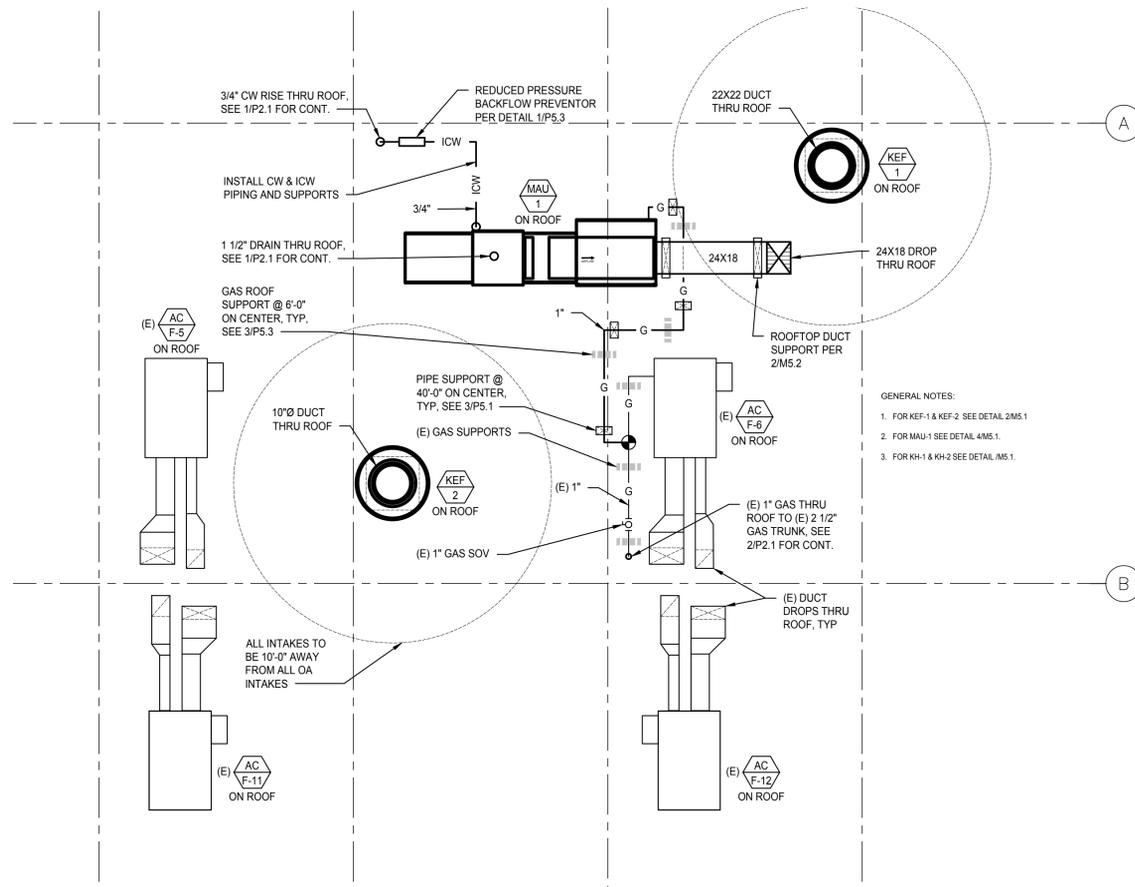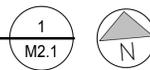


PARTIAL MECHANICAL ROOF PLAN

SCALE: 3/16" = 1'-0"

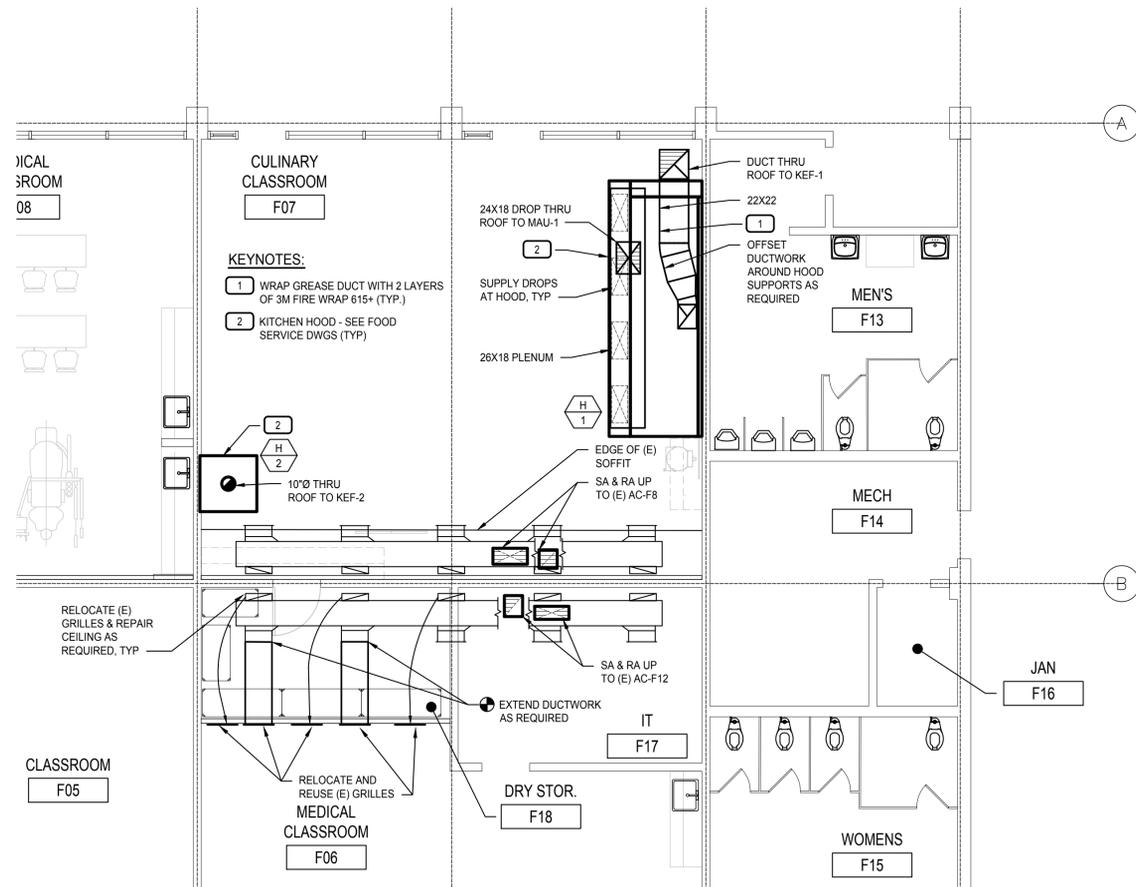

PARTIAL MECHANICAL FLOOR PLAN

SCALE: 3/16" = 1'-0"

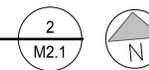

©2023 Synthesis Partners, LLC All Rights Reserved
 These record drawings have been prepared based upon information submitted, in part, by others. While this information is believed to be reliable, the Architect is not responsible for any errors or omissions which may be present in these documents as a result.

PO Box 1900
 Yuba City, CA 95992-1900
 530.298.7298
 www.spinc-arch.com

ARCHITECTURAL • COMMERCIAL • RESIDENTIAL • INTERIOR • CONSTRUCTION MANAGEMENT



SYNTHESIS PARTNERS, LLC
 Managers • Architects

WESTON & ASSOCIATES
 MECHANICAL ENGINEERS
 601 UNIVERSITY AVE., SUITE 260 | SACRAMENTO, CA 95825
 WESTON & ASSOCIATES #22-033


OWNER

Woodland Joint Unified School District
 435 6th Street
 Woodland, CA 95695

PROJECT

CLASSROOM CONVERSIONS
 at
 WOODLAND EDUCATION CENTER
 575 Hays Street
 Woodland, CA 95695

KEY PLAN

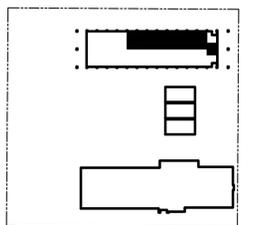

NO.	REVISION DESCRIPTION	DATE

MECHANICAL OVERALL PLAN & PARTIAL PLANS

DATE: 2022-07-24
 PROJECT NO.: 21-W04-01


M2.1

A

B


C

D

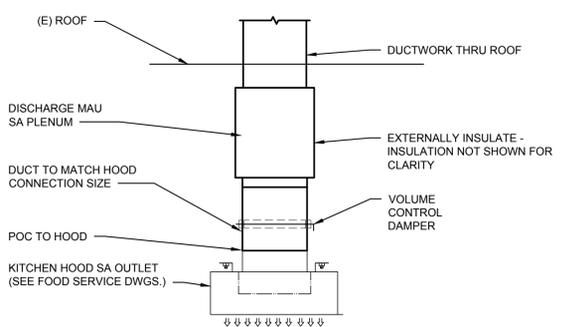



DUCT DROP FROM MAU UNIT ON ROOF DETAIL

3
M5.1

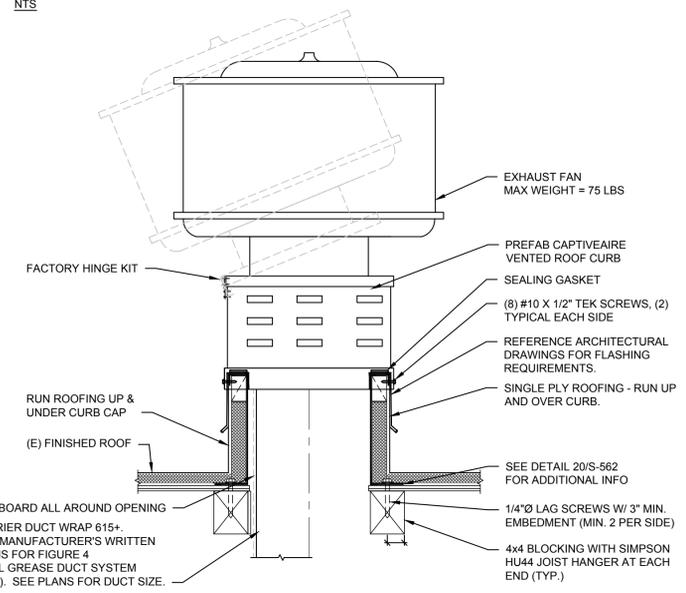

ROOF TOP EXHAUST FAN DETAIL

2
M-602

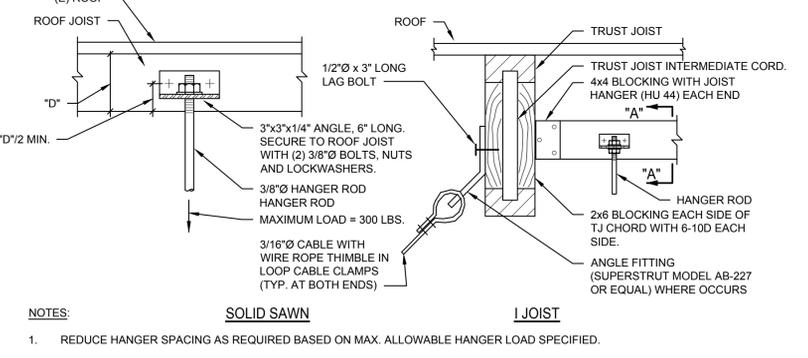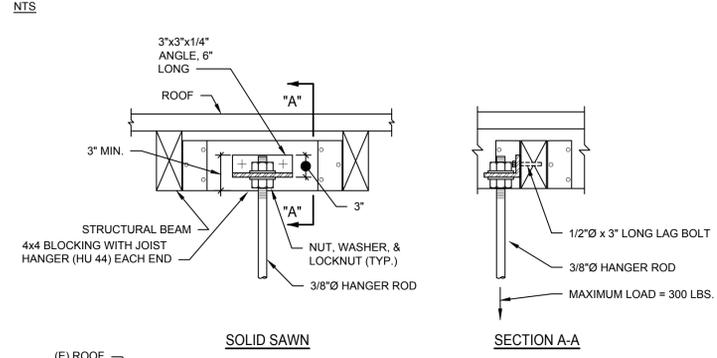

MAKE UP AIR UNIT MOUNTING

4
M5.1

HANGER ROD SUPPORT DETAILS

1
M5.1

©2023 Synthesis Partners, LLC All Rights Reserved
These record drawings have been prepared based upon information submitted, in part, by others. While this information is believed to be reliable, the Architect is not responsible for any errors or omissions which may appear hereon. These documents are a result.

PO Box 1900
Yuba City, CA 95992-1900
530.298.7298
www.spinc-arch.com

ARCHITECTURAL • COMMERCIAL • RESIDENTIAL • INTERIOR • CONSTRUCTION MANAGEMENT



SYNTHESIS PARTNERS, LLC
Managers • Architects



WESTON & ASSOCIATES
MECHANICAL ENGINEERS
601 UNIVERSITY AVE., SUITE 260 | SACRAMENTO, CA 95825
WESTON & ASSOCIATES #22-033


OWNER

Woodland Joint Unified School District
435 6th Street
Woodland, CA 95695

PROJECT

CLASSROOM CONVERSIONS
at
WOODLAND EDUCATION CENTER
575 Hays Street
Woodland, CA 95695

KEY PLAN

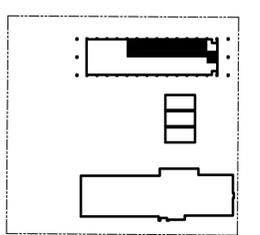

NO.	REVISION DESCRIPTION	DATE

MECHANICAL DETAILS

M5.1

DATE: 2022-07-24
PROJECT NO.: 21-W04-01


3M™ Fire Barrier Duct Wrap 615+ Commercial Kitchen Grease Duct Systems (Figure 1)

1- or 2-Hour Shaft Alternative Zero Clearance to Combustibles
Telescoping Wrap Technique With Banding For Ducts 24" (60.9cm) or Less

1. First layer 3M™ Fire Barrier Duct Wrap 615+
2. Second layer 3M™ Fire Barrier Duct Wrap 615+
3. 3/4" (19mm) wide filament tape
4. Steel banding 1/2" (12.7mm) wide min. typical for permanent fastening
5. Longitudinal joint butt or min. 3" (76.2mm) overlap on inner layer, min. 3" (76.2mm) overlap on outer layer
6. Perimeter (lateral) joint butt or min. 3" overlap (76.2mm) on inner layer, min. 3" (76.2mm) overlap on outer layer
7. Metallic commercial cooking exhaust duct

Note: System integrity is limited by quality of installation. Ducts ≥ 24" (60.9cm) wide require pinning on the bottom side of horizontal ducts and on a minimum of one of the wider sides of a vertical duct. Vertical ducts require pinning on all sides > 48" (121.8cm).

Note: See manufacturer installation instructions for additional information.

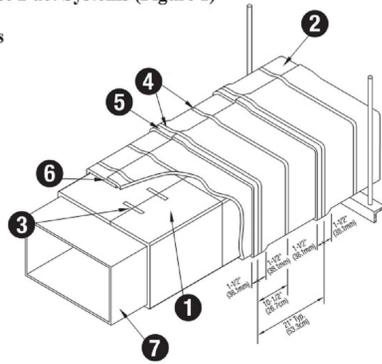


GENERAL NOTES:

1. 3M FIRE BARRIER DUCT WRAP 615+ CSFM 2440-0941:112.


3M FIRE WRAP DETAIL

NTS

5
M5.2

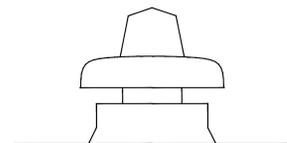

AC	EF
(E) AC-F6	KEF-2

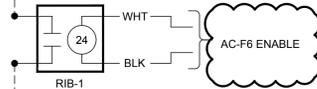

POWER BY E.C.

EXHAUST FAN INTERLOCKS
INTERLOCK SCHEDULE


GENERAL NOTES:

1. SEE PLANS AND SCHEDULES FOR QUANTITIES.
2. POWER BY DIVISION 23.
3. EF INTERLOCKED TO UNIT BY CONTROLS CONTRACTOR.
4. KEF-2 SHALL BE STARTED FROM HOOD SWITCH, KEF-2 SHALL BE INTERLOCKED TO (E) AC-F6.

EXHAUST FAN CONTROLS

NTS


4
M5.2

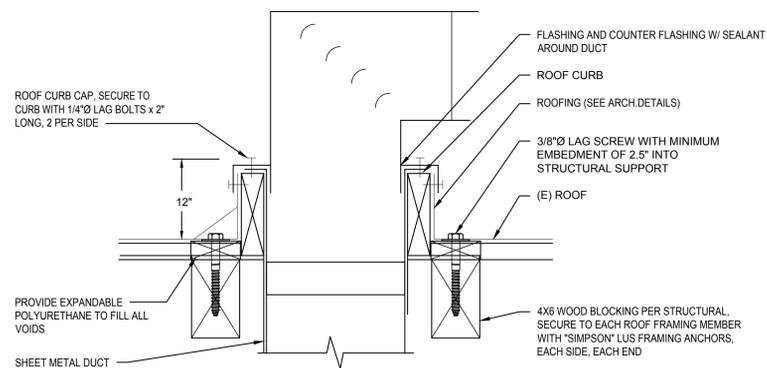


DUCT THRU ROOF DETAIL

NTS

3
M5.2

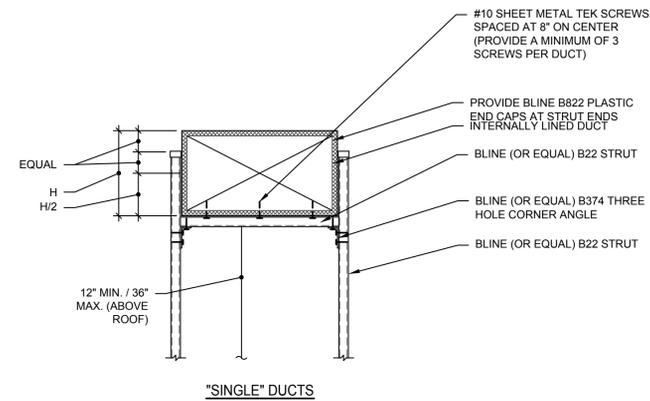

"SINGLE" DUCTS

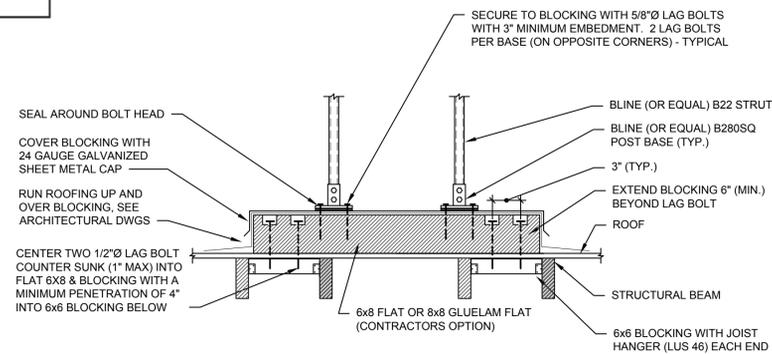


NOTES:

1. CONNECT STRUT/FITTINGS TOGETHER WITH MANUFACTURERS HEX SCREWS AND STANDARD NUTS (WITHOUT SPRINGS). PROVIDE LOCK WASHER AT EACH CONNECTION.
2. MAXIMUM SPACING BETWEEN SUPPORTS TO BE 6'-0".

DUCT SUPPORT ON WOOD DECK ROOF DETAIL

NTS

2
M5.2

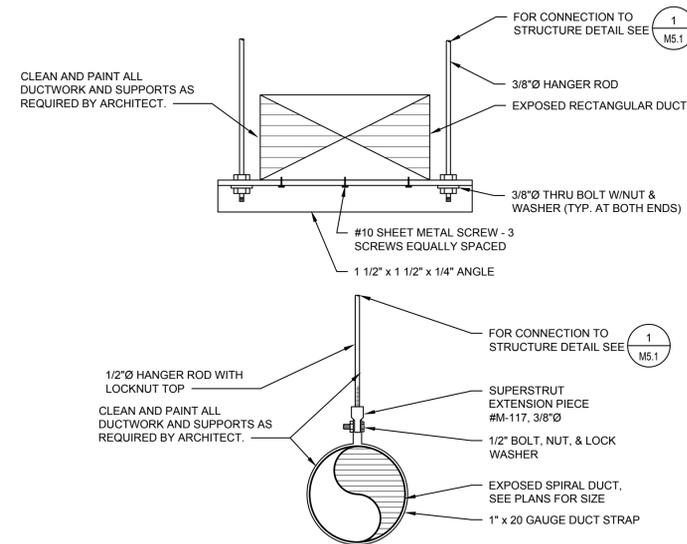

NOTES:

1. MAXIMUM SPACING OF SUPPORTS TO BE 10'-0".

EXPOSED DUCT MOUNTING DETAIL

SCALE: NONE

1
M5.2

©2023 Synthesis Partners, LLC All Rights Reserved
These record drawings have been prepared based upon information submitted, in part, by others. While this information is believed to be reliable, the Architect is not responsible for any errors or omissions which may appear hereon. These documents are a result.

PO Box 1900
Yuba City, CA 95992-1900
530.298.7298
www.spinc-arch.com



SYNTHESIS PARTNERS, LLC
Managers · Architects



WESTON & ASSOCIATES
MECHANICAL ENGINEERS

601 UNIVERSITY AVE., SUITE 260 | SACRAMENTO, CA 95825
WESTON & ASSOCIATES #22-033


OWNER

Woodland Joint Unified School District
435 6th Street
Woodland, CA 95695

PROJECT

CLASSROOM CONVERSIONS
at
WOODLAND EDUCATION CENTER
575 Hays Street
Woodland, CA 95695

KEY PLAN

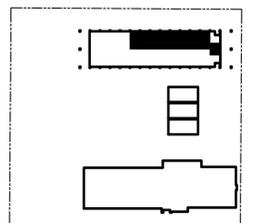

NO.	REVISION DESCRIPTION	DATE

MECHANICAL DETAILS

M5.2

DATE: 2022-07-24
PROJECT NO.: 21-W04-01

STATE OF CALIFORNIA
Process Systems
 NRC-PRC-E CALIFORNIA ENERGY COMMISSION
 NRC-PRC-E

CERTIFICATE OF COMPLIANCE
 This document demonstrates compliance for process systems that are within the scope of the permit application and are regulated by mandatory requirements in §120.6 or prescriptive requirements in §140.9. This compliance document is used for newly constructed, addition and alteration projects.
 Project Name: Woodland Joint USD Kitchen Title 24 Report Page: (Page 1 of 3)
 Project Address: 435 6th Street Date Prepared: 11/28/2022

A. GENERAL INFORMATION
 01 Project Location (city): Woodland
 02 Climate Zone: 12
 03 Occupancy Types Within Project:
 Office Retail Non-refrigerated Warehouse
 Hotel/ Motel School Healthcare Facility
 High-Rise Residential Relocatable Class Bldg Other (write in)

B. PROJECT SCOPE
 This table includes process systems that are within the scope of the permit application and are demonstrating compliance with mandatory requirements in §120.6 or prescriptive requirements in §140.9.
 My project consists of (check all that apply):
 Refrigerated Spaces <3,000 ft² Total (no Title 24, P16 requirements) Elevator Lighting & Ventilation Controls (mandatory §120.6(f))
 Refrigerated Spaces >=3,000 ft² Total (mandatory §120.6(a)) Escalator & Moving Walkway Speed Controls (mandatory §120.6(g))
 Food Stores >8,000 ft² cda (mandatory §120.6(b)) Computer Rooms >20 WJ/ ft² Power Density (prescriptive §140.9(a))¹
 Enclosed Parking Garage Exhaust >=10,000 cfm (mandatory §120.6(c)) Commercial Kitchen Ventilation/Exhaust (prescriptive §140.9(b))¹
 Newly Installed Process Boilers (mandatory §120.6(d)) Laboratory Exhaust/Factory Exhaust & Fume Hood (prescriptive §140.9(c))¹
 Compressed Air Systems Combined HP >= 25 (mandatory §120.6(e))

¹ FOOTNOTES: These building features can comply using the performance method. If using the performance method for these features, compliance should be demonstrated on the NRC-PRC-E.

Registration Number: CA Building Energy Efficiency Standards - 2019 Nonresidential Compliance
 Registration Date/Time: Report Version: 2019.1.003 Schema Version: rev 20200601
 Registration Provider: Energysoft
 Report Generated: 2022-11-28 13:23:21

STATE OF CALIFORNIA
Process Systems
 NRC-PRC-E CALIFORNIA ENERGY COMMISSION
 NRC-PRC-E

CERTIFICATE OF COMPLIANCE
 This document demonstrates compliance for process systems that are within the scope of the permit application and are regulated by mandatory requirements in §120.6 or prescriptive requirements in §140.9. This compliance document is used for newly constructed, addition and alteration projects.
 Project Name: Woodland Joint USD Kitchen Title 24 Report Page: (Page 2 of 3)
 Project Address: 435 6th Street Date Prepared: 11/28/2022

C. COMPLIANCE RESULTS
 Results in this table are automatically calculated from data input and calculations in Tables F through O. Note: If any cell on this table says "COMPLIES with Exceptional Conditions" refer to Table D. Exceptional Conditions for guidance or see applicable Table referenced below.

01	02	03	04	05	06	07	08	09	10	11
Refrigerated Warehouse/Space §120.6(a) (See Table F)	Commercial Refrigeration §120.6(b) (See Table G)	Parking Garage Exhaust §120.6(c) (See Table H)	Process Boilers §120.6(d) (See Table I)	Compressed Air Systems §120.6(e) (See Table J)	Elevators §120.6(f) (See Table K)	Escalators & Moving Walkways §120.6(g) (See Table L)	Computer Rooms §140.9(a) (See Table M)	Commercial Kitchens §140.9(b) (See Table N)	Laboratory/Factory Exhaust §140.9(c) (See Table O)	COMPLIES

D. EXCEPTIONAL CONDITIONS
 This table is auto-filled with uneditable comments because of selections made or data entered in tables throughout the form.

E. ADDITIONAL REMARKS
 This table includes remarks made by the permit applicant to the Authority Having Jurisdiction.

F. REFRIGERATED WAREHOUSES/SPACES
 This section does not apply to this project.

G. COMMERCIAL REFRIGERATION
 This section does not apply to this project.

H. ENCLOSED PARKING GARAGE EXHAUST
 This section does not apply to this project.

I. PROCESS BOILER
 This section does not apply to this project.

J. COMPRESSED AIR SYSTEMS
 This section does not apply to this project.

Registration Number: CA Building Energy Efficiency Standards - 2019 Nonresidential Compliance
 Registration Date/Time: Report Version: 2019.1.003 Schema Version: rev 20200601
 Registration Provider: Energysoft
 Report Generated: 2022-11-28 13:23:21

STATE OF CALIFORNIA
Process Systems
 NRC-PRC-E CALIFORNIA ENERGY COMMISSION
 NRC-PRC-E

CERTIFICATE OF COMPLIANCE
 This document demonstrates compliance for process systems that are within the scope of the permit application and are regulated by mandatory requirements in §120.6 or prescriptive requirements in §140.9. This compliance document is used for newly constructed, addition and alteration projects.
 Project Name: Woodland Joint USD Kitchen Title 24 Report Page: (Page 3 of 3)
 Project Address: 435 6th Street Date Prepared: 11/28/2022

K. ELEVATOR LIGHTING AND VENTILATION
 This section does not apply to this project.

L. ESCALATORS AND MOVING WALKWAYS SPEED CONTROLS
 This section does not apply to this project.

M. COMPUTER ROOM SYSTEM SUMMARY
 This section does not apply to this project.

N. COMMERCIAL KITCHEN EXHAUST AND VENTILATION
 This table contains all new and replacement hoods being installed within the scope of the permit application. Table N is used to demonstrate compliance with prescriptive requirements found in §140.9(b).
Kitchen Ventilation §140.9(b)2

01	02	03	04	05
<input type="checkbox"/>	Existing kitchen hoods not being replaced as part of an addition or alteration (do not need to meet requirements)			
		Requirements		
		Replacement Air to Hood Compliance Method §140.9(b)1A		
02		Providing replacement air directly to the hood(s) that does not exceed 10% of the hood(s) exhaust rate		
03		Mechanically cooled or heated makeup air delivered to any space with a kitchen hood is designed per 140.9(b)2A to not exceed the greater of: The hood exhaust flow minus the available transfer air from adjacent spaces		
04		Location that is supplying transfer air:		
05		The kitchen/ dining facility has a total Type I and Type II kitchen hood exhaust airflow > 5000 cfm and is designed to have one of the following per 140.9(b)2B: NA: Not a kitchen/ dining facility having a total Type I and Type II kitchen hood exhaust airflow rate > 5,000 cfm		

Registration Number: CA Building Energy Efficiency Standards - 2019 Nonresidential Compliance
 Registration Date/Time: Report Version: 2019.1.003 Schema Version: rev 20200601
 Registration Provider: Energysoft
 Report Generated: 2022-11-28 13:23:21

STATE OF CALIFORNIA
Domestic Water Heating System
 NRC-PLB-E CALIFORNIA ENERGY COMMISSION
 NRC-PLB-E

CERTIFICATE OF COMPLIANCE
 This document demonstrates compliance for domestic water heating systems that are within the scope of the permit application and are regulated by mandatory requirements in §120.3, §120.3, §150.0, §150.1, §150.2, §150.3, §150.4, §150.5, §150.6, §150.7, §150.8, §150.9, §150.10, §150.11, §150.12, §150.99, §150.100.
 Project Name: Woodland Joint USD Kitchen Title 24 Report Page: (Page 4 of 6)
 Project Address: 435 6th Street Date Prepared: 11/28/2022

G. DOMESTIC HOT WATER DISTRIBUTION SYSTEM
 This table is used to demonstrate compliance for nonresidential occupancies with the distribution requirements in §120.3 and §140.5. For high-rise residential and hotel/motel occupancies, compliance is demonstrated with requirements §110.3(a), §120.3, §150.0, §150.1, §150.2, §150.3, §150.4, §150.5, §150.6, §150.7, §150.8, §150.9, §150.10, §150.11, §150.12, §150.99, §150.100.
Mandatory Pipe Insulation All Occupancies
 For systems serving nonresidential spaces, pipe insulation for the following applications is specified to comply with Table 120.3-A (see below) per §120.3:
 • Recirculating system piping, including supply and return piping of the water heater
 • The first ft of hot and cold outlet piping, including between storage tank and heat trap, for a nonrecirculating system exposed
 • Pipes that are externally heated
 Insulation shall be protected from damage, including that due to sunlight, moisture, equipment maintenance, and wind. Insulation exposed to weather shall be installed with a cover suitable for outdoor service per §120.3(b) and §150.0(i).

Fluid Temperature Range (°F)	Conductivity Range (Btu-in per hour per ft ² per °F)	Insulation Mean Rating Temp (°F)	Nominal Pipe Diameter (in)		
			< 1	1 to < 1.5	1.5 to < 4
105-140	0.22 - 0.28	100	1.0 in or R-7.7	1.5 in or R-12.5	1.5 in or R-11

TABLE 120.3-A PIPE INSULATION THICKNESS

Fluid Temperature Range (°F)	Conductivity Range (Btu-in per hour per ft ² per °F)	Insulation Mean Rating Temp (°F)	Nominal Pipe Diameter (in)		
			< 1	1 to < 1.5	1.5 to < 4
105-140	0.22 - 0.28	100	1.0 in or R-7.7	1.5 in or R-12.5	1.5 in or R-11

Registration Number: CA Building Energy Efficiency Standards - 2019 Nonresidential Compliance
 Registration Date/Time: Report Version: 2019.1.003 Schema Version: rev 20200601
 Registration Provider: Energysoft
 Report Generated: 2022-11-28 13:23:21

STATE OF CALIFORNIA
Domestic Water Heating System
 NRC-PLB-E CALIFORNIA ENERGY COMMISSION
 NRC-PLB-E

CERTIFICATE OF COMPLIANCE
 This document demonstrates compliance for domestic water heating systems that are within the scope of the permit application and are regulated by mandatory requirements in §120.3, §120.3, §150.0, §150.1, §150.2, §150.3, §150.4, §150.5, §150.6, §150.7, §150.8, §150.9, §150.10, §150.11, §150.12, §150.99, §150.100.
 Project Name: Woodland Joint USD Kitchen Title 24 Report Page: (Page 5 of 6)
 Project Address: 435 6th Street Date Prepared: 11/28/2022

H. DOMESTIC HOT WATER CONTROLS
 This table is used to demonstrate compliance with control requirements in §110.3 for all occupancies. For high-rise residential and hotel/motel occupancies, compliance is also demonstrated with requirements in §150.1(c)(8).

01	02	03	04	05	06	07	08	09	10	11	Requirement	
											Yes	No
												Construction documents require manufacturer certification that service water-heating systems are equipped with automatic temperature controls capable of adjusting temperature settings per §110.3(a)
												Systems with capacity > 167,000 BTUH equipped with outlet temperature controls per §110.3(c)(1) unless covered by California Plumbing Code 613.0.
												Controls for circulating pumps or electrical heat trace systems are capable of automatically turning off the system per §110.3(c)(2) unless systems serve healthcare facility.
												For recirculation systems serving multiple dwelling units, design includes automatic pump controls per §150.1(c)(8)(B), or §150.2 for additions or alterations.
												For recirculation systems serving individual dwelling units, design includes manual on/off controls as specified in Reference Appendix RAA.4.9 per §150.1(c)(8).
												For replacement single heat pump water heaters serving individual dwelling units in climate zone 1-15, design includes communication interface that meets demand responsive control requirements of §110.12(a) per §150.2(b)(1)(H).

I. DECLARATION OF REQUIRED CERTIFICATES OF INSTALLATION
 Selections have been made based on information provided in this document. If any selection have been changed by permit applicant, an explanation should be included in Table E. Additional Remarks. These documents must be provided to the building inspector during construction and can be found online at https://www.energy.ca.gov/title24/2019standards/2019_compliance_documents/Nonresidential_Documents/NRC/

Form/Title	Field Inspector	
	Pass	Fail
NRCI-PLB-01-E - Must be submitted for all buildings	<input type="checkbox"/>	<input type="checkbox"/>

J. DECLARATION OF REQUIRED CERTIFICATES OF ACCEPTANCE
 There are no Certificates of Acceptance applicable to service water heating requirements.

K. DECLARATION OF REQUIRED CERTIFICATES OF VERIFICATION
 There are no NRCV forms required for this project.

Registration Number: CA Building Energy Efficiency Standards - 2019 Nonresidential Compliance
 Registration Date/Time: Report Version: 2019.1.003 Schema Version: rev 20200601
 Registration Provider: Energysoft
 Report Generated: 2022-11-28 13:23:21

STATE OF CALIFORNIA
Domestic Water Heating System
 NRC-PLB-E CALIFORNIA ENERGY COMMISSION
 NRC-PLB-E

CERTIFICATE OF COMPLIANCE
 This document demonstrates compliance for domestic water heating systems that are within the scope of the permit application and are regulated by mandatory requirements in §120.3, §120.3, §150.0, §150.1, §150.2, §150.3, §150.4, §150.5, §150.6, §150.7, §150.8, §150.9, §150.10, §150.11, §150.12, §150.99, §150.100.
 Project Name: Woodland Joint USD Kitchen Title 24 Report Page: (Page 6 of 6)
 Project Address: 435 6th Street Date Prepared: 11/28/2022

DOCUMENTATION AUTHOR'S DECLARATION STATEMENT
 I certify that this Certificate of Compliance documentation is accurate and complete.
 Documentation Author Name: Ryan Smith
 Signature Date: 2022-11-28
 Company: Weston & Associates Mechanical Engineers, Inc.
 Address: 601 University Suite 260
 City/State/Zip: Sacramento CA 95825
 Phone: (916) 482-0820

RESPONSIBLE PERSON'S DECLARATION STATEMENT
 I certify the following under penalty of perjury under the laws of the State of California:
 1. The information provided on this Certificate of Compliance is true and correct.
 2. I am eligible under Division 3 of the Business and Professions Code to accept responsibility for the building design or system design identified on this Certificate of Compliance (responsible designer).
 3. The energy features and performance specifications, materials, components, and manufactured devices for the building design or system design identified on this Certificate of Compliance conform to the requirements of Title 24, Part 1 and Part 6 of the California Code of Regulations.
 4. The building design features or system design features identified on this Certificate of Compliance are consistent with the information provided on other applicable compliance documents, worksheets, calculations, plans and specifications submitted to the enforcement agency for approval with this building permit application.
 5. I will ensure that a completed signed copy of this Certificate of Compliance shall be made available with the building permit(s) issued for the building, and made available to the enforcement agency for all applicable inspections. I understand that a completed signed copy of this Certificate of Compliance is required to be included with the documentation the builder provides to the building owner at occupancy.
 Responsible Designer Name: David Weston
 Signature Date: 2022-11-28
 Company: Weston & Associates
 Address: 601 University Ave, Suite 260
 City/State/Zip: Sacramento CA 95825
 Phone: (916) 482-0820

Registration Number: CA Building Energy Efficiency Standards - 2019 Nonresidential Compliance
 Registration Date/Time: Report Version: 2019.1.003 Schema Version: rev 20200601
 Registration Provider: Energysoft
 Report Generated: 2022-11-28 13:23:21

STATE OF CALIFORNIA
Domestic Water Heating System
 NRC-PLB-E CALIFORNIA ENERGY COMMISSION
 NRC-PLB-E

CERTIFICATE OF COMPLIANCE
 This document is used to demonstrate compliance for nonresidential occupancies with requirements in §110.1, §110.3, §120.3, and §140.5, and with requirements in §141.0 for additions and alterations, for domestic water heating scopes using the prescriptive path. For high-rise residential and hotel/motel occupancies compliance is demonstrated with requirements in §110.1, §110.3, §120.3, §150.0 and §150.1(c)(8), and with requirements §150.2 for additions.
 Project Name: Woodland Joint USD Kitchen Title 24 Report Page: (Page 1 of 6)
 Project Address: 435 6th Street Date Prepared: 11/28/2022

A. GENERAL INFORMATION
 01 Project Location (city): Woodland
 02 Climate Zone: 12
 03 Occupancy Types Within Project (select all that apply):
 Nonresidential High-Rise Residential Hotel/Motel
 State Building Healthcare Facility Other (Write in)

B. PROJECT SCOPE
 This table includes domestic water heating systems that are within the scope of the permit application and are demonstrating compliance using the prescriptive paths outlined in §140.5, §150.1(c)(8), and §141.0(a) or §141.0(b)(2) for additions or alterations. Solar water heating systems are documented on the NRC-SEA compliance document. Combined hydronic water heating systems are documented on the NRC-MCH compliance document.
 My project consists of (check all that apply):
 New system (DHW system being installed for the first time in newly constructed building) System Type^{1,2}
 System Alteration (equipment, distribution or controls) Individual System (serving nonresidential spaces) Equipment Distribution Controls
 System Alteration (equipment, distribution or controls) Equipment Distribution Controls
¹ FOOTNOTES: Point of use water heaters, or other non-central systems used to serve nonresidential spaces, are considered individual systems.
² Dwelling units refers to hotel/motel guest rooms and units in a high-rise residential occupancy.

Registration Number: CA Building Energy Efficiency Standards - 2019 Nonresidential Compliance
 Registration Date/Time: Report Version: 2019.1.003 Schema Version: rev 20200601
 Registration Provider: Energysoft
 Report Generated: 2022-11-28 13:23:21

STATE OF CALIFORNIA
Domestic Water Heating System
 NRC-PLB-E CALIFORNIA ENERGY COMMISSION
 NRC-PLB-E

CERTIFICATE OF COMPLIANCE
 This document is used to demonstrate compliance for nonresidential occupancies with requirements in §110.1, §110.3, §120.3, and §140.5, and with requirements in §141.0 for additions and alterations, for domestic water heating scopes using the prescriptive path. For high-rise residential and hotel/motel occupancies compliance is demonstrated with requirements in §110.1, §110.3, §120.3, §150.0 and §150.1(c)(8), and with requirements §150.2 for additions.
 Project Name: Woodland Joint USD Kitchen Title 24 Report Page: (Page 2 of 6)
 Project Address: 435 6th Street Date Prepared: 11/28/2022

C. COMPLIANCE RESULTS
 Table C will indicate if the project data input into the compliance document is compliant with water heating requirements. If this table says "DOES NOT COMPLY" or "COMPLIES with Exceptional Conditions" refer to Table D, or the table indicated as not compliant for guidance.

01	02	03	04
Domestic Hot Water Equipment	Distribution Systems	Controls	COMPLIES
Table F	Table G	Table H	
Yes	Yes	Yes	

D. EXCEPTIONAL CONDITIONS
 This table is auto-filled with uneditable comments because of selections made or data entered in tables throughout the form.

E. ADDITIONAL REMARKS
 This table includes remarks made by the permit applicant to the Authority Having Jurisdiction.

Registration Number: CA Building Energy Efficiency Standards - 2019 Nonresidential Compliance
 Registration Date/Time: Report Version: 2019.1.003 Schema Version: rev 20200601
 Registration Provider: Energysoft
 Report Generated: 2022-11-28 13:23:21

STATE OF CALIFORNIA
Domestic Water Heating System
 NRC-PLB-E CALIFORNIA ENERGY COMMISSION
 NRC-PLB-E

CERTIFICATE OF COMPLIANCE
 This document is used to demonstrate compliance for nonresidential occupancies with requirements in §110.1, §110.3, §120.3, and §140.5, and with requirements in §141.0 for additions and alterations, for domestic water heating scopes using the prescriptive path. For high-rise residential and hotel/motel occupancies compliance is demonstrated with requirements in §110.1, §110.3, §120.3, §150.0 and §150.1(c)(8), and with requirements §150.2 for addition and alteration scopes.
 Project Name: Woodland Joint USD Kitchen Title 24 Report Page: (Page 3 of 6)
 Project Address: 435 6th Street Date Prepared: 11/28/2022

N. COMMERCIAL KITCHEN EXHAUST AND VENTILATION
 Kitchen Exhaust: Airflow Rate §140.9(b)1B

01	02	03	04	05	06	07	08
Name or Item Tag	Hood Type ¹	Hood Style	Hood Length (ft)	Equipment Duty	Design Hood Exhaust Rate CFM	Max Hood Exhaust Rate Allowed CFM	
H-1	Type I	Wall-mounted Canopy	15	Heavy Duty	3600	4200	
H-2	Type II	Wall-mounted Canopy	4	Light Duty	540	501	

¹FOOTNOTES: Type II hoods do not have a max hood exhaust air rate per §140.9(b)1B

O. LABORATORY AND FACTORY EXHAUST AND FUME HOODS
 This section does not apply to this project.

P. DECLARATION OF REQUIRED CERTIFICATES OF INSTALLATION
 Selections have been made based on information provided in this document. If any selection have been changed by permit applicant, an explanation should be included in Table E. Additional Remarks: These documents must be provided to the building inspector during construction and can be found online at https://www.energy.ca.gov/title24/2019standards/2019_compliance_documents/Nonresidential_Documents/NRCC/

Form/Title	Field Inspector	
	Pass	Fail
NRCC-PRC-01-E - Covered Process	<input type="checkbox"/>	<input type="checkbox"/>

Q. DECLARATION OF REQUIRED CERTIFICATES OF ACCEPTANCE
 Selections have been made based on information provided in this document. If any selection have been changed by permit applicant, an explanation should be included in Table E. Additional Remarks: These documents must be provided to the building inspector during construction and must be completed through an Acceptance Test Technician Certification Provider (ATTCP). For more information visit: http://www.energy.ca.gov/title24/attcp/providers.html

Form/Title	Systems/Spaces To Be Field Verified	Field Inspector	
		Pass	Fail
NRCA-PRC-02-F Kitchen Exhaust	<input type="checkbox"/>	<input type="checkbox"/>	<input type="checkbox"/>

Registration Number: CA Building Energy Efficiency Standards - 2019 Nonresidential Compliance
 Registration Date/Time: Report Version: 2019.1.003
 Registration Provider: Energysoft
 Schema Version: rev 20200601
 Report Generated: 2022-11-28 13:23:21

DOCUMENTATION AUTHOR'S DECLARATION STATEMENT
 I certify that this Certificate of Compliance documentation is accurate and complete.

Documentation Author Name: Ryan Smith	Documentation Author Signature:
Company: Weston & Associates Mechanical Engineers, Inc.	Signature Date: 2022-11-28
Address: 601 University Suite 260	CEA/HERS Certification Identification (if applicable):
City/State/Zip: Sacramento CA 95825	Phone: (916) 482-0820

- RESPONSIBLE PERSON'S DECLARATION STATEMENT**
 I certify the following under penalty of perjury, under the laws of the State of California:
- The information provided on this Certificate of Compliance is true and correct.
 - I am eligible under Division 3 of the Business and Professions Code to accept responsibility for the building design or system design identified on this Certificate of Compliance (responsible designer).
 - The energy features and performance specifications, materials, components, and manufactured devices for the building design or system design identified on this Certificate of Compliance conform to the requirements of Title 24, Part 1, and Part 6 of the California Code of Regulations.
 - The building design features or system design features identified on this Certificate of Compliance are consistent with the information provided on other applicable compliance documents, worksheets, calculations, plans and specifications submitted to the enforcement agency for approval with this building permit application.
 - I will ensure that a completed signed copy of this Certificate of Compliance shall be made available with the building permit(s) issued for the building, and made available to the enforcement agency for all applicable inspections. I understand that a completed signed copy of this Certificate of Compliance is required to be included with the documentation the builder provides to the building owner at occupancy.

Responsible Designer Name: David Weston	Responsible Designer Signature:
Company: Weston & Associates	Date Signed: 2022-11-28
Address: 601 University Ave, Suite 260	License: M31220
City/State/Zip: Sacramento CA 95825	Phone: (916) 482-0820

Registration Number: CA Building Energy Efficiency Standards - 2019 Nonresidential Compliance
 Registration Date/Time: Report Version: 2019.1.003
 Registration Provider: Energysoft
 Schema Version: rev 20200601
 Report Generated: 2022-11-28 13:23:21

©2023 Synthesis Partners, LLC. All Rights Reserved.
 These record drawings have been prepared by others. While this information is believed to be reliable, the Architect is not responsible for any errors or omissions which may appear in these documents as a result.

APPROVALS
 PO Box 1900
 Yuba City, CA 95992-1900
 530.298.7298
 www.spinc-arch.com

ARCHITECTURAL • COMMERCIAL • RESIDENTIAL • INTERIOR • CONSTRUCTION MANAGEMENT




SYNTHESIS PARTNERS, LLC
 Managers • Architects



WESTON & ASSOCIATES
 MECHANICAL ENGINEERS
 601 UNIVERSITY AVE., SUITE 260 | SACRAMENTO, CA 95825
 WESTON & ASSOCIATES #22-033

OWNER
 Woodland Joint Unified School District
 435 6th Street
 Woodland, CA 95695

PROJECT
 CLASSROOM CONVERSIONS
 at
 WOODLAND EDUCATION CENTER
 575 Hays Street
 Woodland, CA 95695

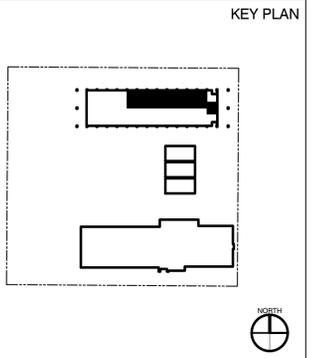

NO.	REVISION DESCRIPTION	DATE

TITLE 24 ENERGY COMPLIANCE
M8.2
 DATE: 2022-07-24
 PROJECT NO.: 21-W04-01

ANCHORAGE / BRACING NOTES

ALL MECHANICAL AND PLUMBING COMPONENTS SHALL BE ANCHORED AND INSTALLED PER THE DETAILS ON THE DSA APPROVED CONTRACT DOCUMENTS. WHERE NO DETAIL IS INDICATED, THE FOLLOWING COMPONENTS SHALL BE ANCHORED OR BRACED TO MEET THE FORCE AND DISPLACEMENT REQUIREMENTS PRESCRIBED IN THE 2019 CBC, SECTION 1617A.1.18 THROUGH 1617A.1.26 AND ASCE 7-16, CHAPTERS 13, 26 AND 30:

- ALL PERMANENT EQUIPMENT AND COMPONENTS.
- TEMPORARY, MOVABLE OR MOBILE EQUIPMENT THAT IS PERMANENTLY ATTACHED (E.G. HARD WIRED) TO THE BUILDING UTILITY SERVICES SUCH AS ELECTRICITY, GAS, OR WATER, "PERMANENTLY ATTACHED" SHALL INCLUDE ALL ELECTRICAL CONNECTION EXCEPT PLUGS FOR 110/220 VOLT RECEPTACLES HAVING A FLEXIBLE CABLE.
- TEMPORARY, MOVABLE OR MOBILE EQUIPMENT WHICH IS HEAVIER THAN 400 POUNDS OR HAS A CENTER OF MASS LOCATED 4 FEET OR MORE ABOVE THE ADJACENT FLOOR OR ROOF LEVEL THAT DIRECTLY SUPPORT THE COMPONENT IS REQUIRED TO BE RESTRAINED IN A MANNER APPROVED BY DSA.
- MOVABLE EQUIPMENT WHICH IS STATIONED IN ONE PLACE FOR MORE THAN 8 HOURS AND HEAVIER THAN 400 POUNDS OR HAS A CENTER MASS LOCATED 4 FEET OR MORE ABOVE THE ADJACENT FLOOR OR ROOF LEVEL THAT DIRECTLY SUPPORT THE COMPONENT ARE REQUIRED TO BE ANCHORED WITH TEMPORARY ATTACHMENTS.

THE FOLLOWING MECHANICAL COMPONENTS SHALL BE POSITIVELY ATTACHED TO THE STRUCTURE BUT NEED NOT DEMONSTRATE DESIGN COMPLIANCE WITH THE REFERENCES NOTED ABOVE. THESE COMPONENTS SHALL HAVE FLEXIBLE CONNECTIONS PROVIDED BETWEEN THE COMPONENT AND ASSOCIATED DUCTWORK AND PIPING. FLEXIBLE CONNECTION MUST ALLOW MOVEMENT IN BOTH TRANSVERSE AND LONGITUDINAL DIRECTIONS.

- COMPONENTS WEIGHING LESS THAN 400 POUNDS AND HAVING A CENTER OF MASS LOCATED 4 FEET OR LESS ABOVE THE ADJACENT FLOOR OR ROOF LEVEL THAT DIRECTLY SUPPORT THE COMPONENT.
- COMPONENTS WEIGHING LESS THAN 20 POUNDS, OR IN THE CASE OF DISTRIBUTED SYSTEMS, LESS THAN 5 POUNDS PER FOOT, WHICH ARE SUSPENDED FROM A ROOF OR FLOOR OR HUNG FROM A WALL.

THE ANCHORAGE OF ALL MECHANICAL AND PLUMBING COMPONENTS SHALL BE SUBJECT TO THE APPROVAL OF THE DESIGN PROFESSIONAL IN GENERAL RESPONSIBLE CHARGE OR STRUCTURAL ENGINEER DELEGATED RESPONSIBILITY AND ACCEPTANCE BY DSA. THE PROJECT INSPECTOR WILL VERIFY THAT ALL COMPONENTS AND EQUIPMENT HAVE BEEN ANCHORED IN ACCORDANCE WITH THE ABOVE REQUIREMENTS.

PIPING AND DUCTWORK SYSTEM BRACING NOTE:

PIPING AND DUCTWORK SHALL BE BRACED TO COMPLY WITH THE FORCE AND DISPLACEMENTS PRESCRIBED IN ASCE 7-16 SECTION 13.3 AS DEFINED IN ASCE 7-16 SECTION 13.6.5, 13.6.6, 13.6.7, 13.6.8, AND 2019 CBC, SECTIONS 1617A.1.24, 1617A.1.25, AND 1617A.1.26.

THE METHOD OF SHOWING BRACING AND ATTACHMENT TO THE STRUCTURE FOR THE IDENTIFIED DISTRIBUTION SYSTEM ARE AS NOTED BELOW. WHEN BRACING AND ATTACHMENTS ARE BASED ON A PRE APPROVED INSTALLATION GUIDE (E.G. SMACNA OR OSHPD OPM#), COPIES OF THE BRACING SYSTEM INSTALLATION GUIDE OR MANUAL SHALL BE AVAILABLE ON THE JOBSITE PRIOR TO THE START OF AND DURING THE HANGING AND BRACING OF THE DISTRIBUTION SYSTEMS. THE STRUCTURAL ENGINEER OF RECORD SHALL VERIFY THE ADEQUACY OF THE STRUCTURE TO SUPPORT THE HANGER AND BRACE LOADS.

PLUMBING PIPING (PP)

PP - OPTION 1:

DETAILED ON THE APPROVED DRAWINGS WITH PROJECT SPECIFIC NOTED AND DETAILS.

PP - OPTION 2:

SHALL COMPLY WITH THE APPLICABLE OSHPD PRE-APPROVAL (OPM#), MASON OPM-0043-13 SEISMIC RESTRAINT SYSTEMS GUIDELINE.

PLUMBING GENERAL NOTES

- MECHANICAL AND PLUMBING DETAILS APPLY TO ALL BUILDINGS WHETHER REFERENCED OR NOT.
- PROVIDE FIRE STOPPING ASSEMBLY PROTECTION FOR PIPE PENETRATIONS OF RATED ASSEMBLIES. FIRE STOP RATING SHALL MATCH RATED ASSEMBLY BEING PENETRATED.
- PLUMBING AND FIRE SPRINKLER PIPING SHALL OFFSET OVER OR UNDER DUCTS. COORDINATE WITH HEATING CONTRACTOR.
- PLUMBING CONTRACTOR TO OFFSET PIPING AROUND SKYLIGHTS.
- PLUMBING CONTRACTOR TO OFFSET PIPING AROUND ROOF ACCESS LADDERS.
- PIPING SHALL NOT PENETRATE INTO, OVER, OR THROUGH IT CLOSETS OR ELECTRICAL ROOMS UNLESS IT SERVES THAT SPECIFIC ROOM.
- DRAWINGS SHALL BE CONSIDERED DIAGRAMMATIC IN NATURE AND ARE NOT INTENDED TO SHOW EVERY OFFSET, FITTING, OR STRUCTURAL DIFFICULTY THAT MAY BE ENCOUNTERED DURING INSTALLATION OF WORK. THE CONTRACTORS SHALL COORDINATE LOCATION OF ALL PLUMBING PIPING WITH ALL OTHER TRADES ON THIS PROJECT. LOCATION OF ALL ITEMS NOT DEFINITELY FIXED BY DIMENSIONS ARE APPROXIMATE ONLY. EXACT LOCATIONS NECESSARY TO SECURE BEST CONDITIONS AND RESULTS MUST BE DETERMINED AT THE JOB SITE AND SHALL HAVE THE APPROVAL OF THE ARCHITECT BEFORE BEING INSTALLED.
- ALL VALVES SHALL BE FULL LINE SIZES UNLESS NOTED OTHERWISE.
- PROVIDE WALL CLEANOUT AT ALL SINKS, LAVATORIES, AND URINALS.
- PIPING SHALL BE SUPPORTED IN ACCORDANCE TO SMACNA "GUIDELINES FOR SEISMIC RESTRAINTS OF MECHANICAL AND PLUMBING PIPING SYSTEMS".
- ALL NEW SANITARY WASTE PIPING SHALL HAVE A MINIMUM BURRY DEPTH OF 18" AND BE SLOPED AT 1/4" PER FOOT MINIMUM UNLESS OTHERWISE NOTED. PIPING SHALL BE UNIFORMLY SLOPPED BETWEEN UPPER TERMINAL OF PIPE AND THE POINT OF CONNECTION TO THE SITE PIPING (AS INDICATED ON CIVIL PLANS) TO ACHIEVE MAXIMUM SLOPE POSSIBLE.
- ACCESS PANELS SHALL BE PROVIDED AS NECESSARY TO PROPERLY ACCESS THE PLUMBING SYSTEM INCLUDING VALVES, EQUIPMENT, HOPPER DRAINS, AND INDIRECT DRAINS IN WALLS.
- HVAC EQUIPMENT IS SHOWN FOR THE COORDINATION OF UTILITIES ONLY. REFER TO "M" SHEETS FOR ADDITIONAL INFORMATION.
- PROVIDE WATER HAMMER ARRESTORS (WHA) AT ALL FIXTURES AS INDICATED IN THE SPECIFICATIONS/NOTES. WHA SHALL BE SIZED AND PER THE PLUMBING & DRAINAGE INSTITUTE (PDI). WHA SHALL BE INSTALLED IN WALLS (NOT ABOVE CEILINGS).
- REFERENCE ARCHITECTURAL DRAWINGS FOR BUILDING DIMENSIONS, EXACT LOCATIONS OF PLUMBING FIXTURES, AND PLUMBING FIXTURE MOUNTING HEIGHTS.
- CONCEAL ALL PIPING IN WALL FURRINGS, PARTITIONS, ABOVE CEILINGS, EXCEPT IN MECHANICAL ROOMS OR WHERE NOTED OTHERWISE.
- PROVIDE A TRAP PRIMER AT ALL FLOOR DRAINS AND FLOOR SINKS.

APPLICABLE CODES

ALL WORK PERFORMED UNDER THIS CONTRACT IS TO CONFIRM TO THE FOLLOWING CODES AND REGULATIONS:

- CALIFORNIA ADMINISTRATIVE CODE, 2022
- CALIFORNIA BUILDING CODE, 2019
- CALIFORNIA MECHANICAL CODE, 2019
- CALIFORNIA PLUMBING CODE, 2019
- CALIFORNIA FIRE CODE, 2019
- CALIFORNIA ELECTRICAL CODE, 2019
- CALIFORNIA BUILDING ENERGY EFFICIENCY STANDARDS, 2019

THE ABOVE CODES AND REGULATIONS REFER TO THE LATEST EDITION OR REVISION IF FORCE ON THE DATE OF THE CONTRACT, UNLESS OTHERWISE STATED. NOTHING ON THE DRAWINGS IS TO BE CONSTRUED AS REQUIRING OR PERMITTING WORK THAT IS CONTRARY TO THE LISTED CODES AND REGULATIONS, OR OTHER LOCAL, STATE OR FEDERAL CODES OR REGULATIONS WHICH MAY BE APPLICABLE.

GAS PIPE SIZING

GAS LOAD (EACH) (MBH)	QUANTITY	TOTAL GAS LOAD (MBH)	DESCRIPTION
60	12	720	(E) AC-UNITS
190	1	190	MAU-1
76	1	76	GWH-1
OVERALL GAS DEMAND		986	
GAS MAIN SIZING AT 175' TOTAL DEVELOPED LENGTH			
GAS DEMAND (MBH)	PIPE SIZE	NOTES:	
63	3/4"	1. SEE FLOOR PLAN FOR EQUIPMENT LOCATIONS.	
119	1"		
244	1-1/4"		
366	1-1/2"		
704	2"		
1,120	2 1/2"		
1,980	3"		

GAS PIPE SIZING BASED ON TABLE 1215.2(1) CPC-2019 (PRESSURE DROP OF 1 PSI), 250 FOOT COLUMN. GPR OUTLET PRESSURE AT 7" WC. RUNOUTS TO APPLIANCES LESS THAN 6" SHALL BE SAME SIZE AS APPLIANCE CONNECTION. PROVIDE A SHUT-OFF VALVE AHEAD OF UNION AND WITHIN 3'-0" OF APPLIANCE CONNECTOR.

PLUMBING LEGEND

ABBREVIATIONS

ABC	ABOVE CEILING	FT	FEET	POD	POINT OF DISCONNECT
AD	ACCESS DOOR	FU	FIXTURE UNITS	PRV	PRESSURE REDUCING VALVE
AFB	ABOVE FINISHED FLOOR	G	NATURAL GAS	PS	PRESSURE SWITCH
AFG	ABOVE FINISHED GRADE	GOO	GRADE CLEAN OUT	PSI	POUNDS PER SQUARE INCH
AP	ACCESS PANEL	GD	GARBAGE DISPOSER	PSIG	POUNDS PER SQUARE INCH GAUGE
AQ	AQUASTAT	GLV	GLOBE VALVE	PT	PLUGGED TEE
ARCH	ARCHITECT	GM	GAS METER	R	RISE / RISER
AV	ACID VENT	GPH	GALLONS PER HOUR	RD	ROOF DRAIN
AVTR	ACID VENT THRU ROOF	GPM	GALLONS PER MINUTE	RET	RETURN
AW	ACID WASTE	GPR	GAS PRESSURE REGULATOR	RIO	ROUGH IN ONLY
BFF	BELOW FINISHED FLOOR	GPRV	GAS PRESSURE REGULATOR VALVE	RM	ROOM
BFP	BACKFLOW PREVENTER	GSCK	GAS COCK	RO	REVERSE OSMOSIS WATER
BFV	BUTTERFLY VALVE	GSV	GAS SEISMIC VALVE	RV	RELIEF VALVE
BG	BELOW GRADE	GV	GATE VALVE	RWL	RAINWATER LEADER
BLV	BALL VALVE	GW	GREASE WASTE PIPING	SCD	SECONDARY CONDENSATE DRAIN
CA	COMPRESSED AIR	HB	HOSE BIBB	SCH	SCHEDULE
CAP	CAPACITY	HD	HOPPER DRAIN	SCW	COLD SOFT WATER
CB	CATCH BASIN	HPG	HIGH PRESSURE NATURAL GAS	SD	STORM DRAIN
CBV	CALIBRATED BALANCE VALVE	HW	DOMESTIC HOT WATER	SH	SHOWER
CD	CONDENSATE DRAIN	HWR	DOMESTIC HOT WATER RETURN	SHT	SHEET
CFH	CUBIC FEET PER HOUR	ICW	INDUSTRIAL COLD WATER	SHW	HOT SOFT WATER
CI	CAST IRON	IHW	INDUSTRIAL HOT WATER	SHWR	HOT SOFT WATER RETURN
CKV	CHECK VALVE	IHWTR	INDUSTRIAL HOT WATER RETURN	SK	SINK
CL	CENTER LINE	ID	INSIDE DIAMETER	SMS	SHEET METAL SCREW
CLG	CEILING	IE	INVERT ELEVATION	SOV	SHUT OFF VALVE
CMP	CORRUGATED METAL PIPE	IW	INDIRECT WASTE	SS	STAINLESS STEEL
CO	CLEANOUT	LA	LABORATORY AIR	STD	STANDARD
CO2	CARBON DIOXIDE	LAV	LAVATORY	STR	STRAINER
COP	CAP ON END OF PIPE	LBS	POUNDS	TA	TO ABOVE
COTF	CLEANOUT TO FLOOR	LG	LABORATORY GAS	TB	TO BELOW
COTG	CLEANOUT TO GRADE	LP	LOW PRESSURE	TEMP.	TEMPERATURE
CP	CIRCULATING PUMP	LWT	LEAVING WATER TEMPERATURE	TH	THERMOMETER
CR	CONCENTRIC REDUCER	MA	MEDICAL AIR	TMV	THERMOSTATIC MIXING VALVE
CSK	CLINIC SINK	MAX	MAXIMUM	TP	TRAP PRIMER
CV	CONTROL VALVE	MFR	MANUFACTURER	TYP	TYPICAL
CW	DOMESTIC COLD WATER	MGC	MEDICAL GAS COLUMN	TW	TEMPERED WATER
D	DROP	MIN	MINIMUM	UC	UNDER COUNTER
DCW	DOMESTIC COLD WATER	MISC	MISCELLANEOUS	UF	UNDER FLOOR
DD	DECK DRAIN	MPG	MEDIUM PRESSURE NATURAL GAS	UG	UNDERGROUND
DET	DETAIL	(N)	NEW	UN	UNION OR FLANGE
DF	DRINKING FOUNTAIN	N2	NITROGEN	UNO	UNLESS NOTED OTHERWISE
DHW	DOMESTIC HOT WATER	N2O	NITROUS OXIDE	UR	URINAL
DHWR	DOMESTIC HOT WATER RETURN	NC	NORMALLY CLOSED	V	SANITARY VENT
DI	DEIONIZED WATER	NIC	NOT IN CONTRACT	VB	VALVE BOX
DN	DOWN	NO	NORMALLY OPEN	VAC	MEDICAL VACUUM
DWG	DRAWING	NTS	NOT TO SCALE	VR	VENT RISER
(E)	EXISTING	O2	OXYGEN	VTR	VENT THRU ROOF
EWH	ELECTRIC WATER HEATER	OC	ON CENTER	W	SANITARY WASTE
EWT	ENTERING WATER TEMPERATURE	OFCI	OWNWER FURNISHED CONTRACTOR INSTALLED	WD	WASTE DROP
FA	FROM ABOVE	ORD	OVERFLOW ROOF DRAIN	WI	WITH
FB	FROM BELOW	ORWL	OVERFLOW RAIN WATER LEADER	WIO	WITHOUT
FC	FLEXIBLE CONNECTION	OH	OVERHEAD	WAGD	WASTE ANESTHESIA GAS DISPOSAL
FCO	FLOOR CLEAN OUT	P&TRV	PRESSURE & TEMPERATURE RELIEF VALVE PIPING	WC	WATER CLOSET
FD	FLOOR DRAIN	PL	PROPERTY LINE	WCO	WALL CLEAN OUT
FHC	FIRE HOSE RACK & CABINET	PAN	PIPE ANCHOR	WD	WASTE DROP
FLR	FLOOR	PG	PRESSURE GAUGE	WH	WALL HYDRANT
FPM	FEET PER MINUTE	PL	PLATE	WHA	WATER HAMMER ARRESTER
FSH	FIRE SPRINKLER HEAD	PLBG	PLUMBING	WM	WATER METER
FS	FLOOR SINK	POC	POINT OF CONNECTION	WSP	WET STANDPIPE
FSP	FIRE SPRINKLER PIPE				

SYMBOLS

	DOMESTIC COLD WATER LINE		ITEM TO BE REMOVED / DEMOED
	DOMESTIC HOT WATER		ITEM TO BE ABANDONED IN PLACE
	DOMESTIC HOT WATER HEAT TRACE		BALL VALVE
	DOMESTIC HOT WATER RETURN		BALANCE VALVE
	TEMPERED WATER		BUTTERFLY VALVE
	NON POTABLE WATER		CHECK VALVE
	INDUSTRIAL COLD WATER LINE		LEVER HANDLE GAS COCK
	INDUSTRIAL HOT WATER		PRESSURE REDUCING VALVE
	INDUSTRIAL HOT WATER RETURN		SOLENOID VALVE W/ MOTOR ACTUATOR
	SOIL OR WASTE LINE BELOW GRADE		STRAINER
	SOIL OR WASTE LINE ABOVE GRADE		PRESSURE GAUGE
	INDIRECT WASTE LINE		THERMOMETER
	GREASE WASTE LINE		UNION
	ACID WASTE LINE		TEMP. & PRESSURE RELIEF LINE
	VENT LINE		VALVE BOX
	ACID VENT LINE		CAP (END OF PIPE)
	RAINWATER LEADER LINE		CIRCULATING PUMP
	OVERFLOW RAINWATER LEADER LINE		ANGLE VALVE
	CONDENSATE DRAIN		PRESSURE OR TEMP. RELIEF VALVE
	NATURAL GAS LINE (LOW PRESSURE)		DIAMETER
	DENTAL VACUUM		CLEANOUT TO FLOOR
	DENTAL COMPRESSED AIR		CLEANOUT TO GRADE
	COMPRESSED AIR		CLEANOUT
	FLOW IN DIRECTION OF ARROW		FLOOR DRAIN
	REDUCER		FLOOR SINK
	RISER DOWN (ELBOW)		GAS TURRET
	RISER UP (ELBOW)		HOSE BIBB
	R, D RISE OR DROP		POINT OF CONNECTION
	GATE VALVE		POINT OF DISCONNECTION
	ROOM NAME		
	ROOM NAME AND NUMBER		

EQUIPMENT LIST

	<p>GAS WATER HEATER:</p> <p>*AO SMITH* CYCLONE HE MODULATING BURNER CONDENSING GAS FIRED WATER HEATER, MODEL BTX-80. HEATER SHALL BE RATED AT 76,000 BTUH INPUT AND PROVIDE 95 GPH RECOVERY AT 90°F TEMPERATURE RISE. TANK SHALL BE 50 GALLON CAPACITY AND BE CONSTRUCTED IN ACCORDANCE WITH ASME CODE.</p> <p>PROVIDE WITH MODEL BTX-80 CONCENTRIC VENT INTAKE/FLUE KIT, METAL EXHAUST ELBOW ASSEMBLY, AND MODEL BTX-80 CONDENSATE DRAIN NEUTRALIZATION KIT.</p> <p>120V/1Ø POWER</p> <p>SHIPPING WEIGHT = 225 LBS. / MAXIMUM OPERATING WEIGHT = 650 LBS.</p> <p>SET OUTLET TEMPERATURE TO 140°F.</p> <p>SEE DETAIL 1/P-5.1 FOR MOUNTING</p>
	<p>DOMESTIC WATER CIRCULATING PUMP:</p> <p>BELL AND GOSSET MODEL NBF-9U. PUMP TO BE AS FOLLOWS:</p> <ul style="list-style-type: none"> LEAD FREE BRONZE CIRCULATING PUMP 3/4" FLANGED CONNECTIONS PUMP TO BE CAPABLE OF PROVIDING 3 GPM AT 5 FEET HEAD 120V / 1Ø/60 HZ - 411W / 0.40 FLA PROVIDE WITH COMBINATION TC-1 AUTOMATIC TIMER KIT AND AQS-314" AQUASTAT. <p>OPERATING WEIGHT < 15 LBS.</p>
	<p>EXPANSION TANK:</p> <p>WATTS MODEL DETAS LEAD FREE EXPANSION TANK. TANK TO BE AS FOLLOWS:</p> <ul style="list-style-type: none"> ASME SECTION VIII CONSTRUCTION FDA APPROVED FIXED BUTYL BLADDER INTEGRAL BLADDER INTEGRITY MONITOR TANK TO BE 3.5 GALLONS WITH A 2.3 GALLON ACCEPTANCE VOLUME 3/4" INLET CONNECTION MAXIMUM OPERATING PRESSURE OF 150 PSIG MAXIMUM OPERATING WEIGHT = <40 LBS <p>SEE DETAIL 3-PS.1 FOR MOUNTING.</p>
	<p>TANKLESS ELECTRIC WATER HEATER:</p> <p>*CHRONOMITE* MICRO-LOW FLOW TANKLESS WATER HEATER, MODEL M30L208 WITH DIGITAL MICRO PROCESSING TEMPERATURE CONTROL CAPABLE OF MAINTAINING OUTLET TEMPERATURE. WATER HEATER TO BE 6240 WATTS, 208V/1Ø, 30 AMPS. HEATER TO BE CAPABLE OF A TEMPERATURE RISE OF 53°F AT 0.8 GPM.</p> <p>UNIT WEIGHT = 5 LBS.</p> <p>SET OUTLET TEMPERATURE TO 105°F.</p>

©2023 Synthesis Partners, LLC All Rights Reserved
These record drawings have been prepared based upon information submitted, in part, by others. While this information is believed to be reliable, the Architect is not responsible for any inaccuracies or omissions which may be present in these drawings or these documents as a result.

PO Box 1900
Yuba City, CA 95992-1900
530.298.7298
www.spinc-arch.com

ARCHITECTURAL • COMMERCIAL • RESIDENTIAL • INTERIOR • CONSTRUCTION MANAGEMENT



SYNTHESIS PARTNERS, LLC
Managers • Architects


WESTON & ASSOCIATES
MECHANICAL ENGINEERS
601 UNIVERSITY AVE., SUITE 260 | SACRAMENTO, CA 95825
WESTON & ASSOCIATES #22-033

OWNER

Woodland Joint Unified School District
435 6th Street
Woodland, CA 95695

PROJECT
CLASSROOM CONVERSIONS
at
WOODLAND EDUCATION CENTER
575 Hays Street
Woodland, CA 95695

KEY PLAN

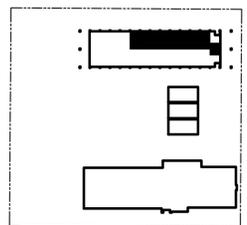

FOR PLAN REVIEW ONLY
NOT FOR CONSTRUCTION

RENEWAL DATE: 12/31/2023

NO.	REVISION DESCRIPTION	DATE

PLUMBING LEGEND & NOTES

DATE: 2022-07-24
PROJECT NO.: 21-W04-01

P0.1

PLUMBING FIXTURE SCHEDULE

FIXTURE	GENERAL DISCRPTION	BASE FIXTURE	VALVE / FAUCET	TRIM	WHA REQUIRED AT FIXTURE	NOTES	PLUMBING PIPE BRANCH SIZE SERVING FIXTURE										
							FIXTURE UNITS				VENT	WASTE		COLD WATER		HOT WATER	
							WASTE	VENT	CW	HW		BRANCH	OUTLET	BRANCH	OUTLET	BRANCH	OUTLET
WC-1	ADA WATER CLOSET TOP SPUD BOWL BATTERY POWERED SENSOR OPERATED FLUSH VALVE	EXISTING WATER CLOSET LEFT IN PLACE	ZURN AQUA SENSE AV MODEL ZER6000PL-W2-HET WATER CLOSET FLUSH VALVE. VALVE TO BE AS FOLLOWS: • TOP SPUD BOWL • 1.28 GPF • ADA COMPLIANT	PROVIDE BEMIS COMMERCIAL HEAVY-DUTY PLASTIC TOILET SEAT, MODEL 1055SC. SEAT TO BE EQUIPPED WITH STAINLESS STEEL POSTS AND SELF SUSTAINING HINGE. (1 1/16" HEIGHT)	YES	FLUSH VALVE TRIP LEVER TO BE ON WIDE SIDE OF ENCLOSURE.	2.0	2.0	1.0	1.0	(E) CONN.	(E) CONN.	(E) CONN.	(E) CONN.	(E) CONN.	(E) CONN.	
S-1	SINK AT DENTAL COUNTER MOUNTED STAINLESS STEEL H&CW MANUAL FAUCET 1.5 GPM ADA	JUST MODEL SL-ADA-1921-A GR COUNTER MOUNT SINK FIXTURE TO BE AS FOLLOWS: • 18 GAUGE TYPE 304 18-8 STAINLESS STEEL • SINGLE BOWL 18x14x6.5" DEEP • SINGLE HOLE PUNCH • REAR CENTER DRAIN • ADA	CHICAGO FAUCETS MODEL 201-AGN8AE35VPABCP. FAUCET TO BE AS FOLLOWS: • H&CW WITH 8" GOOSENECK SPOUT • MANUAL LEVER OPERATOR • CHROME PLATED FINISH • 1.5 GPM VANDAL PROOF AERATOR • ADA COMPLIANT	- PROVIDE WITH GRID DRAIN WITH OFFSET AND P-TRAP - 64 OZ GELCO TRAP PLASTER TRAP	YES	-	2.0	2.0	1.0	1.0	1 1/2"	2"	2"	3/4"	1/2"	3/4"	1/2"
S-1	SINK AT DENTAL COUNTER MOUNTED STAINLESS STEEL H&CW MANUAL FAUCET 1.5 GPM ADA	JUST MODEL SL-ADA-1921-A GR COUNTER MOUNT SINK FIXTURE TO BE AS FOLLOWS: • 18 GAUGE TYPE 304 18-8 STAINLESS STEEL • SINGLE BOWL 18x14x6.5" DEEP • SINGLE HOLE PUNCH • REAR CENTER DRAIN • ADA	CHICAGO FAUCETS MODEL 201-AGN8AE35VPABCP. FAUCET TO BE AS FOLLOWS: • H&CW WITH 8" GOOSENECK SPOUT • MANUAL LEVER OPERATOR • CHROME PLATED FINISH • 1.5 GPM VANDAL PROOF AERATOR • ADA COMPLIANT	- PROVIDE WITH GRID DRAIN WITH OFFSET AND P-TRAP - 64 OZ GELCO TRAP PLASTER TRAP	YES	-	2.0	2.0	1.0	1.0	1 1/2"	2"	2"	3/4"	1/2"	3/4"	1/2"
S-2	SINK AT MANUFACTURING COUNTER MOUNTED STAINLESS STEEL H&CW MANUAL FAUCET 1.5 GPM ADA	JUST MODEL SL-ADA-1921-A GR COUNTER MOUNT SINK FIXTURE TO BE AS FOLLOWS: • 18 GAUGE TYPE 304 18-8 STAINLESS STEEL • SINGLE BOWL 18x14x6.5" DEEP • SINGLE HOLE PUNCH • REAR CENTER DRAIN • ADA	CHICAGO FAUCETS MODEL 201-AGN8AE35VPABCP. FAUCET TO BE AS FOLLOWS: • H&CW WITH 8" GOOSENECK SPOUT • MANUAL LEVER OPERATOR • CHROME PLATED FINISH • 1.5 GPM VANDAL PROOF AERATOR • ADA COMPLIANT	- PROVIDE WITH GRID DRAIN WITH OFFSET AND P-TRAP	YES	-	2.0	2.0	1.0	1.0	1 1/2"	2"	2"	3/4"	1/2"	3/4"	1/2"
S-3	KITCHEN PREP SINK (BY OTHERS) - REFERENCE KITCHEN DRAWINGS FOR DETAILS.	SEE KITCHEN DRAWINGS	SEE KITCHEN DRAWINGS	FIXTURE TO BE PROVIDED WITH FLOOR SINK FOR INDIRECT WASTE CONNECTION.	YES	INDIRECT WASTE CONNECTION - RUN INDIRECT WASTE FROM SINK AND SPILL OVER FLOOR SINK. INSULATE H&CW AND WASTE AT ADA SINK (SEE KITCHEN/ ARCHITECTURAL DRAWING FOR LOCATION) PER NOTE 6.	2.0	2.0	1.0	1.0	1 1/2"	2" BRANCH LINE TO FLOOR SINK. SERVING THIS FIXTURE		3/4"	1/2"	3/4"	1/2"
S-4	KITCHEN HANDWASH SINK (BY OTHERS) - REFERENCE KITCHEN DRAWINGS FOR DETAILS.	SEE KITCHEN DRAWINGS	SEE KITCHEN DRAWINGS	PROVIDE WITH OFFSET TAILPIECE AND P-TRAP.	YES	DIRECT WASTE CONNECTION. CONTRACTOR TO BRING PLUMBING UTILITIES TO FIXTURE AND CONNECT. INSULATE H&CW AND WASTE PER NOTE 6.	2.0	2.0	1.0	1.0	1 1/2"	2"	1 1/2"	3/4"	1/2"	3/4"	1/2"
S-5	KITCHEN 3-COMPARTMENT SINK SINK (BY OTHERS) - REFERENCE KITCHEN DRAWINGS FOR DETAILS.	SEE KITCHEN DRAWINGS	SEE KITCHEN DRAWINGS 2 FAUCETS AT THIS FIXTURE.	FIXTURE TO BE PROVIDED WITH FLOOR SINK FOR INDIRECT WASTE CONNECTION.	YES	INDIRECT WASTE CONNECTION - RUN INDIRECT WASTE FROM SINK AND SPILL OVER FLOOR SINK.	3.0	3.0	1.0	1.0	1 1/2"	3" BRANCH LINE TO FLOOR SINK. SERVING THIS FIXTURE		3/4"	1/2"	3/4"	1/2"
S-6	KITCHEN PRE-RINSE (BY OTHERS) - REFERENCE KITCHEN DRAWINGS FOR DETAILS.	SEE KITCHEN DRAWINGS	SEE KITCHEN DRAWINGS	FIXTURE TO BE PROVIDED WITH FLOOR SINK FOR INDIRECT WASTE CONNECTION.	YES	INDIRECT WASTE CONNECTION - RUN INDIRECT WASTE FROM SINK AND SPILL OVER FLOOR SINK.	2.0	2.0	1.0	1.0	1 1/2"	3" BRANCH LINE TO FLOOR SINK. SERVING THIS FIXTURE		3/4"	1/2"	3/4"	1/2"
DW	KITCHEN DISHWASHER (BY OTHERS) - REFERENCE KITCHEN DRAWINGS FOR DETAILS.	SEE KITCHEN DRAWINGS	SEE KITCHEN DRAWINGS	FIXTURE TO BE PROVIDED WITH FLOOR SINK FOR INDIRECT WASTE CONNECTION.	NO	INDIRECT WASTE CONNECTION - RUN INDIRECT WASTE FROM SINK AND SPILL OVER FLOOR SINK.	2.0	2.0	1.0	1.0	1 1/2"	3" BRANCH LINE TO FLOOR SINK SERVING THIS FIXTURE		3/4"	1/2"	3/4"	1/2"
RB-1	ICE MAKER BOX	GUY GRAY BIM975QTSAB LEAD FREE RECESSED 20 GAUGE GALVANIZED METAL WATER BOX WITH 1/8 GAUGE FACEPLATE & 1/2" QUARTER TURN BALL VALVE.	-	-	NO	CONTRACTOR TO PROVIDE FINAL CONNECTION FROM BOX TO WATER FILTER AND FIXTURE. PROVIDE WITH STAINLESS STEEL BRAIDED HOSES FOR FINAL CONNECTIONS.	-	-	-	-	-	-	-	3/4"	1/2"	-	-

- NOTES:**
- USE PIPE SIZE TABLE FOR SIZING ALL BRANCH WATER, WASTE, & VENT BRANCH PIPES.
 - REFERENCE ARCHITECTURAL DRAWINGS FOR FIXTURE MOUNTING HEIGHT.
 - WATER BRANCH LINES WHERE LESS THAN 10'-0" LONG MAY BE SAME SIZE AS OUTLETS SCHEDULED ABOVE.
 - AT ALL ADA SINKS AND LAVATORIES, INSULATE HOT WATER, COLD WATER, AND AND WASTE PIPING BELOW FIXTURE WITH "TRUEBRO" LAV GUARD PROTECTIVE MOLDED CLOSED CELL VINYL PIPE COVERS, WITH VANDAL RESISTANT SNAP-CLIP FASTENERS, AND AN ASTM E-84 SMOKE TEST RATING OF 0.
 - PROVIDE WALL CLEANOUT AT ALL SINKS WITH DIRECT CONNECTIONS.
 - PROVIDE WATER HAMMER ARRESTOR FOR ON BOTH H&CW BRANCH LINES AT ALL FIXTURES PER SPECIFICATION SECTION 22 05 23
 - WHERE FIXTURES ARE NOTED AS BEING "ADA", INSTALLATION TO MEET ADA REQUIREMENTS AND CBC REQUIREMENTS.

MAX. FIXTURE UNIT LOADING FOR WASTE PIPE				
NOMINAL PIPE SIZE (INCHES)	2"Ø	3"Ø	4"Ø	6"Ø
FIXTURE UNITS (VERTICAL)	16*	48	256	1,380
FIXTURE UNITS (HORIZONTAL)	8*	35	216	720

NOTES:

- PIPE SIZES TO BE PER CALIFORNIA PLUMBING CODE, TABLE 7-5.
- SLOPE ALL HORIZONTAL WASTE PIPE AT 1/4" PER FOOT.
* EXCEPT SIX-UNIT TRAPS OR WATER CLOSETS.

MAX. FIXTURE UNIT LOADING FOR VENT PIPE					
NOMINAL PIPE SIZE (INCHES)	1 1/2"Ø	2"Ø	2 1/2"Ø	3"Ø	4"Ø
FIXTURE UNITS (HORIZONTAL & VERTICAL)	8	24	48	84	256
FIXTURE LENGTH (FEET)	8*	35	216	720	300

NOTES:

- PIPE SIZES TO BE PER CALIFORNIA PLUMBING CODE, TABLE 7-5.
- SLOPE ALL HORIZONTAL WASTE PIPE AT 1/4" PER FOOT.

MAX. FIXTURE UNIT LOADING FOR WATER PIPE								
NOMINAL PIPE SIZE (INCHES)	3/4"Ø	1"Ø	1 1/4"Ø	1 1/2"Ø	2"Ø	2 1/2"Ø	3"Ø	4"Ø
FIXTURE UNITS (WITHOUT FLUSH VALVES)	6	10	21	34	127	245	431	875
FIXTURE UNITS (WITH ONE OR MORE FLUSH VALVES)	-	5	10	20	48	124	295	850

NOTES:

- USE ABOVE DATA ONLY WHEN PIPE SIZES ARE NOT OTHERWISE SIZED ON THE DRAWINGS.
- FIXTURE UNITS ARE AS LISTED FOR PUBLIC USE IN THE CALIFORNIA PLUMBING CODE.

APPROVALS

PO Box 1900
Yuba City, CA 95992-1900
530.298.7298
www.spinc-arch.com

ARCHITECTURAL • COMMERCIAL • RESIDENTIAL • INTERIOR • CONSTRUCTION MANAGEMENT



SYNTHESIS PARTNERS, LLC
Managers • Architects



WESTON & ASSOCIATES
MECHANICAL ENGINEERS
601 UNIVERSITY AVE., SUITE 260 | SACRAMENTO, CA 95825
WESTON & ASSOCIATES #22-033


OWNER

Woodland Joint Unified School District
435 6th Street
Woodland, CA 95695

PROJECT

CLASSROOM CONVERSIONS
at
WOODLAND EDUCATION CENTER
575 Hays Street
Woodland, CA 95695

KEY PLAN

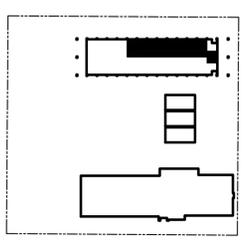


MECHANICAL PROFESSIONAL SEAL
No. M31220
FOR PLAN REVIEW ONLY
NOT FOR CONSTRUCTION
RENEWAL DATE: 12/31/2023
STATE OF CALIFORNIA

NO.	REVISION DESCRIPTION	DATE



PLUMBING SCHEDULES

P0.2


DATE	2022-07-24
PROJECT NO.	21-W04-01

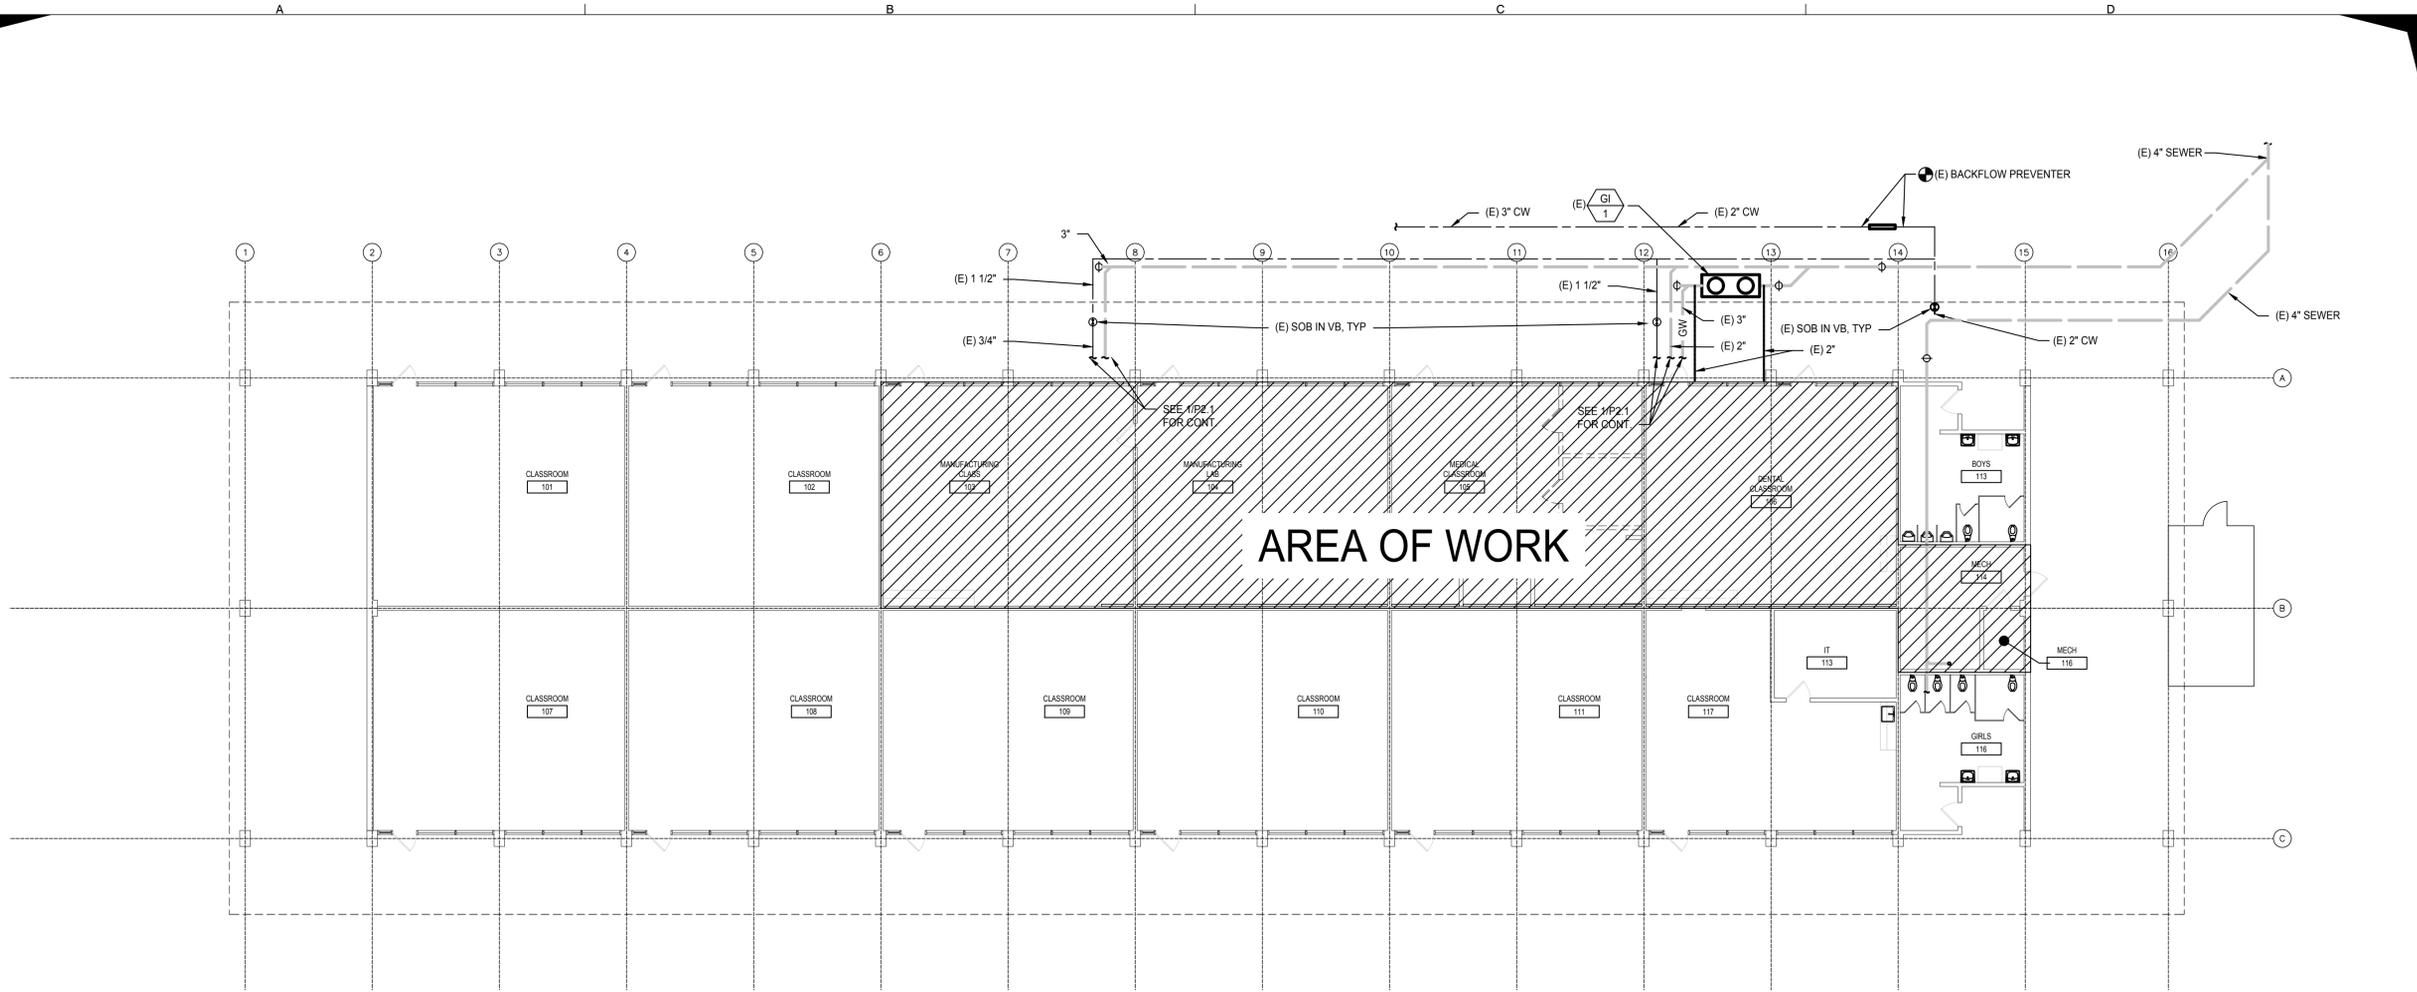

OVERALL PLUMBING PLAN
SCALE: 3/32" = 1'-0"

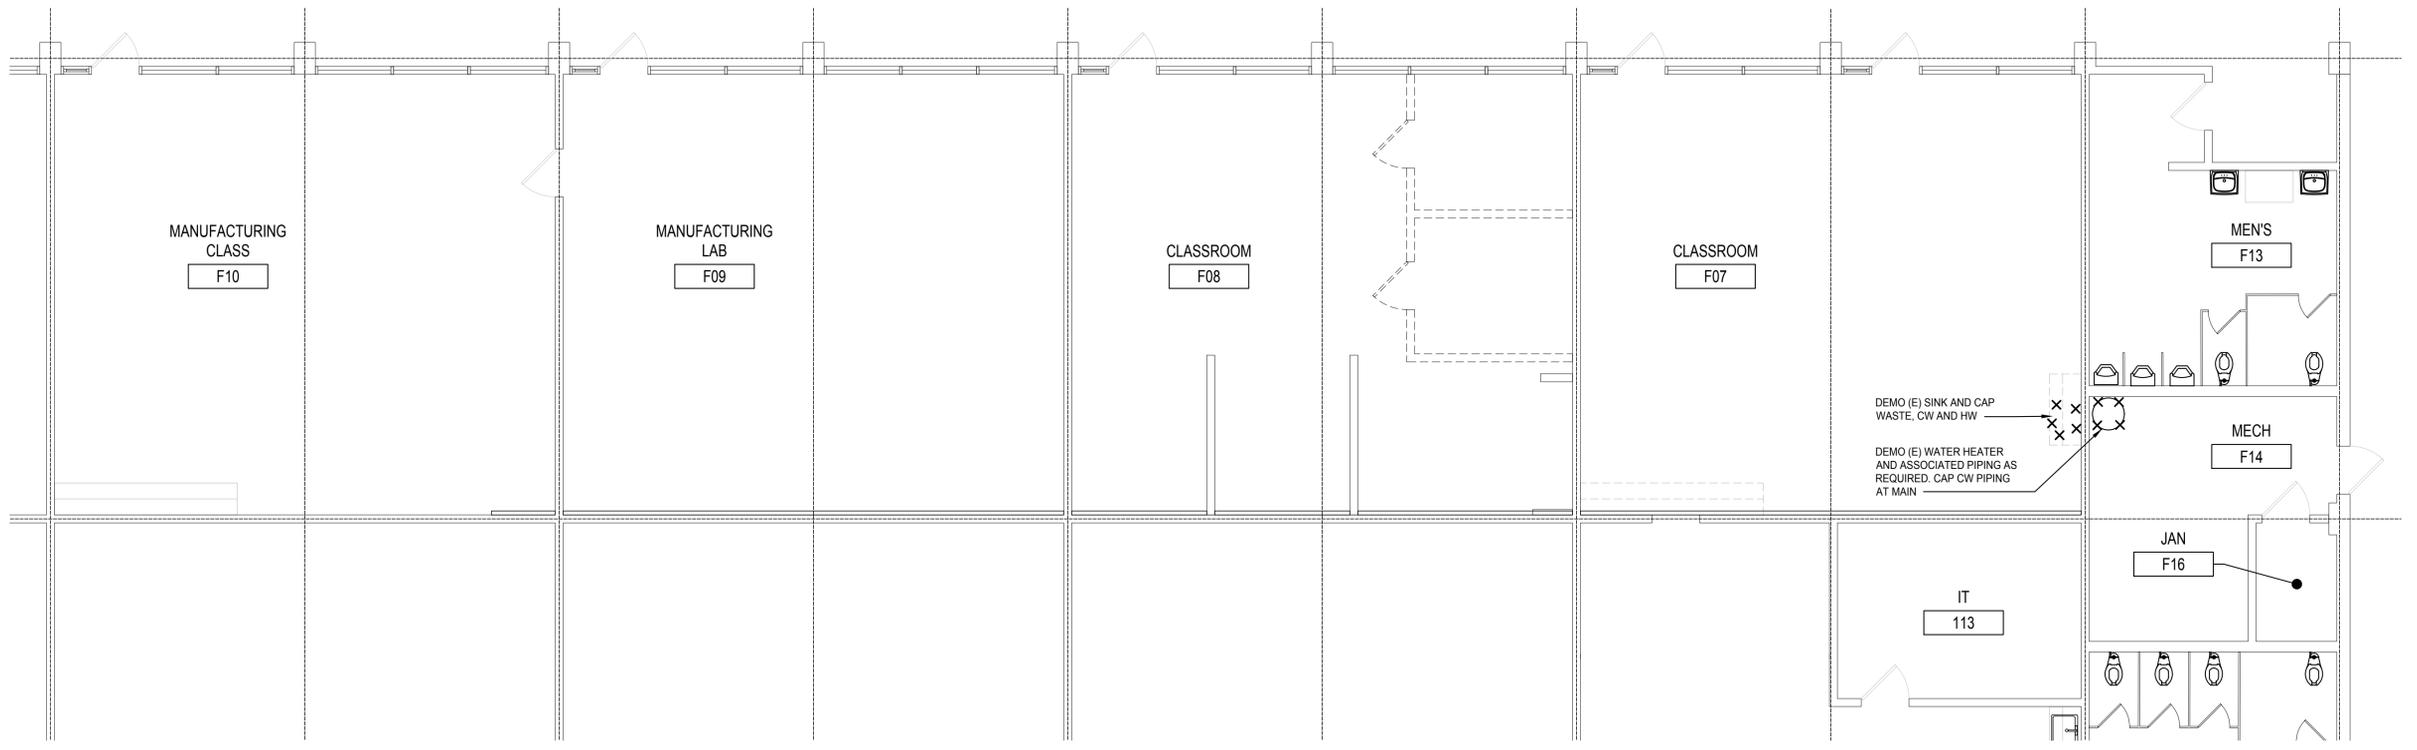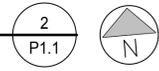

PARTIAL DEMO PLUMBING & GAS PLAN
SCALE: 3/16" = 1'-0"

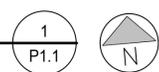

APPROVALS

©2023 Synthesis Partners, LLC. All Rights Reserved. These record drawings have been prepared based upon information submitted, in part, by others. While this information is believed to be reliable, the Architect is not responsible for any errors or omissions which may have been incorporated into these documents as a result.

PO Box 1900
Yuba City, CA 95992-1900
530.298.7298
www.spinc-arch.com



SYNTHESIS PARTNERS, LLC
Managers • Architects


WESTON & ASSOCIATES
MECHANICAL ENGINEERS
601 UNIVERSITY AVE., SUITE 260 | SACRAMENTO, CA 95825
WESTON & ASSOCIATES #22-033

OWNER

Woodland Joint Unified School District
435 6th Street
Woodland, CA 95695

PROJECT

CLASSROOM CONVERSIONS
at
WOODLAND EDUCATION CENTER
575 Hays Street
Woodland, CA 95695

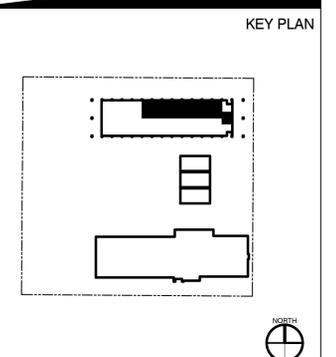


REGISTERED PROFESSIONAL
PLUMBER & GAS FITTER - WEST
No. M31220
**FOR PLAN REVIEW ONLY
NOT FOR CONSTRUCTION**
RENEWAL DATE: 12/31/2023
STATE OF CALIFORNIA

NO.	REVISION DESCRIPTION	DATE

PLUMBING OVERALL PLAN & DEMO FLOOR PLAN

DATE: 2022-07-24
PROJECT NO.: 21-W04-01

P1.1

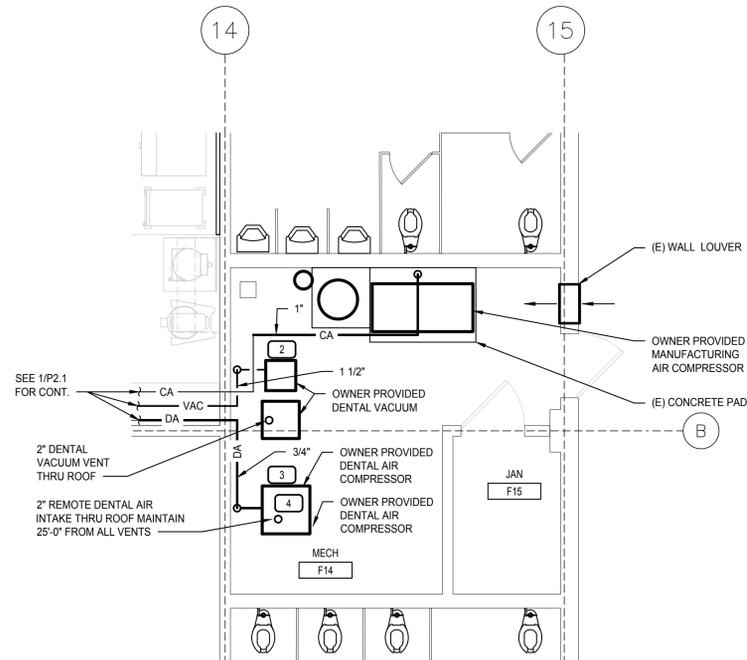

DENTAL PIPING KEYNOTES:



- 1 PROVIDE THE FOLLOWING:
- 1/2" DA TERMINATE W/ 3/8" ANGLE VALVE.
- 3/4" PVC VAC STUB WITH TEMP CAP.
SEE DENTAL DRAWINGS FOR EXACT LOCATION.
- 2 1 1/2" PVC VAC W/ TERMINATION FITTING FROM MAIN TRUNK LINE. VERIFY SIZE HEIGHT AND LOCATION WITH DENTAL EQUIPMENT.
- 3 1" DA W/ BALL VALVE & TERMINATION FITTING FROM MAIN TRUNK LINE. VERIFY SIZE HEIGHT AND LOCATION WITH DENTAL EQUIPMENT.
- 4 2" REMOTE EXHAUST VENT RISER FROM DENTAL EQUIPMENT THRU ROOF. SEE DENTAL DRAWINGS FOR EXACT LOCATION OF CONNECTION. 90 DEGREE ELBOWS ARE NOT ALLOWED.
- 5 3/4" DRAIN FROM MANUFACTURING AIR COMPRESSOR (MCA).
- 6 1 1/2" DRAIN FROM DENTAL VACUUM UNIT.
- 7 3/4" DRAIN FROM DENTAL AIR COMPRESSOR (DA).

DENTAL PIPING GENERAL NOTES:

1. EXACT EQUIPMENT LOCATIONS MUST BE JOB SITE VERIFIED BY TONY VIGIL @ DESCO, INC. THE DENTAL EQUIPMENT PROVIDER.
2. CONTRACTOR SHALL FOLLOW MANUFACTURER'S TEMPLATES FOR EXACT REQUIREMENTS FOR ANY EQUIPMENT SUPPLIED BY DESCO, INC. CONTRACTOR SHALL CONSULT WITH TONY VIGIL @ DESCO, INC. THE DENTAL EQUIPMENT PROVIDER FOR ADDITIONAL INFORMATION.
3. THE COMPRESSED AIR AND AIR COMPRESSOR ARE A CATEGORY 3 DENTAL AIR SUPPLY SYSTEM.



ENLARGE DENTAL PIPING PLAN

SCALE: 1/4" = 1'-0"

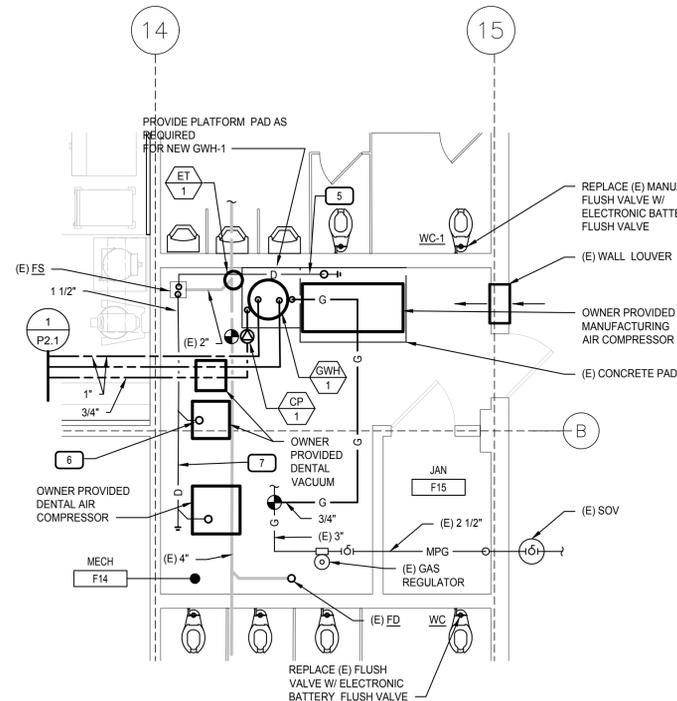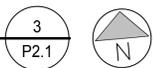


ENLARGE PLUMBING PLAN

SCALE: 1/4" = 1'-0"

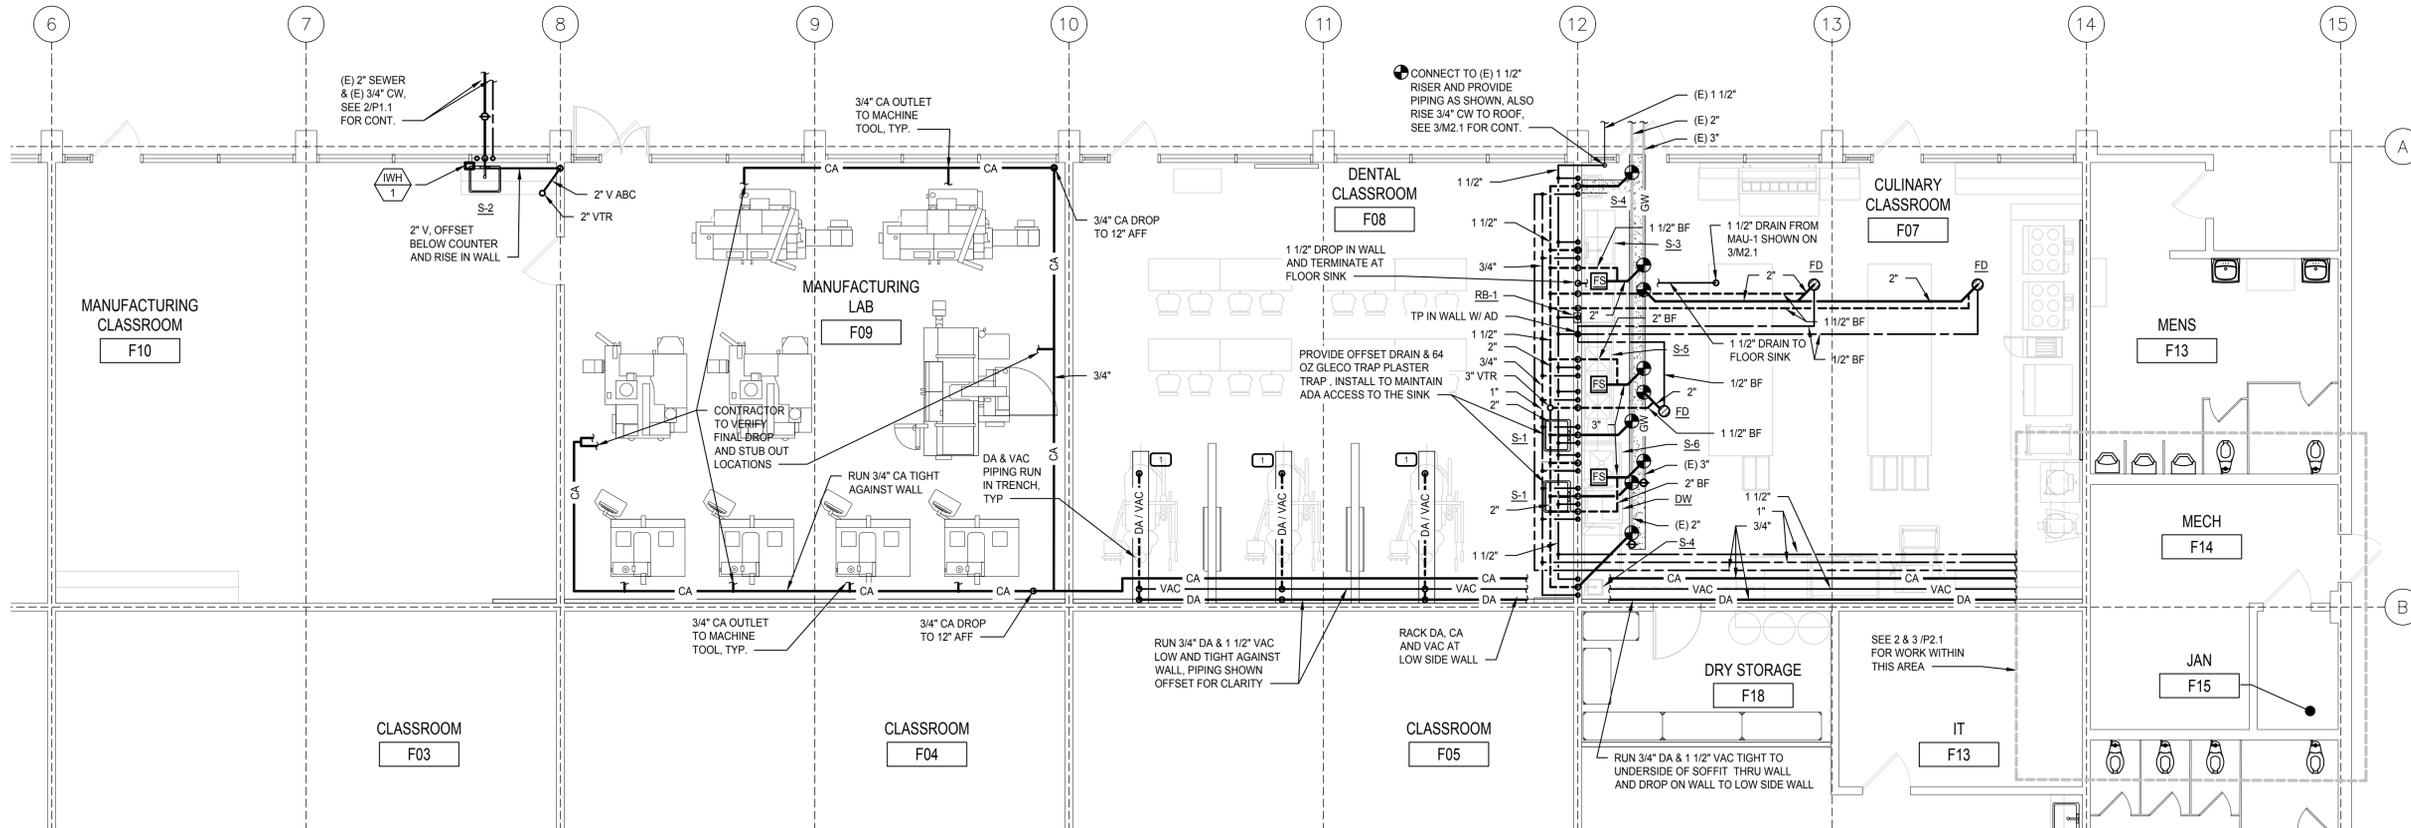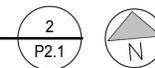

ENLARGED PLUMBING FLOOR PLAN

SCALE: 3/16" = 1'-0"

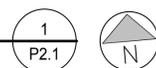

APPROVALS

PO Box 1900
Yuba City, CA 95992-1900
530.298.7298
www.spinc-arch.com




SYNTHESIS PARTNERS, LLC
Managers • Architects

WESTON & ASSOCIATES
MECHANICAL ENGINEERS
601 UNIVERSITY AVE., SUITE 260 | SACRAMENTO, CA 95825
WESTON & ASSOCIATES #22-033

OWNER
Woodland Joint Unified School District
435 6th Street
Woodland, CA 95695

PROJECT
CLASSROOM CONVERSIONS
at
WOODLAND EDUCATION CENTER
575 Hays Street
Woodland, CA 95695

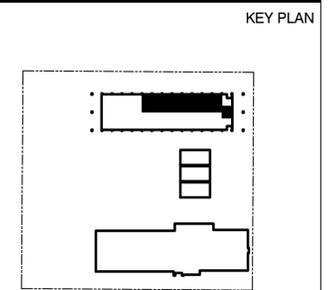


PROFESSIONAL SEAL
No. M31220
FOR PLAN REVIEW ONLY
NOT FOR CONSTRUCTION
RENEWAL DATE: 12/31/2023
MECHANICAL ENGINEER
STATE OF CALIFORNIA

NO.	REVISION DESCRIPTION	DATE


PLUMBING FLOOR PLANS

DATE: 2022-07-24
PROJECT NO.: 21-W04-01


P2.1

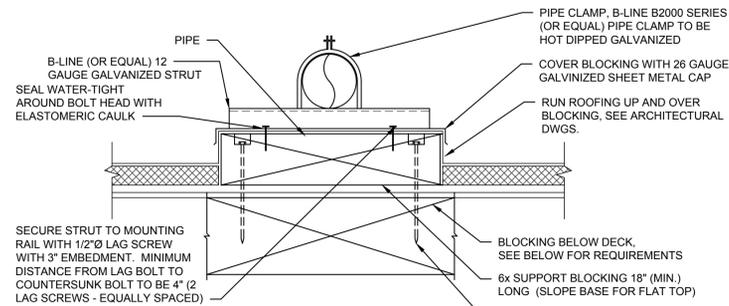

PIPE ANCHORAGE

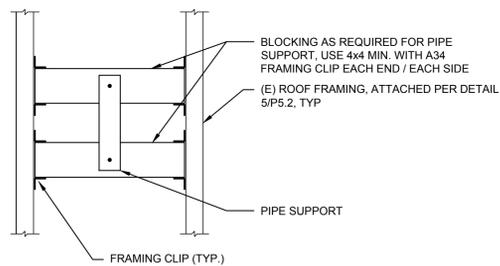

PIPE SUPPORT BLOCKING PARALLEL TO FRAMING

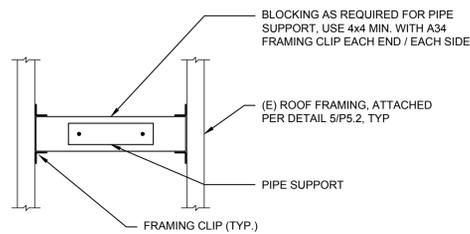


PIPE SUPPORT BLOCKING PERPENDICULAR TO FRAMING

NOTES:

1. REMOVE AND REPLACE (E) ROOF SHEETING IN-INK AS REQUIRED TO ACCESS (E) FRAMING BELOW.


ROOFTOP PIPING ANCHORAGE DETAIL

NTS

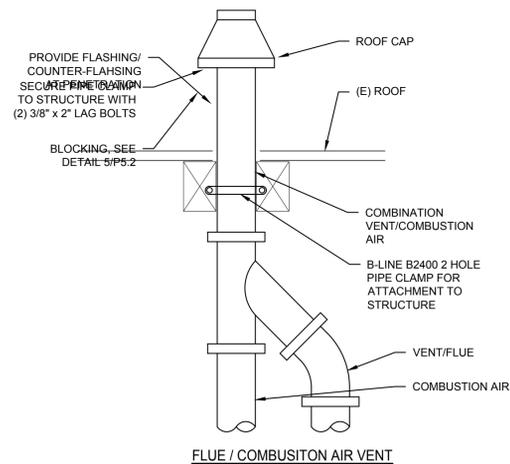


WATER HEATER FLUE DETAIL

NTS

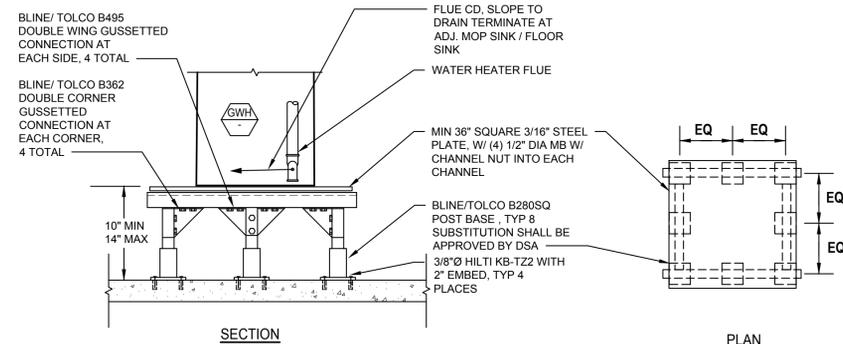


PLATFORM DETAIL

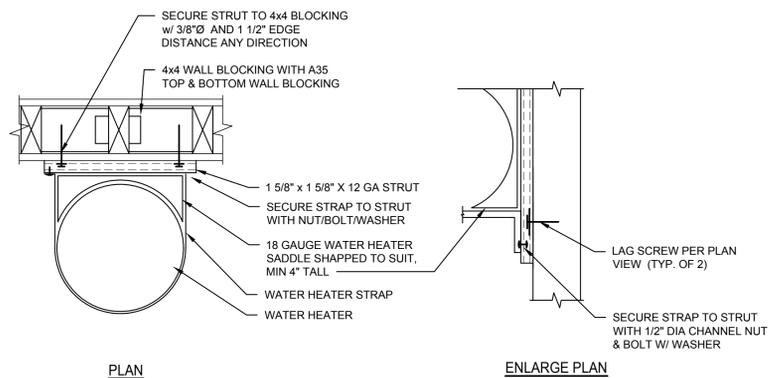

PIPING DETAILS

WATER HEATER DETAILS

NTS

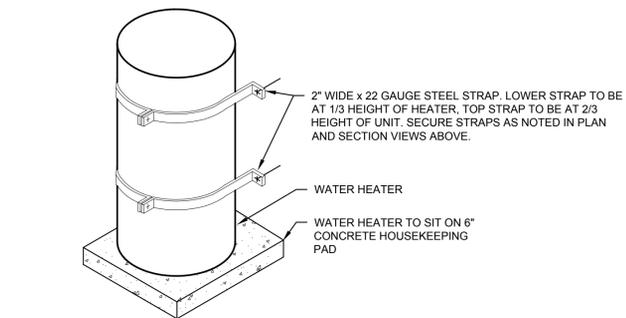

©2023 Synthesis Partners, LLC All Rights Reserved
These record drawings have been prepared based upon information submitted, in part, by others. While this information is believed to be reliable, the Architect is not responsible for any errors or omissions which may have been incorporated into these documents as a result.

PO Box 1900
Yuba City, CA 95992-1900
530.298.7298
www.spinc-arch.com



SYNTHESIS PARTNERS, LLC
Managers • Architects



WESTON & ASSOCIATES
MECHANICAL ENGINEERS
601 UNIVERSITY AVE., SUITE 260 | SACRAMENTO, CA 95825
WESTON & ASSOCIATES #22-033

APPROVALS


OWNER

Woodland Joint Unified School District
435 6th Street
Woodland, CA 95695

PROJECT

CLASSROOM CONVERSIONS
at
WOODLAND EDUCATION CENTER
575 Hays Street
Woodland, CA 95695

KEY PLAN

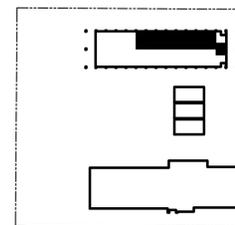




**FOR PLAN REVIEW ONLY
NOT FOR CONSTRUCTION**

NO.	REVISION DESCRIPTION	DATE

PLUMBING DETAILS

P5.1

DATE: 2022-07-24
PROJECT NO.: 21-W04-01

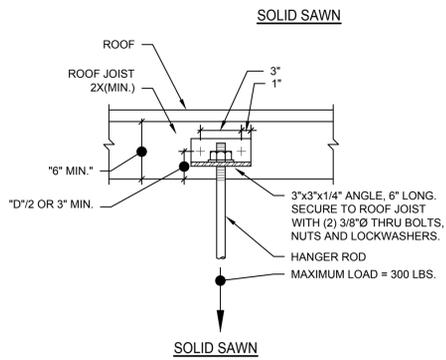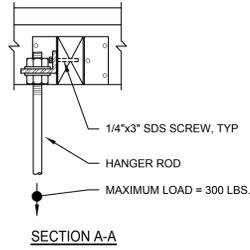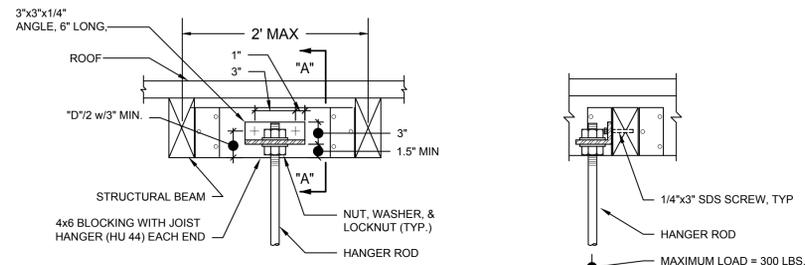


HANGER ROD SUPPORT DETAILS

NTS

5
P5.2

HANGER ROD SCHEDULE	
PIPE SIZE (Ø)	ROD SIZE
1/2" TO 4"	3/8"Ø

CLEVIS CLAMPS NOT USED FOR SEISMIC RESTRAINT

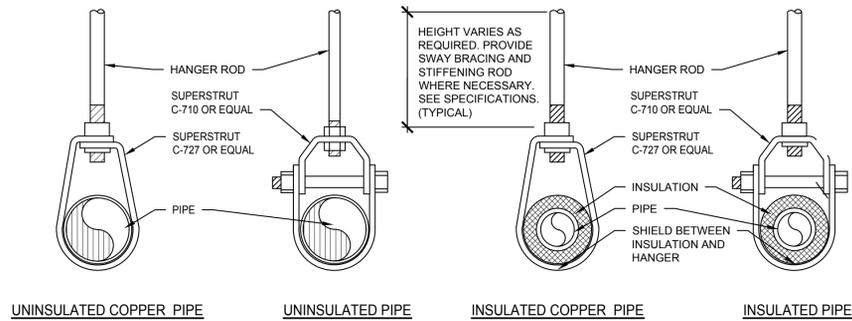


NOTES:

- SEISMIC RESTRAINTS ARE NOT REQUIRED FOR ALL 3" PIPE AND AND SMALLER WITH DESIGN IP OF 1.0.
- SEISMIC RESTRAINTS ARE NOT REQUIRED FOR ALL PIPING SUSPENDED BY INDIVIDUAL HANGERS 12" OR LESS IN LENGTH FROM TOP OF PIPE TO BOTTOM OF ATTACHMENT TO STRUCTURE.
- ALL SUSPENDED PIPING, DUCTWORK, CONDUIT AND CABLE TRAYS SHALL BE PROVIDED WITH, SEISMIC SWAY BRACES IN ACCORDANCE WITH THE MASON SEISMIC RESTRAINT GUIDELINE, OPM-0043-13.
- PIPE SIZES AND SPACING TO BE PER THE ABOVE SEISMIC RESTRAINT GUIDELINES. CONTRACTOR TO PREPARE & PROVIDE AT CONTRACTORS EXPENSE COPIES OF DETAILS USED TO INSPECTOR OF RECORD (IOR) AND ARCHITECT PRIOR TO INSTALLATION.
- TRAPEZE SUPPORTS SHALL NOT BE USED. IF TRAPEZE SUPPORTS ARE TO BE USED, CONTRACTOR IS RESPONSIBLE FOR PREPARING, SUBMITTING AND OBTAINING APPROVED DRAWINGS PER LISTED OPM-0043-13. ALL COST WILL BE AT CONTRACTOR EXPENSE.

PIPE HANGER DETAILS

NTS


4
P5.2

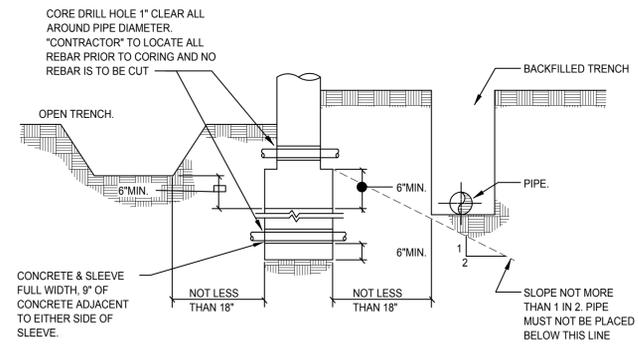

RELATION OF PIPES & TRENCHES TO FOUNDATIONS

NTS


3
P5.2

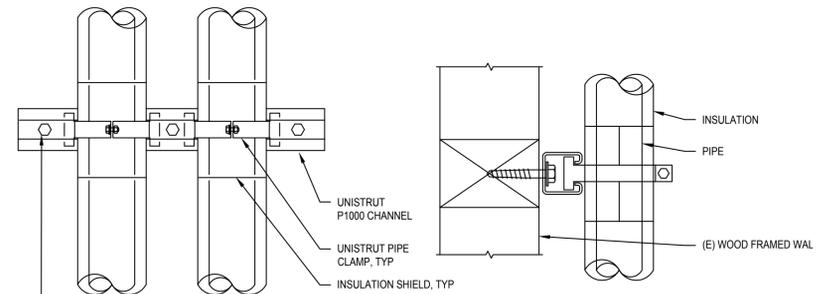

PIPE SUPPORT DETAIL

NTS

2
P5.2

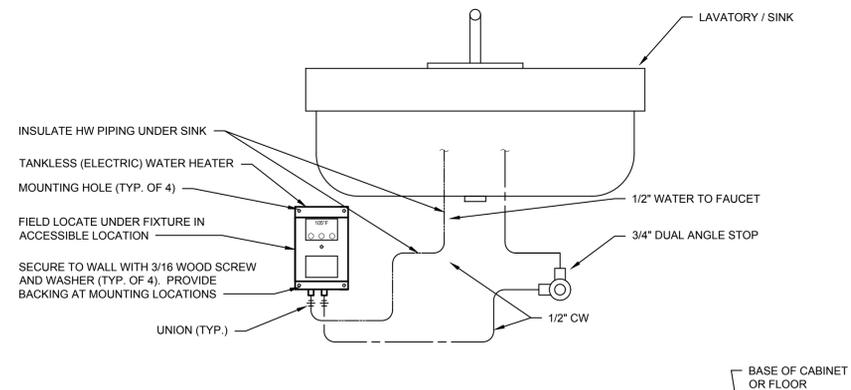

TANKLESS WATER HEATER DETAIL

NTS

1
P5.2

©2023 Synthesis Partners, LLC All Rights Reserved
These record drawings have been prepared by others. While this information is believed to be reliable, the Architect is not responsible for any errors or omissions which may have been incorporated into these documents as a result.

PO Box 1900
Yuba City, CA 95992-1900
530.298.7298
www.spinc-arch.com




SYNTHESIS PARTNERS, LLC
Managers · Architects

WESTON & ASSOCIATES
MECHANICAL ENGINEERS
601 UNIVERSITY AVE., SUITE 260 | SACRAMENTO, CA 95825
WESTON & ASSOCIATES #22-033

OWNER
Woodland Joint Unified School District
435 6th Street
Woodland, CA 95695

PROJECT
CLASSROOM CONVERSIONS
at
WOODLAND EDUCATION CENTER
575 Hays Street
Woodland, CA 95695

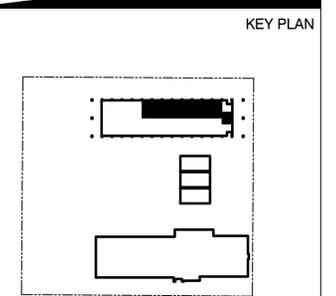

**FOR PLAN REVIEW ONLY
NOT FOR CONSTRUCTION**

NO.	REVISION DESCRIPTION	DATE

PLUMBING DETAILS



DATE: 2022-07-24
PROJECT NO.: 21-W04-01

P5.2

EXPANSION TANK MOUNTING DETAILS

NTS



5
P5.3

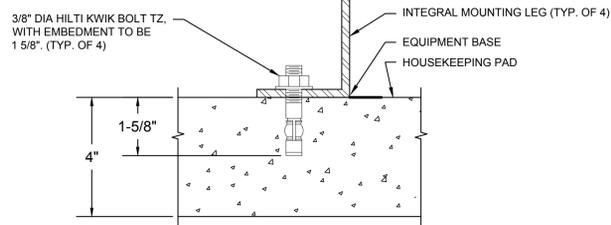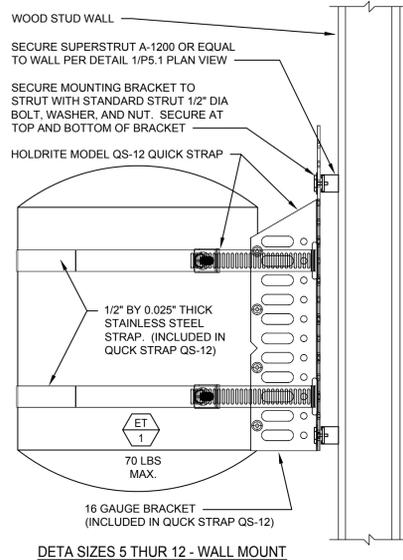

MEDICAL VACUUM PUMP/AIR COMPRESSOR MOUNTING

NTS

4
P5.3

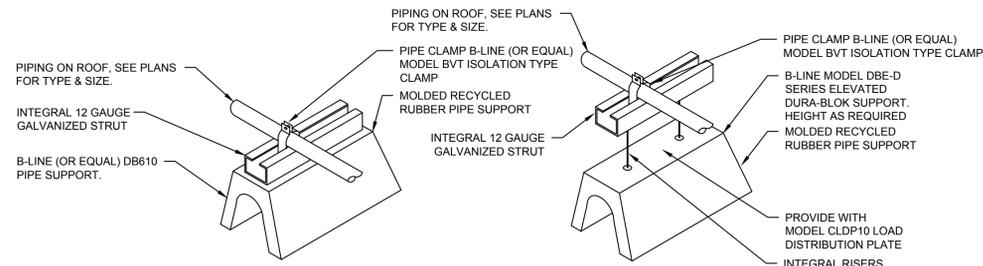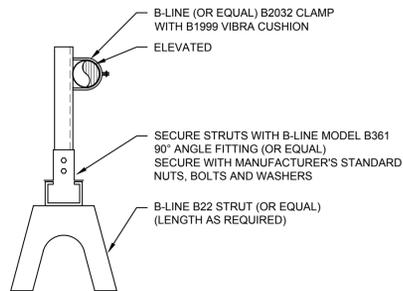

PIPE SUPPORT ON ROOF DETAIL


NTS

3
P5.3


ROOF A/C GAS CONNECTION

NTS


2
P5.3

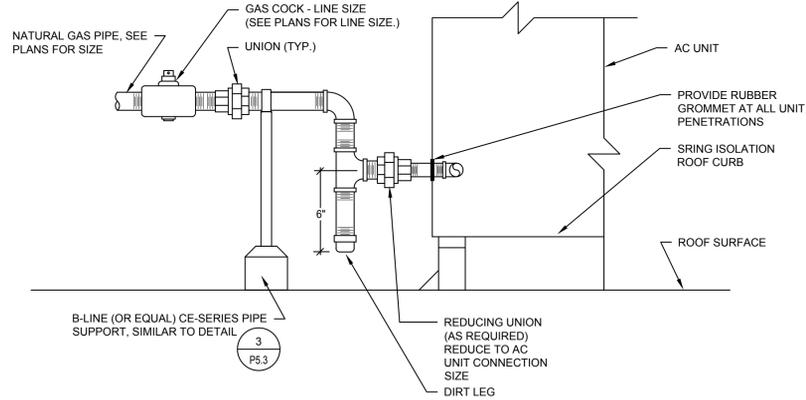

- NOTES:
1. ALL EXPOSED GAS PIPING TO BE CLEANED, PRIMED, AND PAINTED (YELLOW).
 2. FOR CLARITY, FLASHING NOT SHOWN. PROVIDE FLASHING FOR WATERTIGHT PENETRATIONS.

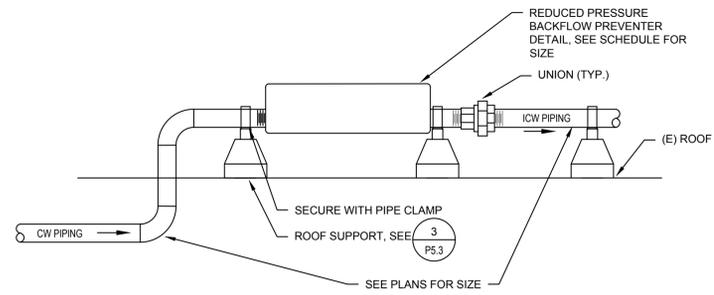

- NOTES:
1. FOR CLARITY, FLASHING NOT SHOWN. PROVIDE FLASHING FOR WATERTIGHT PENETRATIONS.

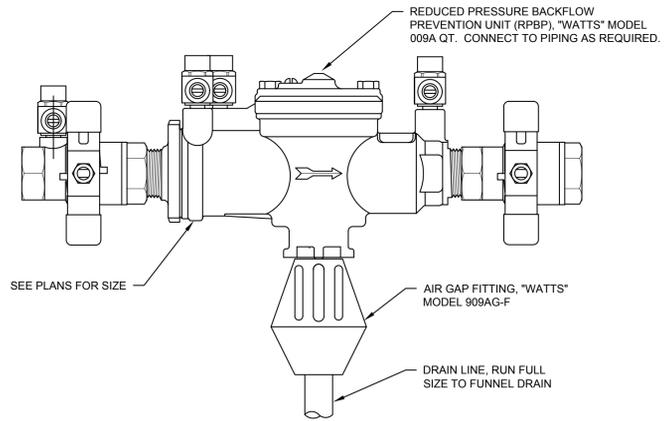

REDUCED PRESSURE BACKFLOW PREVENTER DETAIL

NTS

1
P5.3

©2023 Synthesis Partners, LLC. All Rights Reserved. These record drawings have been prepared based upon information submitted, in part, by others. While this information is believed to be reliable, the Architect is not responsible for any inaccuracies or omissions which may be present in or which may be incorporated into these documents as a result.

PO Box 1900
Yuba City, CA 95992-1900
530.298.7298
www.spinc-arch.com

ARCHITECTURAL • COMMERCIAL • RESIDENTIAL • INTERIOR • CONSTRUCTION MANAGEMENT




OWNER

Woodland Joint Unified School District
435 6th Street
Woodland, CA 95695

PROJECT

CLASSROOM CONVERSIONS
at
WOODLAND EDUCATION CENTER
575 Hays Street
Woodland, CA 95695

KEY PLAN

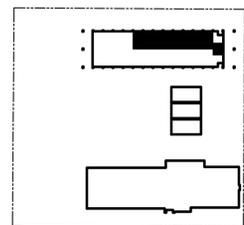

NO.	REVISION DESCRIPTION	DATE

PLUMBING DETAILS

P5.3

DATE: 2022-07-24
PROJECT NO.: 21-W04-01

Applicable Code: 2019 CBC 02/05/2020 Revised: 02/14/2020

MEP Component Anchorage Note

All mechanical, plumbing, and electrical components shall be anchored and installed per the details on the DSA approved construction documents. The following components shall be anchored or braced to meet the force and displacement requirements prescribed in the 2019 CBC Sections 1617A.1.18 through 1617A.1.26 and ASCE 7-16 Chapters 13, 26 and 30.

1. All permanent equipment and components.
2. Temporary, movable, or mobile equipment that is permanently attached (e.g. hard wired) to the building utility services such as electricity, gas or water. "Permanently attached" shall include all electrical connections except plugs for 110/220 volt receptacles having flexible cable.
3. Temporary, movable, or mobile equipment which is heavier than 400 pounds or has a center of mass located 4 feet or more above the adjacent floor or roof level that directly support the component is required to be restrained in manner approved by DSA.

The following mechanical and electrical components shall be positively attached to the structure, but need not demonstrate design compliance with the references noted above. These components shall have flexible connections provided between the component and associated ductwork, piping, and conduit. Flexible connections must allow movement in both transverse and longitudinal directions.

A. Components weighing less than 400 pounds and have a center of mass located 4 feet or less above the adjacent floor or roof level that directly support the component.

B. Components weighing less than 20 pounds, or in the case of distributed systems, less than 5 pounds per foot, which are suspended from a roof or floor or hung from a wall.

The anchorage of all mechanical, electrical and plumbing components shall be subject to the approval of the design professional in general responsible charge or structural engineer delegated responsibility and acceptance by DSA. The project inspector will verify that all components and equipment have been anchored in accordance with above requirements

Piping, Ductwork, and Electrical Distribution System Bracing Note

Piping, ductwork, and electrical distribution systems shall be braced to comply with the forces and displacements prescribed in ASCE 7-16 Section 13.3 as defined in ASCE 7-16 Section 13.6.5, 13.6.6, 13.6.7, 13.6.8, and 2019 CBC, Sections 1617A.1.24, 1617A.1.25 and 1617A.1.26.

The method of showing bracing and attachments to the structure for the identified distribution system are as noted below. When bracing and attachments are based on a preapproved installation guide (e.g., OSHPD OPM for 2013 CBC or later), copies of the bracing system installation guide or manual shall be available on the jobsite prior to the start of and during the hanging and bracing of the distribution systems. The Structural Engineer of Record shall verify the adequacy of the structure to support the hanger and brace loads.

Mechanical Piping (MP), Mechanical Ducts (MD), Plumbing Piping (PP), Electrical Distribution Systems (E):

MP MD PP **E** - Option 1: Detailed on the approved drawings with project specific notes and details.

MP MD PP **E** - Option 2: Shall comply with the applicable OSHPD Pre-Approval (OPM#) # _____.

ELECTRICAL SYMBOL LIST

	JUNCTION BOX - SIZE AS REQUIRED BY CODE
	DUPLEX CONVENIENCE OUTLET - NEMA 5-20R +18" A.F.F. TYPICAL FOR ALL CONVENIENCE OUTLETS, UNLESS NOTED OTHERWISE (LETTER "A" SHOWN ADJACENT TO OUTLET DESIGNATES MOUNTED HORIZONTALLY ABOVE COUNTER).
	GFCI DUPLEX CONVENIENCE OUTLET - NEMA 5-20R
	QUADPLEX CONVENIENCE OUTLET - NEMA 5-20R
	GFCI QUAD CONVENIENCE OUTLET - NEMA 5-20R
	SPECIAL RECEPTACLE AS SHOWN ON PLANS
	EQUIPMENT DISCONNECT SWITCH - EXTERNALLY OPERATED, FUSED WITH FUSE SIZE TO MATCH EQUIPMENT NAMEPLATE
	EQUIPMENT DISCONNECT SWITCH - EXTERNALLY OPERATED, NON-FUSIBLE
	BUCK-BOOST TRANSFORMER - REFER TO DRAWING FOR VOLTAGE/POWER REQUIREMENTS.
	DATA OUTLET - +18" A.F.F. NUMBER IN PARENTHESIS INDICATES NUMBER OF DATA JACKS. OUTLET SHALL MATCH EXISTING ON SITE. PROVIDE STEEL SURFACE RACEWAY - WIREMOLD SERIES 2000 OR SIMILAR TO RUN CAT WIRE TO (E) IDF. COORDINATE EXACT ROUTE WITH ARCHITECT PRIOR TO ROUGH IN.
	FIRE ALARM HEAT DETECTOR - CEILING MOUNTED. "XX" INDICATE TEMPERATURE RATING.
	FIRE ALARM SMOKE DETECTOR - CEILING MOUNTED. THE DEFAULT TYPE IS "PHOTOELECTRIC" INDICATED BY NO LETTER.
	FIRE ALARM AUDIO / VISUAL DEVICE, +80" A.F.F. DEFAULT AUDIO DEVICE IS A HORN. "YY" INDICATES STROBE CANDELA RATING.
	FIRE ALARM RELAY MODULE
	FIRE ALARM MONITOR MODULE
	CONDUIT RUN CONCEALED IN CEILINGS OR WALLS. NUMBER OF HASH MARKS DENOTES QUANTITY OF WIRES. CURVED HASH MARK DENOTES QUANTITY OF #12 GREEN GROUND WIRES. CONDUCTORS OTHER THAN #12 ARE INDICATED ON PLANS. NO HASH MARKS DENOTES 2 #12 AWG AND 1 #12 GREEN GROUND IN 1/2" CONDUIT. TYPICAL FOR ALL CONDUITS.
	FLEXIBLE CONDUIT CONCEALED. NUMBER OF HASH MARKS DENOTES QUANTITY OF WIRES. CURVED HASH MARK DENOTES QUANTITY OF #12 GREEN GROUND WIRES. CONDUCTORS OTHER THAN #12 ARE INDICATED ON PLANS. NO HASH MARKS DENOTES 2 #12 AWG AND 1 #12 GREEN GROUND IN 1/2" MINIMUM DIAMETER CONDUIT.
	CONDUIT RUN UNDERFLOOR OR UNDERGROUND MINIMUM 1" DIAMETER.
	CONDUIT HOMERUN TO PANELBOARD, SWITCHBOARD OR TERMINAL CABINET
	EXISTING CONDUIT AND WIRING
	PANELBOARD - FLUSH MOUNTED
	TERMINAL CABINET
	SWITCHBOARD, DISTRIBUTION PANEL, OR MOTOR CONTROL CENTER
	DRAWING SHEET NUMBERED NOTE DESIGNATION - APPLIES TO NUMBERED NOTE ON SAME SHEET
	DRAWING PLAN OR DETAIL DESIGNATION - "1" OR "A" DENOTES PLAN OR DETAIL NUMBER, "E-1" DENOTES SHEET NUMBER

SYMBOL LIST NOTES:

1. EXISTING ELECTRICAL EQUIPMENT, OUTLETS, AND DEVICES ARE SHOWN THE SAME AS NEW, EXCEPT LIGHTLY AND ACCOMPANIED BY (E). SUCH ELECTRICAL EQUIPMENT, OUTLETS, AND DEVICES ARE TO REMAIN AS IS, UNLESS OTHERWISE NOTED ON PLAN OR SPECIFICATION.
2. VERIFY ON SITE THAT ALL PANELBOARDS HAVE MINIMUM WORKING SPACES PER CODE AND THAT THE DEDICATED PANELBOARD SPACES ARE CLEAR OF ALL DUCTS, PIPING AND EQUIPMENT FOREIGN TO THE PANEL BOARDS. NOTIFY THE ENGINEER FOR CORRECTIVE ACTION IN THE EVENT THAT FOREIGN OBJECTS IMPEDE THE DEDICATED PANELBOARD AREAS.
3. WHERE CONDUIT STUB IS INDICATED, PROVIDE CONDUIT WITH BUSHING AT THE END OF CONDUIT AND PULL ROPE INTO ACCESSIBLE CEILING AREA.

ELECTRICAL SHEET INDEX

No. OF SHEETS	DRAWING No.	DRAWING DESCRIPTIONS
1	E0.1	COVER SHEET - ELECTRICAL
2	E1.1	SITE PLAN PLAN - ELECTRICAL, ONE LINE DIAGRAM, PANEL SCHEDULE
3	E2.0	PARTIAL FLOOR PLAN - ELECTRICAL DEMOLITION
4	E2.1	PARTIAL FLOOR PLAN - LIGHTING AND SIGNAL
5	E2.2	PARTIAL FLOOR PLAN - POWER
6	E2.3	PARTIAL FLOOR PLAN - FIRE ALARM
7	E4.1	FIRE ALARM DIAGRAMS, FA EQUIPMENT
8	E5.1	ELECTRICAL DETAILS
9	E6.1	T24 COMPLIANCE FORMS

ABBREVIATIONS

A	AMPERES	GND	GROUND
AC	ABOVE CEILING	IDF	INTERMEDIATE DISTRIBUTION FRAME
A.F.F.	ABOVE FINISHED FLOOR	MAX.	MAXIMUM
APPROX	APPROXIMATE	MIN.	MINIMUM
AWG	AMERICAN WIRE GAUGE	(N)	NEW
BKR	BREAKER	NEMA	NATIONAL ELECTRICAL MANUFACTURER ASSOCIATION
C.	CONDUIT	QTY	QUANTITY
C.B.	CIRCUIT BREAKER	THW	INSULATED STRAND WIRE
CKT	CIRCUIT	THHN	NYLON JACKETED WIRE
C.O.	CONDUIT ONLY, WITH PULL WIRE	UG	UNDERGROUND
(E)	EXISTING	UL	UNDERWRITERS LABORATORY
(F)	FUTURE	UON	UNLESS OTHERWISE NOTED
FA	FIRE ALARM	WP	WEATHER PROTECTED
GA.	GAUGE	XHHW	CROSS-LINKED POLYETHYLENE WIRE INSULATED

APPROVALS

PO Box 1900
Yuba City, CA 95992-1900
530.298.7298
www.spinc-arch.com

ARCHITECTURAL • COMMERCIAL • RESIDENTIAL • INTERIOR • CONSTRUCTION MANAGEMENT



SYNTHESIS PARTNERS, LLC
Managers • Architects

M. NEILS
ENGINEERING, INC.

Electrical Engineers | Lighting Designers
100 Howe Ave., Suite 235N
Sacramento, CA 95825-8217
www.mneilsengineering.com
Tel: (916) 923-4400 Fax: (916) 923-4410
PROJECT #: 22133.21

OWNER

Woodland Joint Unified School District
435 6th Street
Woodland, CA 95695

PROJECT

CLASSROOM CONVERSIONS
at
WOODLAND EDUCATION CENTER
575 Hays Street
Woodland, CA 95695

KEY PLAN



02/13/2023


NO.	REVISION DESCRIPTION	DATE

COVER SHEET - ELECTRICAL


E0.1

DATE 2022-07-29
PROJECT NO. 21-W04-01

Feb 13, 2023 - 3:41pm / sglisic
 UNAUTHORIZED CHANGES & USES: M. Neils Engineering, Inc. Preparing these plans will not be responsible for, or liable for unauthorized changes to or uses to these plans. All changes to these plans must be in writing and must be approved by M. Neils Engineering, Inc.

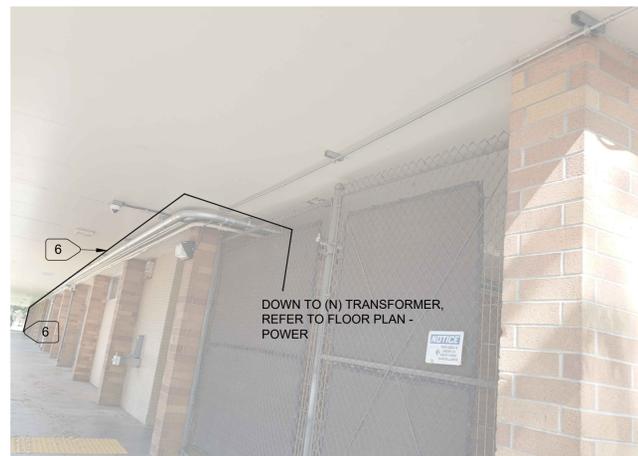

1 SITE PLAN AND ELEVATION - ELECTRICAL
 E1.1 N.T.S.

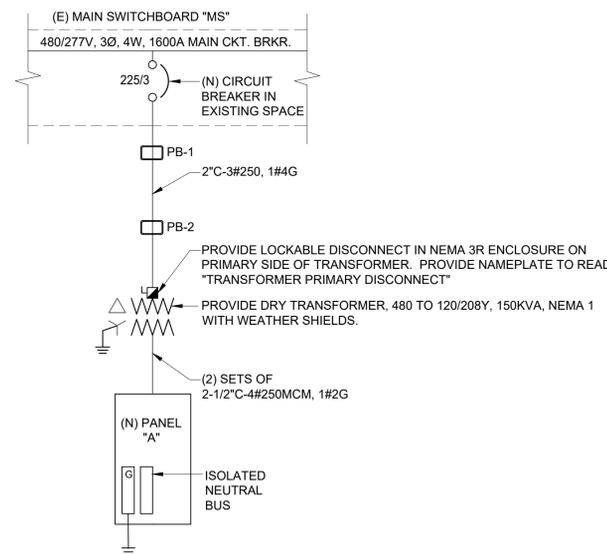

2 ONE LINE DIAGRAM - POWER
 E1.1 N.T.S.

NUMBERED NOTES:

- 1 PROVIDE (N) CIRCUIT BREAKER IN (E) SPACE. REFER TO ONE LINE DIAGRAM - POWER.
- 2 REFER TO ONE LINE DIAGRAM - POWER.
- 3 DIRECTIONAL BORE.
- 4 PROVIDE N40 PULLBOX, STEEL LID WITH HOLD-DOWN BOLTS AND (2) EXTENSION - SEE 3/E5.1.
- 5 REFER TO BUILDING PHOTO BELOW FOR CONTINUATION.
- 6 BRING (N) FEEDER UP COLUMN, AND CONTINUE RUN SIMILAR TO (E) CONDUITS. PROVIDE SUPPORT SIMILAR TO (E) CONDUIT SUPPORT.
- 7 TRENCH PER 4/E5.1.

NEW PANEL "A" SCHEDULE

POWER SOURCE: MAIN SWITCHBOARD VIA TRANSFORMER "TR"		LOCATION: SEE PLAN			
SYSTEM: NORMAL BRANCH					
TYPE:	BUS: 600 AMPS	MAIN BKR 500A	VOLTAGE: 208Y/120 VOLT, 3 PHASE, 4 WIRES	MOUNTING: SURFACE PANEL TYPE NEMA 1	REMARKS: 10k AIC MIN. SYMM.
LOAD SERVED	KVA	CB	CKT PHASE CKT	CB KVA	LOAD SERVED
RCPT - 104	0.8	20/1	1 A 2		7.0
RCPT - 106	0.8	20/1	3 B 4	60/3	RANGE
CNC MILL	3.2	40/2	5 C 6		7.0
RCPT - 106	0.8	20/1	7 A 8		7.0
ROUTER	1.4	20/1	9 B 10	60/3	RANGE
ROUTER	1.4	20/1	11 C 12		7.0
ROUTER	1.4	20/1	13 A 14		7.2
ROUTER	1.4	20/1	15 B 16	75/3	OVEN
ROUTER	1.4	20/1	17 C 18		7.2
SPARE		20/1	19 A 20	20/1	PROOFING CABINET
CNC MILL	3.2	40/2	21 B 22	20/2	5.15 RECEPTACLE PIZZA OVEN
CNC MILL	3.2	40/2	23 C 24		5.15
CNC MILL	3.2	40/2	25 A 26		1.1
SPARE		20/1	27 B 28	20/3	1.1 MIXER
CNC LATHE	3.2	40/2	29 C 30		1.1
CNC LATHE	3.2	40/2	31 A 32		1.1 DOUGH SHEETER
CNC LATHE	3.2	40/2	33 B 34	20/2	1.1
CNC LATHE	3.2	40/2	35 C 36	20/1	0.6 RECEPT REFRIGERATOR
MANUFACTURING AIR COMPRESSOR	2.4	40/2	37 A 38	20/1	1.4 RECEPT FREEZER
DENTAL CHAIR	1.0	20/1	39 B 40	20/1	1.2 DISHWASHER
DENTAL CHAIR	1.0	20/1	41 C 42	20/1	1.5 ICE MACHINE
DENTAL CHAIR	1.0	20/1	43 A 44	20/1	0.6 RECEPT PREP TABLE
DENTAL CHAIR	1.0	20/1	45 B 46		0.7
DENTAL CHAIR	1.0	20/1	47 C 48	20/3	0.7 KEF-1
MAU-1	1.4	20/3	49 A 50		0.7
MAU-1	1.4	20/3	51 B 52	20/1	LIGHT EXHAUST HOOD
MAU-1	1.4	20/3	53 C 54	20/1	0.2 KEF-2
COCOON	0.5	20/1	55 A 56	20/1	0.4 RECEPT MEAT SLICER
DENTAL CAMERA	0.5	20/1	57 B 58	20/1	0.7 RECEPT MIXER
DENTAL VACUUM	1.1	15/2	59 C 60	20/1	1.5 RECEPT MIXER
DENTAL VACUUM	1.1	15/2	61 A 62	20/1	1.8 RCPT TOP STOVE BURNER
DENTAL AUTCLAVE	1.5	20/1	63 B 64	20/1	1.8 RCPT TOP STOVE BURNER
DENTAL AIR COMPRESSOR	0.5	20/2	65 C 66	20/1	1.8 RCPT TOP STOVE BURNER
DENTAL AIR COMPRESSOR	0.5	20/2	67 A 68	20/1	1.8 RCPT TOP STOVE BURNER
XRAY	1.2	20/1	69 B 70	20/1	0.8 RCPT FOOD PROCESSOR
XRAY	1.2	20/1	71 C 72	20/1	1.7 RECEPT MICROWAVE
DENTAL AUTCLAVE	1.5	20/1	73 A 74	20/1	1.8 RECEPT TOASTER
GWH-1/CP-1	0.3	20/1	75 B 76	20/1 [1]	0.5 FIRE SUPPRESSION SYST.
GAS SHUTDOWN	0.3	20/1	77 C 78	20/1	0.5 SHUNT TRIP POWER
IWH-1	3.1	40/2	79 A 80	PFB	SPACE
IWH-1	3.1	40/2	81 B 82	PFB	SPACE
SPACE		PFB	83 C 84	PFB	SPACE

NOTES:
 [1] PROVIDE WITH RED HANDEL AND LOCKING DEVICE

CONNECTED LOAD	
PHASE A=	57.3 KVA
PHASE B=	58.2 KVA
PHASE C=	56.1 KVA
TOTAL =	171.6 KVA
TOTAL =	476.7 Amperes

©2023 Synthesis Partners, LLC. All Rights Reserved. These record drawings have been prepared based upon information submitted, in part, by others. While this information is believed to be reliable, The Architect is not responsible for their accuracy, nor for errors or omissions which may have been incorporated into these documents as a result.

PO Box 1900
 Yuba City, CA 95992-1900
 530.298.7298
 www.spinc-arch.com


INSTITUTIONAL • COMMERCIAL • RESIDENTIAL • INTERIOR • CONSTRUCTION MANAGEMENT



M. NEILS
 ENGINEERING, INC.
 Electrical Engineers | Lighting Designers
 100 Howe Ave., Suite 235N
 Sacramento, CA 95825-8217
 www.mneilsengineering.com
 Tel: (916) 923-4400 Fax: (916) 923-4410
 PROJECT #: 22133.21

OWNER
 Woodland Joint Unified School District
 435 6th Street
 Woodland, CA 95695

PROJECT
 CLASSROOM CONVERSIONS
 at
 WOODLAND EDUCATION
 CENTER
 575 Hays Street
 Woodland, CA 95695

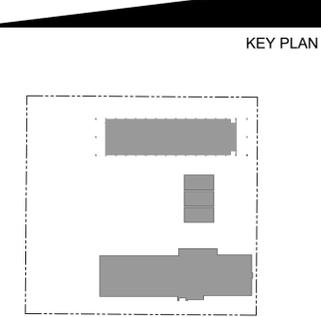

KEY PLAN

REGISTERED PROFESSIONAL ENGINEER
 JESSE U. BASTIAN
 No. E20229
 Exp. 03-31-23
 ELECTRICAL
 STATE OF CALIFORNIA
 02/13/2023


NO.	REVISION DESCRIPTION	DATE

SITE PLAN - ELECTRICAL
ONE LINE DIAGRAM, PANEL SCHEDULE

E1.1

DATE: 2022-07-29
 PROJECT NO.: 21-W04-01

Feb 12, 2023 - 11:29am / sgljic
 UNAUTHORIZED CHANGES & USES: M. Neils Engineering, Inc. Preparing these plans will not be responsible for, or liable for unauthorized changes to or uses to these plans. All changes to these plans must be in writing and must be approved by M. Neils Engineering, Inc.

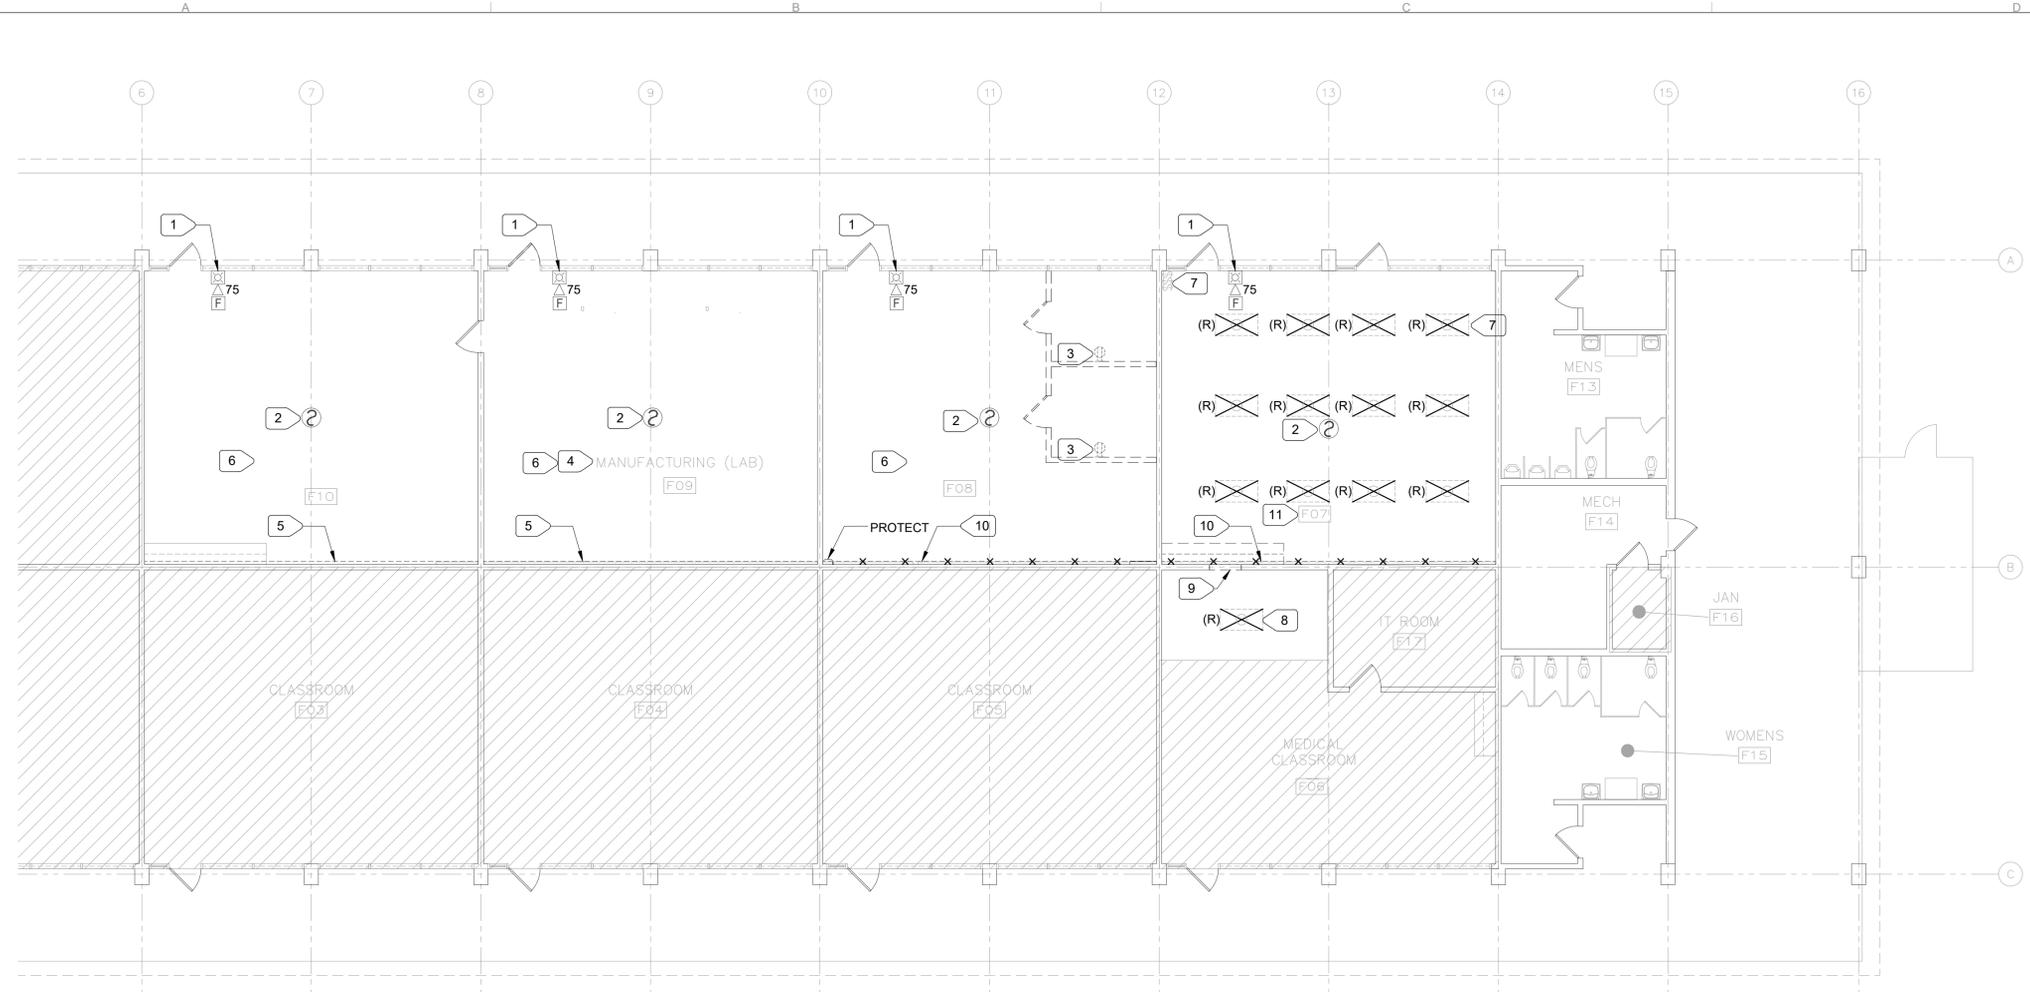

1 PARTIAL FLOOR PLAN - ELECTRICAL DEMOLITION
 E2.0 SCALE: 1/8" = 1'-0"

- NUMBERED NOTES:**
- 1 CAREFULLY DISCONNECT HORN/STROBE AND PREPARE TO RELOCATE AS SHOWN ON FLOOR PLAN - FIRE ALARM. PROTECT (E) FIRE ALARM WIRING. PROTECT (E) FIRE ALARM PULL STATION IN PLACE.
 - 2 CAREFULLY DISCONNECT SMOKE DETECTOR AND PREPARE TO RELOCATE AS SHOWN ON FLOOR PLAN - FIRE ALARM. PROTECT (E) FIRE ALARM WIRING.
 - 3 DISCONNECT RECEPTACLE. REMOVE WIRING BACK TO LAST REMAINING RECEPTACLE. INSURE CONTINUITY OF POWER CIRCUIT.
 - 4 DISCONNECT AND REMOVE (E) SURFACE MOUNTED RECEPTACLES AND ASSOCIATED WIREMOLD. PROTECT (E) FLUSH MOUNTED RECEPTACLES. INSURE REMAINING RECEPTACLES CIRCUITS CONTINUITY.
 - 5 PROTECT (E) SURFACE DATA RACEWAY, LOCATED JUST ABOVE FLOOR.
 - 6 PROTECT (E) DATA, INTERCOM, AND INTRUSION ALARM EQUIPMENT.
 - 7 REMOVE (E) LIGHT FIXTURE AND ASSOCIATED LIGHT SWITCHES. PROTECT LIGHTING POWER CIRCUIT FOR REUSE. TYPICAL IN CLASSROOM F07.
 - 8 REMOVE (E) LIGHT FIXTURE. RECONNECT (E) LIGHTING CIRCUIT IN CLASSROOM F06 SUCH THAT REMAINING LIGHT FIXTURES WORK CORRECTLY.
 - 9 WALL DEMOLITION FOR (N) DOOR. REROUTE (E) CONDUIT/CONDUCTORS AROUND (N) WALL OPENING.
 - 10 CAREFULLY DISCONNECT DATA CABLING RUNNING IN SURFACE RACEWAY JUST ABOVE FLOOR AND PROTECT FOR REUSE. REMOVE SURFACE RACEWAY COMPLETELY IN CLASSROOM F07, AND PARTIALLY IN CLASSROOM F08.
 - 11 REMOVE ALL POWER RECEPTACES AND DATA OUTLET FROM THIS CLASSROOM - EXCEPT WIRELESS ACCESS POINT. REMOVE POWER WIRING TO LAST REMAINING OUTLET - INSURE CIRCUIT CONTINUITY. REMOVE DATA WIRING BACK TO (E) IDF. PROTECT (E) INTRUSION ALARM AND CLOCK/INTERCOM.

©2023 Synthesis Partners, LLC. All Rights Reserved
 These record drawings have been prepared based upon information submitted, in part, by others. While this information is believed to be reliable, The Architect is not responsible for their accuracy, nor for errors or omissions which may have been incorporated into these documents as a result.

APPROVALS
 PO Box 1900
 Yuba City, CA 95992-1900
 530.298.7298
 www.spinc-arch.com

ARCHITECTURAL • COMMERCIAL • RESIDENTIAL • INTERIOR • CONSTRUCTION MANAGEMENT




SYNTHESIS PARTNERS, LLC
 Managers • Architects

M. NEILS ENGINEERING, INC.
 Electrical Engineers | Lighting Designers
 100 Howe Ave., Suite 235N
 Sacramento, CA 95825-8217
 www.mneilsengineering.com
 Tel: (916) 923-4400 Fax: (916) 923-4410
 PROJECT #: 22133.21

OWNER
 Woodland Joint Unified School District
 435 6th Street
 Woodland, CA 95695

PROJECT
 CLASSROOM CONVERSIONS
 at
 WOODLAND EDUCATION CENTER
 575 Hays Street
 Woodland, CA 95695

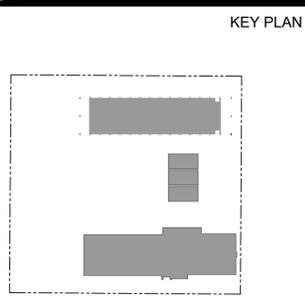


REGISTERED PROFESSIONAL ENGINEER
 JESSE U. BASTIAN
 No. E20229
 Exp. 03-31-23
Jesse Bastian
 ELECTRICAL
 STATE OF CALIFORNIA
 02/13/2023

NO.	REVISION DESCRIPTION	DATE


PARTIAL FLOOR PLAN - DEMOLITION

E2.0
 DATE 2022-07-29
 PROJECT NO. 21-W04-01

Feb 12, 2023 - 11:29am / sgljic
 UNAUTHORIZED CHANGES & USES: M. Neils Engineering, Inc. Preparing these plans will not be responsible for, or liable for unauthorized changes to or uses to these plans. All changes to these plans must be in writing and must be approved by M. Neils Engineering, Inc.

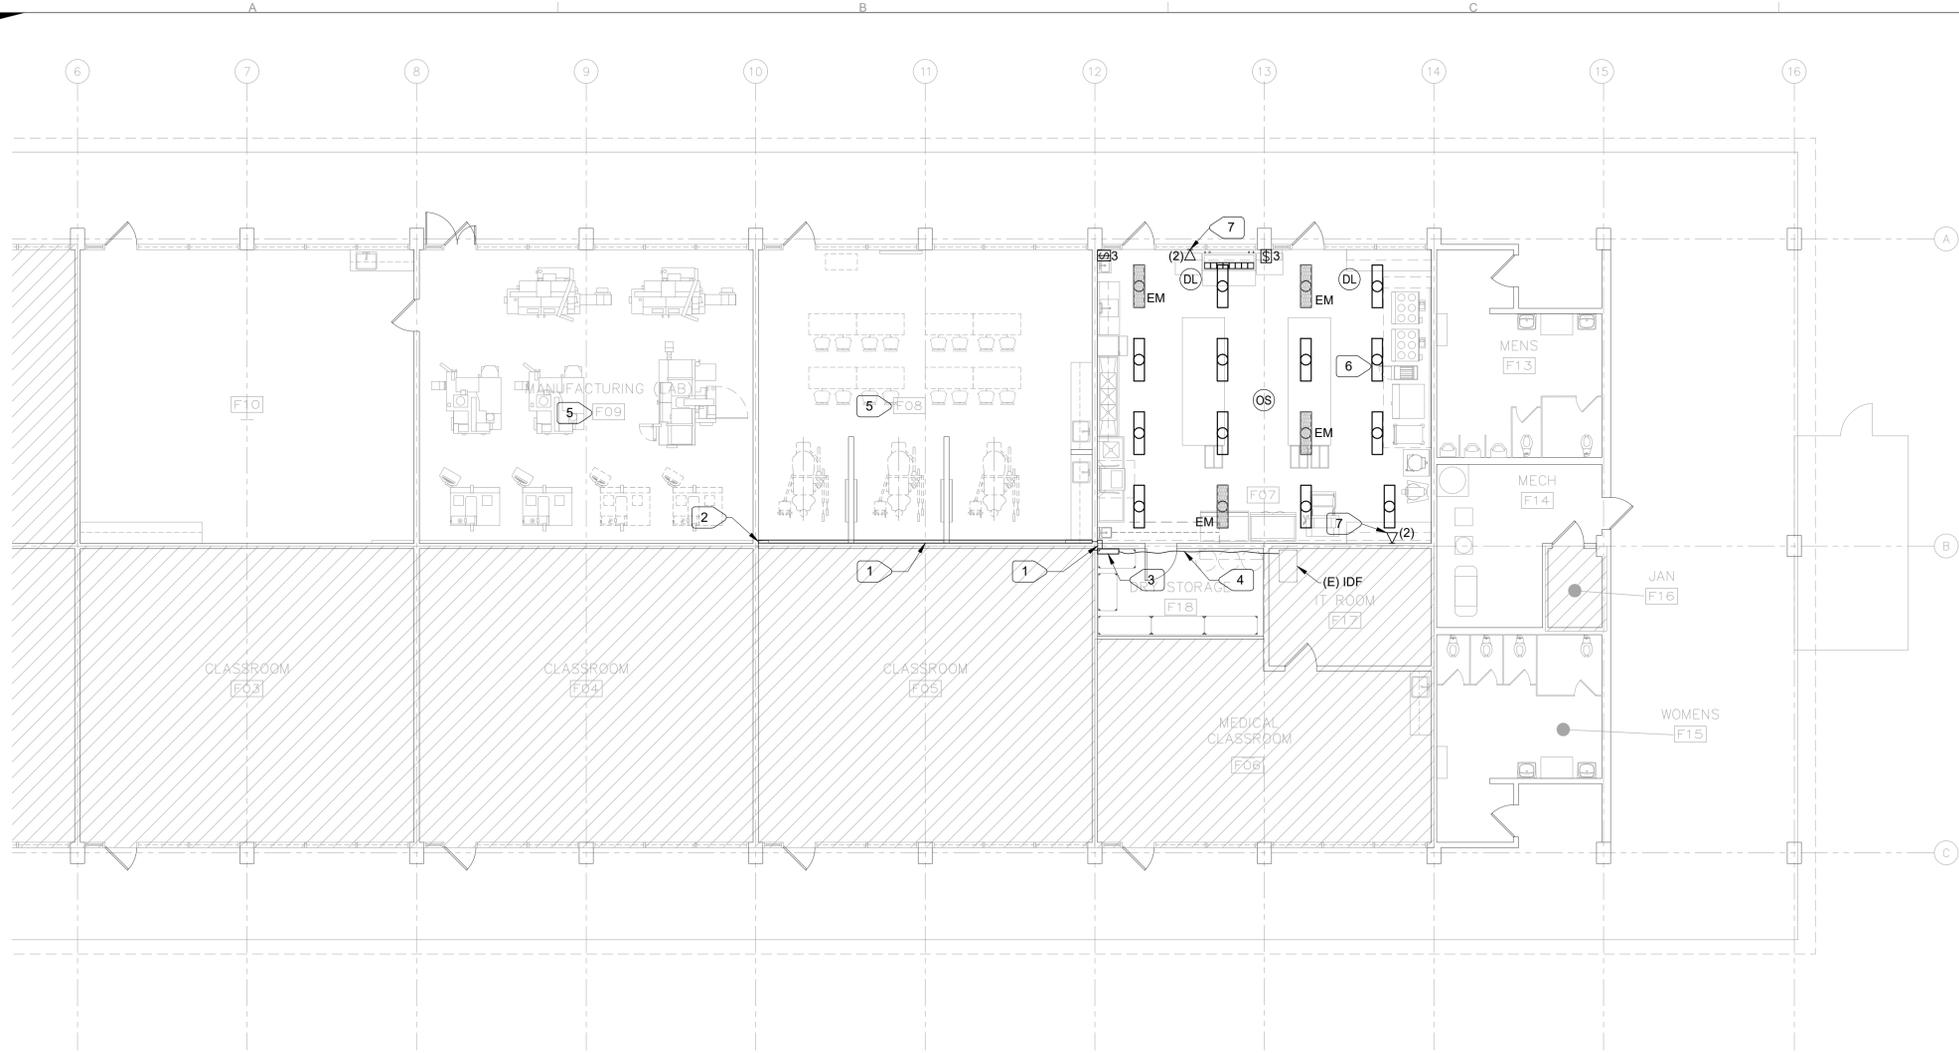

1 PARTIAL FLOOR PLAN - LIGHTING AND SIGNAL
 E2.1 SCALE: 1/8" = 1'-0"

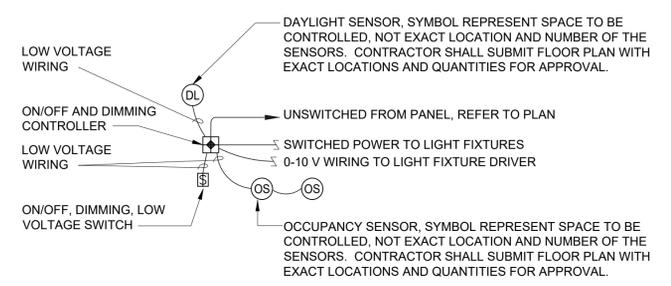

LIGHTING CONTROL DIAGRAM

GENERAL NOTES:

- CONTRACTOR SHALL VISIT SITE BEFORE BID AND REVIEW EXISTING CONDITIONS - NUMBER OF DATA CABLES TO BE REROUTED/EXTENDED.
- PROVIDE ALL PARTS AND PIECES NECESSARY TO PROVIDE ENCLOSED RACEWAY FOR DATA AND TO CONNECT TO (E) DATA RACEWAY IN ROOM F08.
- ALL NEW DATA EQUIPMENT SHALL MATCH EXISTING - COORDINATE WITH OWNER IT DEPARTMENT BEFORE ORDERING.
- COORDINATE EXACT LOCATION OF NEW DATA OUTLETS IN F07 WITH ARCHITECT BEFORE ROUGH IN.

NUMBERED NOTES:

- PROVIDE STEEL SURFACE RACEWAY, WIREMOLD SERIES 4000 OR SIMILAR. MOUNT HIGH ON WALL JUST BELOW CEILING. RUN (E) DATA CABLING (SEE SHEET E2.0, NUMBERED NOTE 10) THROUGH (N) RACEWAY.
- PROVIDE SLEEVE CONDUITS THROUGH WALL; RUN (N) RACEWAY, WIREMOLD SERIES 4000 VERTICALLY DOWN TO (E) SALVAGED DATA RACEWAY (SEE SHEET E2.0, NUMBERED NOTE 10). TERMINATE (N) RACEWAY TO (E) RACEWAY.
- PROVIDE (2) (N) 48 PORT DATA PATCH PANELS. TERMINATE (E) DATA CABLES AT THIS PATCH PANEL. MOUNT PATCH PANELS (PROVIDE WALL MOUNT BRACKETS HOFFMAN HB2) HIGH ON WALL. WIGHT OF PATCH PANELS AND BRACKET 11.92lb.
- PROVIDE (N) DATA CABLES FROM (N) PATCH PANELS TO (E) IDF. (N) CABLES TO MATCH (E) DATA CABLES. RUN (N) DATA CABLING HIGH ON WALL SUPPORTED BY J-HOOKS. PROVIDE J-HOOK MAX. 12" FROM WALLS AND MAX. 36" BETWEEN. NUMBER OF (N) CABLES SHALL MATCH (E) DATA CABLES.
- REROUTE (E) DATA CABLES IN THIS CLASSROOM TO ADJUST TO (N) DATA RACEWAY. PROVIDE ADDITIONAL SURFACE RACEWAY AS NECESSARY.
- SEE 6/E5.1 FOR INSTALLATION, TYPICAL FOR LIGHT FIXTURES.
- PROVIDE (2) CAT6 CABLES FROM DATA OUTLET TO IDF. COORDINATE EXACT LOCATION WITH ARCHITECT BEFORE ROUGH IN.

©2023 Synthesis Partners, LLC All Rights Reserved
 These record drawings have been prepared based upon information submitted, in part, by others. While this information is believed to be reliable, The Architect is not responsible for their accuracy, nor for errors or omissions which may have been incorporated into these documents as a result.

APPROVALS
 PO Box 1900
 Yuba City, CA 95992-1900
 530.298.7298
 www.spinc-arch.com

ARCHITECTURAL • COMMERCIAL • RESIDENTIAL • INTERIOR • CONSTRUCTION MANAGEMENT



SYNTHESIS PARTNERS, LLC
 Managers • Architects


M. NEILS ENGINEERING, INC.
 Electrical Engineers | Lighting Designers
 100 Howe Ave., Suite 235N
 Sacramento, CA 95825-8217
 www.mneilsengineering.com
 Tel: (916) 923-4400 Fax: (916) 923-4410
 PROJECT #: 22133.21

OWNER

Woodland Joint Unified School District
 435 6th Street
 Woodland, CA 95695

PROJECT
CLASSROOM CONVERSIONS
 at
WOODLAND EDUCATION CENTER
 575 Hays Street
 Woodland, CA 95695

KEY PLAN

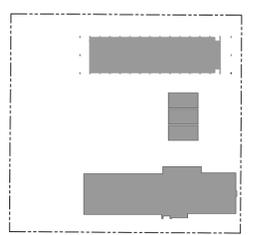


NO.	REVISION DESCRIPTION	DATE

PARTIAL FLOOR PLAN - LIGHTING AND SIGNAL

E2.1

DATE	2022-07-29
PROJECT NO.	21-W04-01

Feb 12, 2023 - 11:29am / sgljic UNAUTHORIZED CHANGES & USES: M. Neils Engineering, Inc. Preparing these plans will not be responsible for, or liable for unauthorized changes to or uses to these plans. All changes to these plans must be in writing and must be approved by M. Neils Engineering, Inc.

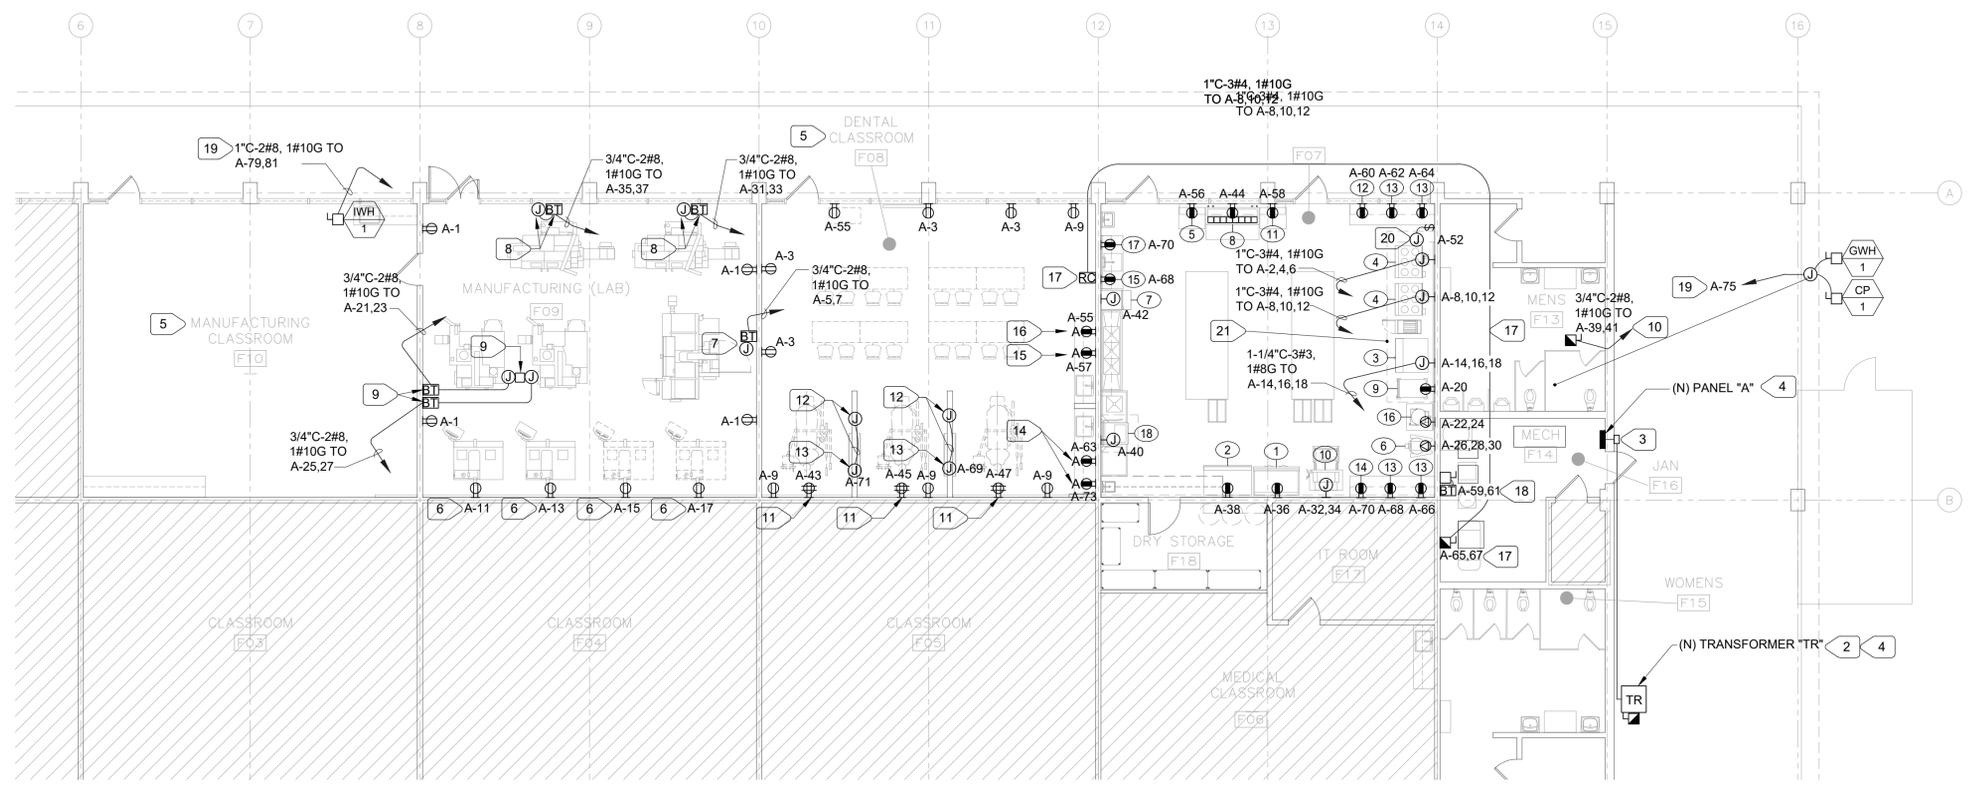


1 PARTIAL FLOOR PLAN - POWER
E2.2 SCALE: 1/8" = 1'-0"

Item #	Description	Qty	Manufacturer	Model	Power (kVA)	Amps (A)	Volts (V)	Phase	Plug Provided	Notes
1	2-Door Refrigerator	1	Beverage Air	RB49HC-1S	0.6	5.4	120	1	NEMA 5-15P	
2	2-Door Freezer	1	Entree	CF2	1.4	12.0	120	1	NEMA 5-15P	
3	Oven	1	Doyon	JA12SL	21.5	59.7	208	3	HARDWARE	
4	Range	2	Imperial	IR-6-E-C	20.880	58.0	208	3	HARDWARE	
5	Meat Slicer	1	Bizerba	GSP V2-150 GSPHV	0.396	3.3	120	1	NEMA 5-15P	Countertop
6	Planetary Mixer	1	Globe	SP40		12.0	240	3		
7	Ice Machine	1	Manitowoc	1DT0620A-161 Indigo NXT	1.464	12.2	120	1	HARDWARE	
8	Prep Table	1	Beverage Air	SP66HC-16C	0.648	5.4	120	1	NEMA 5-15P	
9	Proofing Cabinet	1	Serv-Ware	5C1836HPI	1.440	12.0	120	1	NEMA 5-15P	
10	Dough Sheeter	1	AMPTO	CS-500	2.238	6.2	208	1	HARDWARE	(2) 1-1/2HP Motors
11	Planetary Mixer	1	Globe	SP20	0.720	6.0	120	1	NEMA 5-15P	Countertop
12	Planetary Mixer	1	Serv-Ware	PM30-PTO	1.492	12.4	120	1	NEMA 5-15P	
13	Induction Table Top Stove Burners	4	Vollrath	59300	1.800	15.0	120	1	NEMA 5-15P	Countertop
14	Food Processor	1	Robot Coupe	R2N	0.840	7.0	120	1	NEMA 5-15P	Countertop
15	Microwave Oven	1	Amana	HDC1015	1.728	14.4	120	1	NEMA 5-15P	Countertop
16	Pizza Oven	1	TurboChef	Fire FRE-9600-1	3.700	10.3	208	1	NEMA 6-30P	Countertop
17	Toaster	1	Waring	CTS1000	1.800	15.0	120	1	NEMA 5-15P	Countertop
18	Dishwasher	1	Jackson WWS	Conservex XL-E	1.200	10.0	120	1	HARDWARE	

NUMBERED NOTES:

- 1 REFER TO SHEET E1.1 FOR CONDUIT RUN.
- 2 INSTALL TRANSFORMER PER 1/E0.1. REFER TO ONE LINE DIAGRAM POWER FOR TRANSFORMER REQUIREMENTS.
- 3 SEE 7/E5.1.
- 4 COORDINATE EXACT LOCATION WITH THE ARCHITECT BEFORE ROUGH IN. SEE 2/E5.1 FOR INSTALLATION.
- 5 NO ADDITIONAL POWER IN THIS SPACE.
- 6 FOR ROUTER MILL. COORDINATE EXACT INSTALLATION HEIGHT WITH THE ARCHITECT BEFORE ROUGH IN.
- 7 FOR CNC MILL. PROVIDE BUCK-BOOST TRANSFORMER, 1KVA, 208 TO 220V. RUN 2#8, 1#10G IN STEEL FLEX TO THE MILL CONNECTORS. PROVIDE SUPPORT FOR FLEX PER CEC. COORDINATE EXACT LOCATION WITH THE ARCHITECT BEFORE ROUGH IN.
- 8 FOR CNC LATE. PROVIDE BUCK-BOOST TRANSFORMER, 1KVA, 208 TO 220V. RUN 2#8, 1#10G IN STEEL FLEX TO THE MILL CONNECTORS. PROVIDE SUPPORT FOR FLEX PER CEC. COORDINATE EXACT LOCATION WITH THE ARCHITECT BEFORE ROUGH IN.
- 9 FOR CNC MILL. PROVIDE BUCK-BOOST TRANSFORMER, 1KVA, 208 TO 220V. MOUNT ON WALL AS DIRECTED BY ARCHITECT. RUN 2#4, 1#10G IN STEEL SURFACE RACEWAY UP WALL, THEN ON CEILING TO POWER POLE. INSTALL POWER POLE PER 5/E0.1. RUN 2#8, 1#10G THROUGH POWER POLE TO EACH CNC MILL. FROM POWER POLE PROVIDE STEEL FLEX TO THE MILL CONNECTORS. COORDINATE EXACT LOCATION WITH THE ARCHITECT BEFORE ROUGH IN.
- 10 FOR MANUFACTURING AIR COMPRESSOR. RUN 2#8, 1#10G IN STEEL FLEX TO COMPRESSOR CONNECTORS. PROVIDE SUPPORT FOR FLEX PER CEC. COORDINATE EXACT LOCATION WITH THE ARCHITECT BEFORE ROUGH IN.
- 11 FOR DENTAL CHAIR.
- 12 FOR X-RAY CONTROL PANEL. PROVIDE 1" NONMETALLIC CONDUIT BETWEEN LOCATION OF X-RAY AND J-BOX FOR CONTROL PANEL FOR CONTROL WIRING INSTALLATION PER X-RAY INSTALLATION INSTRUCTION. COORDINATE EXACT LOCATION AND HEIGHT BEFORE ROUGH IN.
- 13 FOR X-RAY. INSTALL J-BOX IN OPENING, PER X-RAY INSTALLATION INSTRUCTION. COORDINATE EXACT LOCATION AND HEIGHT BEFORE ROUGH IN.
- 14 FOR AUTOCLAVE.
- 15 FOR CHARGING CAMERA.
- 16 FOR CHARGING HAND HELD X-RAY (COCOON).
- 17 FOR DENTAL AIR COMPRESSOR. PROVIDE 1/2"-3#14 BETWEEN COMPRESSOR AND REMOTE PANEL. EXACT LOCATION SHALL BE COORDINATED WITH THE ARCHITECT BEFORE ROUGH IN.
- 18 FOR DENTAL VACUUM. PROVIDE BUCK-BOOST TRANSFORMER, 1KVA, 208 TO 230V. EXACT LOCATION SHALL BE COORDINATED WITH THE ARCHITECT BEFORE ROUGH IN.
- 19 COORDINATE WITH PLUMBING BEFORE ROUGH IN.
- 20 KITCHEN HOOD LIGHTS, PROVIDE SWITCH AS DIRECTED BY KITCHEN CONTRACTOR.
- 21 ALL POWER UNDER HOOD SHALL BE TURNED OFF UPON FIRE SUPPRESSION SYSTEM ACTIVATION. SEE DIAGRAM 2/E4.1.

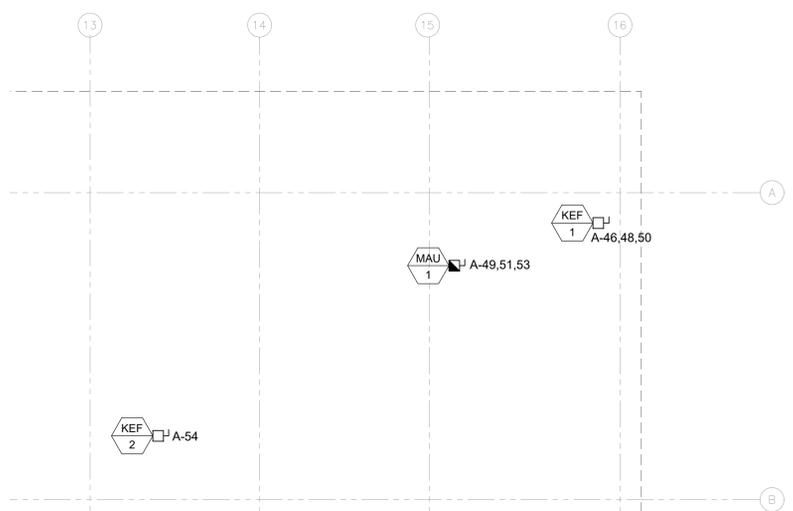

2 PARTIAL ROOF PLAN - POWER
E2.2 SCALE: 1/8" = 1'-0"

©2023 Synthesis Partners, LLC. All Rights Reserved. These record drawings have been prepared based upon information submitted, in part, by others. While this information is believed to be reliable, the Architect is not responsible for their accuracy, nor for errors or omissions which may have been incorporated into these documents as a result.

PO Box 1900
Yuba City, CA 95992-1900
530.298.7298
www.spinc-arch.com



SYNTHESIS PARTNERS, LLC
Managers • Architects


M. NEILS ENGINEERING, INC.
Electrical Engineers | Lighting Designers
100 Howe Ave., Suite 235N
Sacramento, CA 95825-8217
www.mneilsengineering.com
Tel: (916) 923-4400 Fax: (916) 923-4410
PROJECT #: 22133.21

OWNER

Woodland Joint Unified School District
435 6th Street
Woodland, CA 95695

PROJECT
CLASSROOM CONVERSIONS
at
WOODLAND EDUCATION CENTER
575 Hays Street
Woodland, CA 95695

KEY PLAN

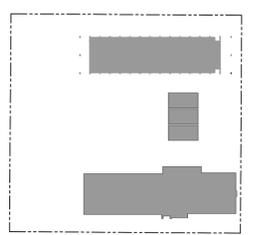


NO.	REVISION DESCRIPTION	DATE

PARTIAL FLOOR PLAN - POWER

DATE 2022-07-29
PROJECT NO. 21-W04-01

E2.2

Feb 12, 2023 - 11:29am, / sgljic
 UNAUTHORIZED CHANGES & USES: M. Neils Engineering, Inc. Preparing these plans will not be responsible for, or liable for unauthorized changes to or uses to these plans. All changes to these plans must be in writing and must be approved by M. Neils Engineering, Inc.

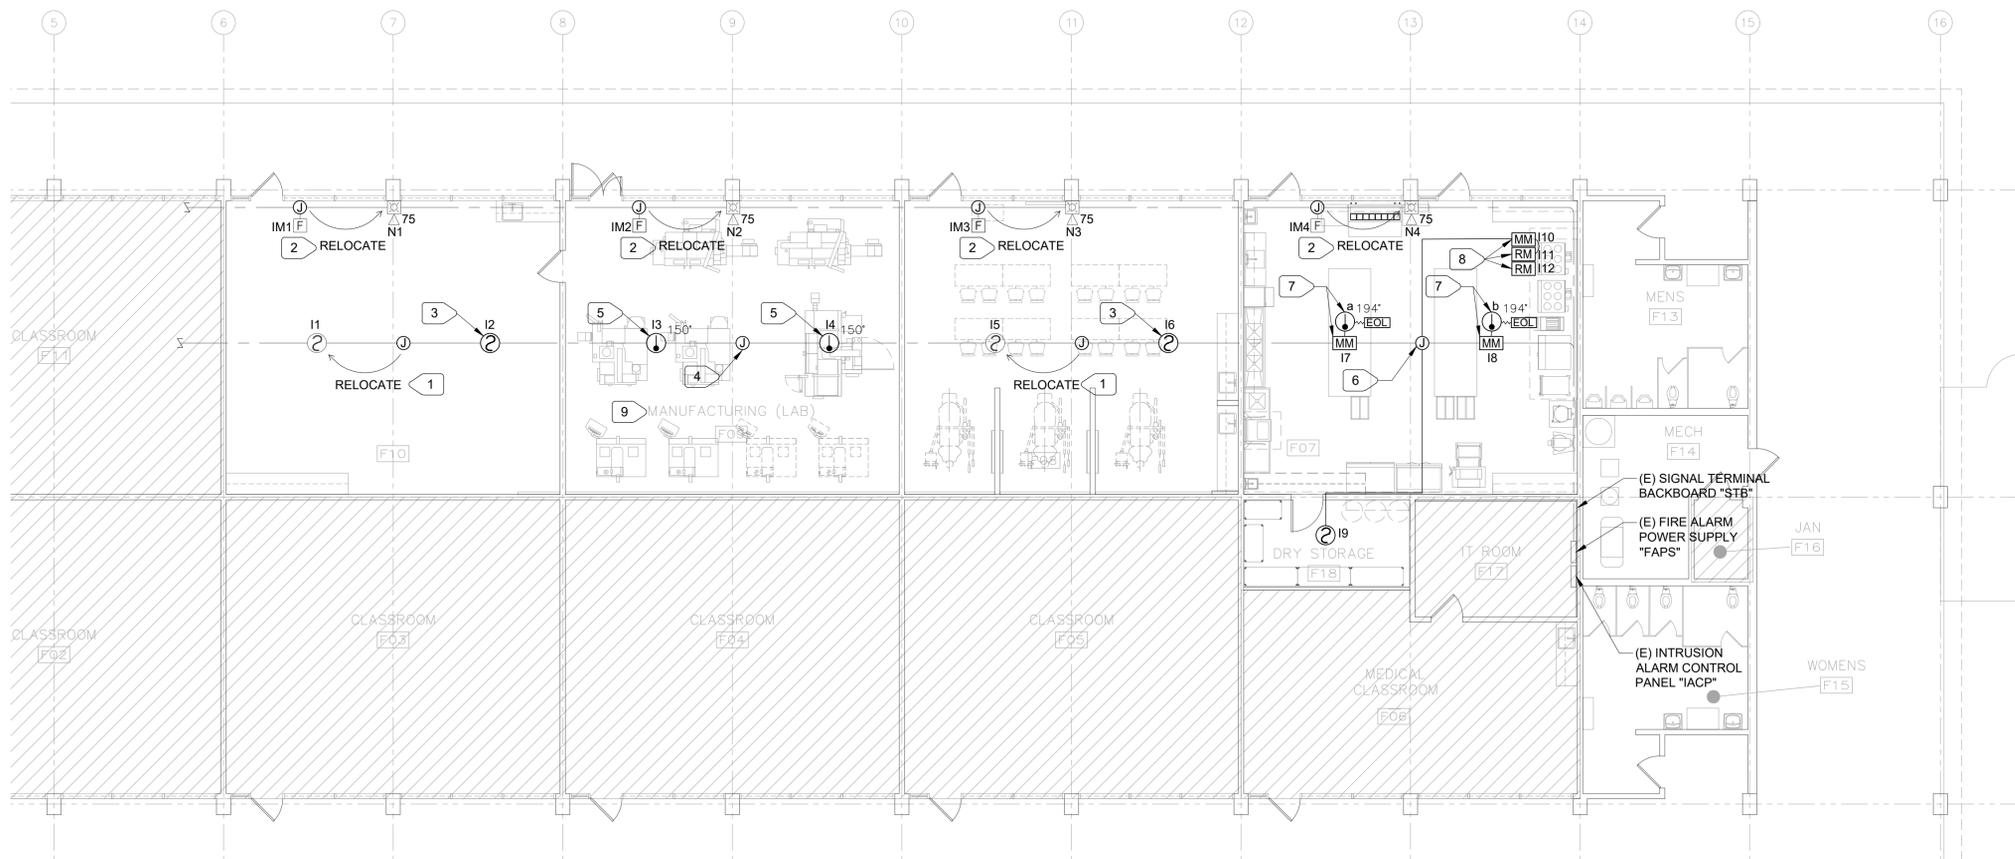

CHAPTER 14 UPON COMPLETION OF FIRE ALARM SCOPE.
1 PARTIAL FLOOR PLAN - FIRE ALARM
 E2.3 SCALE: 1/8" = 1'-0"



2 EXISTING FA DEVICES
 E2.2 NOT TO SCALE

- NUMBERED NOTES:**
- 1 CAREFULLY REMOVE (E) SMOKE DETECTOR AND RELOCATE AS SHOWN. PROVIDE J-BOX AT LOCATION OF REMOVED DEVICE TO SPLICE (E) FIRE ALARM WIRING.
 - 2 CAREFULLY REMOVE (E) STROBE/HORN AND RELOCATE AS SHOWN. PROVIDE J-BOX AT LOCATION OF REMOVED DEVICE TO SPLICE (E) FIRE ALARM WIRING. REINSTALL (E) STROBE/HORN BETWEEN 80"(TOP OF LENS) TO 96"(BOTTOM OF LENS).
 - 3 INTERCEPT (E) CONDUIT/CONDUCTORS AND INSTALL (N) SMOKE DETECTOR.
 - 4 REMOVE (E) SMOKE DETECTOR. PROVIDE J-BOX AT LOCATION OF REMOVED DEVICE TO SPLICE (E) FIRE ALARM WIRING.
 - 5 INTERCEPT (E) CONDUIT/CONDUCTORS AND INSTALL (N) HEAT DETECTOR.
 - 6 CAREFULLY REMOVE (E) SMOKE DETECTOR AND PROVIDE J-BOX AT LOCATION OF REMOVED DEVICE TO SPLICE (E) FIRE ALARM WIRING.
 - 7 INTERCEPT (E) CONDUIT/CONDUCTORS AND INSTALL (N) MONITOR MODULE. INSTALL (N) HEAT DETECTOR ADJACENT TO (N) MONITOR MODULE. CONNECT PER FIRE ALARM RISER DIAGRAM, SHEET E4.1.
 - 8 PROVIDE FOR FIRE SUPPRESSION SYSTEM. SEE 2/E4.1 FOR CONNECTION.
 - 9 AMBIENT CONDITION (FINE DUST, SMOKE) IN THIS SPACE DO NOT PERMIT USE OF SMOKE DETECTORS PER SMOKE DETECTOR MANUFACTURER RECOMENDATIONS.

©2023 Synthesis Partners, LLC. All Rights Reserved.
 These record drawings have been prepared based upon information submitted, in part, by others. While this information is believed to be reliable, the Architect is not responsible for their accuracy, nor for errors or omissions which may have been incorporated into these documents as a result.

APPROVALS
 PO Box 1900
 Yuba City, CA 95992-1900
 530.298.7298
 www.spinc-arch.com

ARCHITECTURAL • COMMERCIAL • RESIDENTIAL • INTERIOR • CONSTRUCTION MANAGEMENT




SYNTHESIS PARTNERS, LLC
 Managers • Architects

M. NEILS ENGINEERING, INC.
 Electrical Engineers | Lighting Designers
 100 Howe Ave., Suite 235N
 Sacramento, CA 95825-8217
 www.mneilsengineering.com
 Tel: (916) 923-4400 Fax: (916) 923-4410
 PROJECT #: 22133.21

OWNER
Woodland Joint Unified School District
 435 6th Street
 Woodland, CA 95695

PROJECT
CLASSROOM CONVERSIONS
 at
WOODLAND EDUCATION CENTER
 575 Hays Street
 Woodland, CA 95695

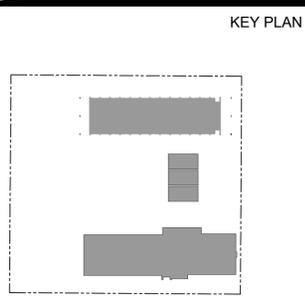


REGISTERED PROFESSIONAL ENGINEER
 JESSE U. BASTIAN
 No. E20229
 Exp. 03-31-23
Jesse Bastian
 ELECTRICAL
 STATE OF CALIFORNIA
 02/13/2023

NO.	REVISION DESCRIPTION	DATE

PARTIAL FLOOR PLAN - FIRE ALARM
E2.3
 DATE 2022-07-29
 PROJECT NO. 21-W04-01

UNAUTHORIZED CHANGES & USES: M. Neils Engineering, Inc. preparing these plans will not be responsible for unauthorized changes to or uses of these plans. All changes to these plans must be in writing and must be approved by M. Neils Engineering, Inc. in writing. These record drawings have been prepared based upon information submitted, in part, by others. While this information is believed to be reliable, the Architect is not responsible for its accuracy, nor for errors or omissions which may have been incorporated into these documents as a result.

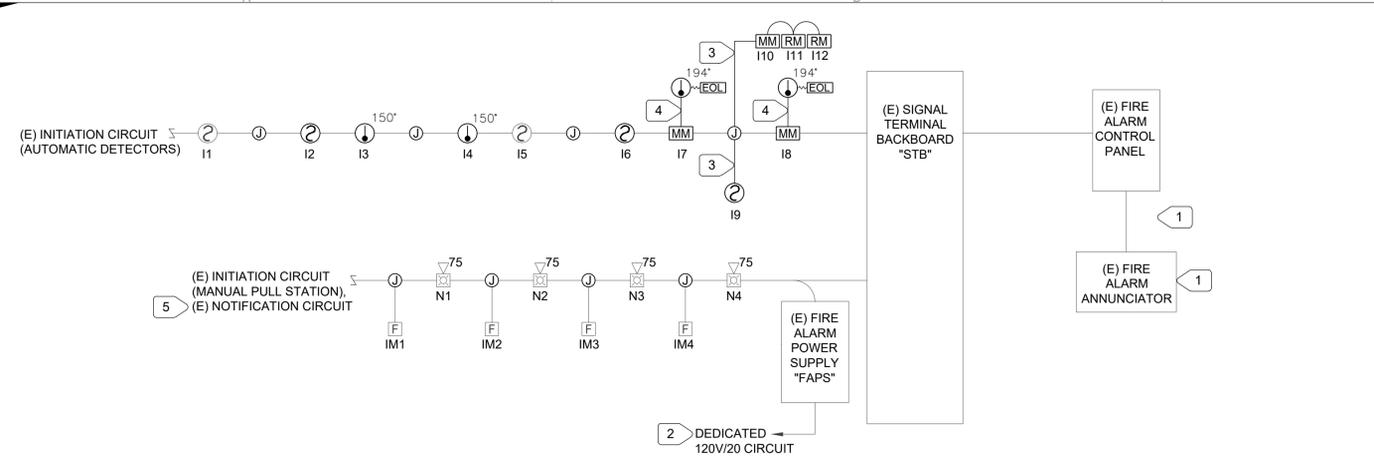

1 FIRE ALARM RISER DIAGRAM

E4.1 N.T.S.

FIRE ALARM NOTE:

ENTIRE FIRE ALARM SYSTEM SHALL BE INSPECTED AND TESTED IN ACCORDANCE WITH NFPA 72, CHAPTER 14 UPON COMPLETION OF FIRE ALARM SCOPE.

NUMBERED NOTES:

- PROGRAM HEAD END EQUIPMENT FOR (N) ADDED DEVICES. COORDINATE WITH OWNER.
- (E) CIRCUIT BREAKER FOR DEDICATED POWER CIRCUIT HAS RED HANDLE. PROVIDE LOCKING DEVICE TO (E) CIRCUIT BREAKER.
- RUN IN SURFACE MOUNTED CONDUIT, SIMILAR TO (E) FA CONDUITS (PAINT TO MATCH (E) CONDUITS). MATCH (E) INITIATION CIRCUIT WIRE.
- #2#16THHN IN 1/2".
- NO CHANGES IN NOTIFICATION CIRCUIT LOAD, OR WIRE LENGTH, THEREFORE NO BATTERY CALCULATION OR VOLTAGE DROP CALCULATION ARE REQUIRED.



Addressable Photoelectric Type Smoke Detector

Detect smoldering fires quickly and get help fast with IntelliKnight® photoelectric smoke detectors.

Model SD505-APS

Specifications:

- Operating Voltage: 120 VAC
- Current Consumption: 20 mA
- Alarm: 20 mA
- Alarm Temperature: 120°F (50°C)
- Response Time: 30 sec
- Relative Humidity: 10% - 90%
- Weight: 1.5 lbs
- Dimensions: 4.5" x 4.5" x 3.5"

SILENT KNIGHT SD505-AHS Addressable Heat Detector

IntelliKnight® addressable heat detectors combine accurate heat detection with pinpoint location ID. An essential combination for any installation.

Model SD505-AHS

Specifications:

- Operating Voltage: 120 VAC
- Current Consumption: 20 mA
- Alarm: 20 mA
- Alarm Temperature: 120°F (50°C)
- Response Time: 30 sec
- Relative Humidity: 10% - 90%
- Weight: 1.5 lbs
- Dimensions: 4.5" x 4.5" x 3.5"

System Sensor, 5600 Series

Mechanical Heat Detectors

The 5600 Series provides heat sensing with built-in alarm and trouble signaling. It is designed for use in areas where a fire is likely to start in a concealed space, such as in a ceiling or under a floor.

Specifications:

- Operating Voltage: 120 VAC
- Current Consumption: 20 mA
- Alarm: 20 mA
- Alarm Temperature: 120°F (50°C)
- Response Time: 30 sec
- Relative Humidity: 10% - 90%
- Weight: 1.5 lbs
- Dimensions: 4.5" x 4.5" x 3.5"

SILENT KNIGHT SD500-AIM & SD500-MIM Addressable Input Modules

IntelliKnight's addressable contact monitor modules combine fast response with pinpoint location ID. A combination that saves lives and property.

Model SD500-AIM & SD500-MIM

Specifications:

- Operating Voltage: 120 VAC
- Current Consumption: 20 mA
- Alarm: 20 mA
- Alarm Temperature: 120°F (50°C)
- Response Time: 30 sec
- Relative Humidity: 10% - 90%
- Weight: 1.5 lbs
- Dimensions: 4.5" x 4.5" x 3.5"

Honeywell IntelliKnight SD500-ARM Addressable Relay Module

The SD500-ARM is an addressable relay module that can be used to control a wide variety of normally open and normally closed appliances, including elevators, escalators, and other equipment.

Model SD500-ARM

Specifications:

- Operating Voltage: 120 VAC
- Current Consumption: 20 mA
- Alarm: 20 mA
- Alarm Temperature: 120°F (50°C)
- Response Time: 30 sec
- Relative Humidity: 10% - 90%
- Weight: 1.5 lbs
- Dimensions: 4.5" x 4.5" x 3.5"

CALIFORNIA DEPARTMENT OF FORESTRY & FIRE PROTECTION

LISTING SERVICE

LISTING No. 7275-0889-0109

CATEGORY: 7275 - SMOKE DETECTOR SYSTEM TYPE PHOTOELECTRIC

LISTING No. 7275-0889-0107

CATEGORY: 7275 - HEAT DETECTOR

CALIFORNIA DEPARTMENT OF FORESTRY & FIRE PROTECTION

LISTING SERVICE

LISTING No. 7275-0889-0107

CATEGORY: 7275 - HEAT DETECTOR

LISTING No. 7275-0889-0107

CATEGORY: 7275 - HEAT DETECTOR

CALIFORNIA DEPARTMENT OF FORESTRY & FIRE PROTECTION

LISTING SERVICE

LISTING No. 7275-0889-0107

CATEGORY: 7275 - HEAT DETECTOR

LISTING No. 7275-0889-0107

CATEGORY: 7275 - HEAT DETECTOR

CALIFORNIA DEPARTMENT OF FORESTRY & FIRE PROTECTION

LISTING SERVICE

LISTING No. 7300-0889-0102

CATEGORY: 7300 - FIRE ALARM CONTROL UNIT ACCESSORIES/MISC. DEVICES

LISTING No. 7300-0889-0102

CATEGORY: 7300 - FIRE ALARM CONTROL UNIT ACCESSORIES/MISC. DEVICES

CALIFORNIA DEPARTMENT OF FORESTRY & FIRE PROTECTION


LISTING SERVICE

LISTING No. 7300-0889-0102

CATEGORY: 7300 - FIRE ALARM CONTROL UNIT ACCESSORIES/MISC. DEVICES

LISTING No. 7300-0889-0102

CATEGORY: 7300 - FIRE ALARM CONTROL UNIT ACCESSORIES/MISC. DEVICES

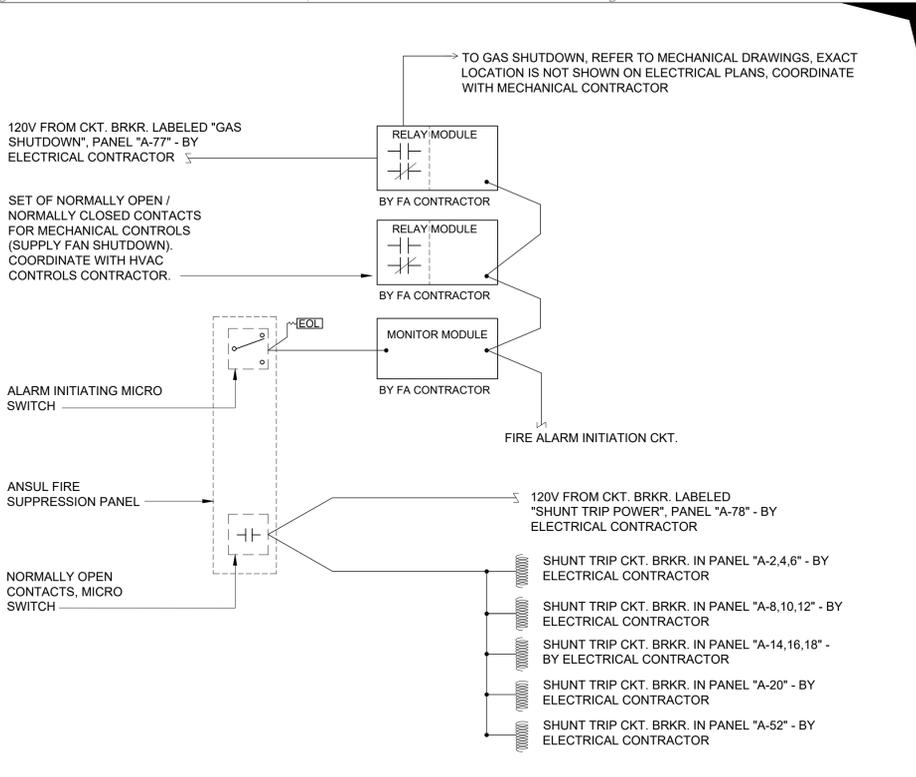

2 HOOD FIRE SUPPRESSION PANEL - WIRING DIAGRAM

E4.1 NOT TO SCALE

APPROVALS

PO Box 1900
Yuba City, CA 95992-1900
530.298.7298
www.spinc-arch.com

SYNTHESIS PARTNERS, LLC
Managers • Architects

M. NEILS ENGINEERING, INC.
Electrical Engineers | Lighting Designers
100 Howe Ave., Suite 235N
Sacramento, CA 95825-8217
www.mneilsengineering.com
Tel: (916) 923-4400 Fax: (916) 923-4410
PROJECT #: 22133.21

OWNER

Woodland Joint Unified School District
435 6th Street
Woodland, CA 95695

PROJECT

CLASSROOM CONVERSIONS
at
WOODLAND EDUCATION CENTER
575 Hays Street
Woodland, CA 95695

KEY PLAN

REGISTRATION

PROFESSIONAL ENGINEER
JESSE U. BASTIAN
No. E20229
Exp. 03-31-23
Jesse U. Bastian
ELECTRICAL
STATE OF CALIFORNIA

02/13/2023


NO. REVISION DESCRIPTION DATE

FIRE ALARM DIAGRAMS, FA EQUIPMENT


E4.1

DATE: 2022-07-29
PROJECT NO.: 21-W04-01


Feb 12, 2023 - 11:29am / sgljic
 UNAUTHORIZED CHANGES & USES: M. Neils Engineering, Inc. Preparing these plans will not be responsible for, or liable for unauthorized changes to or uses to these plans. All changes to these plans must be in writing and must be approved by M. Neils Engineering, Inc.

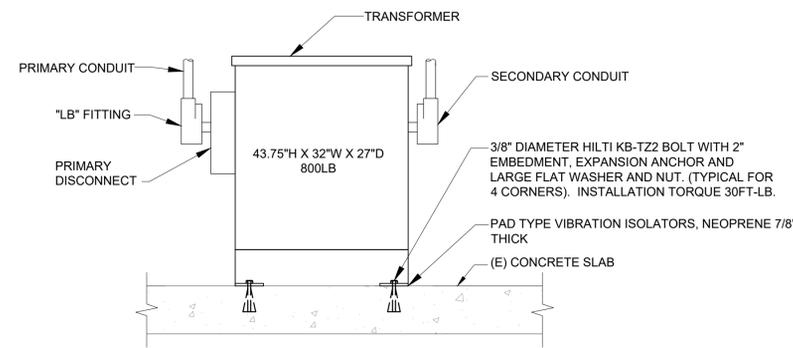


1 TRANSFORMER MOUNTING DETAIL
E5.1 NO SCALE

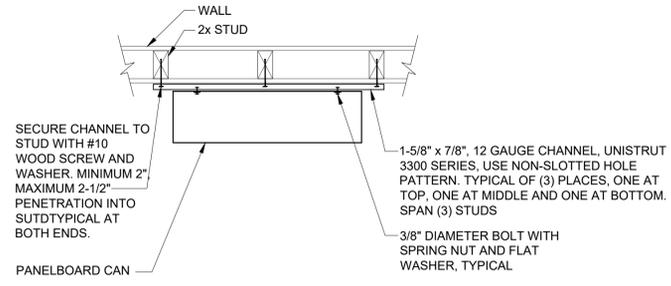


DIMENSION: 81"H X20"W X4.75"D
 WEIGHT: 208LB.
2 PANEL- MOUNTING DETAIL
 E5.1 NO SCALE

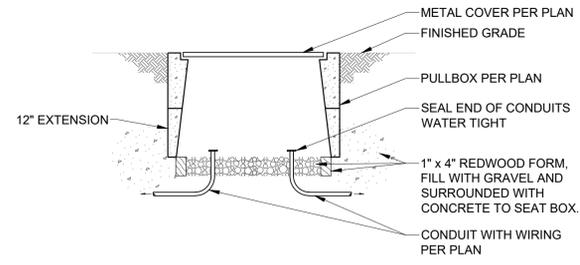


3 UNDERGROUND PULL BOX
E5.1 NO SCALE

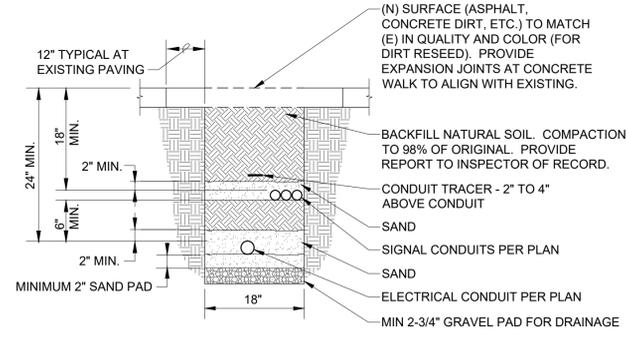


4 CONDUIT TRENCHING DETAIL
0.1 NO SCALE

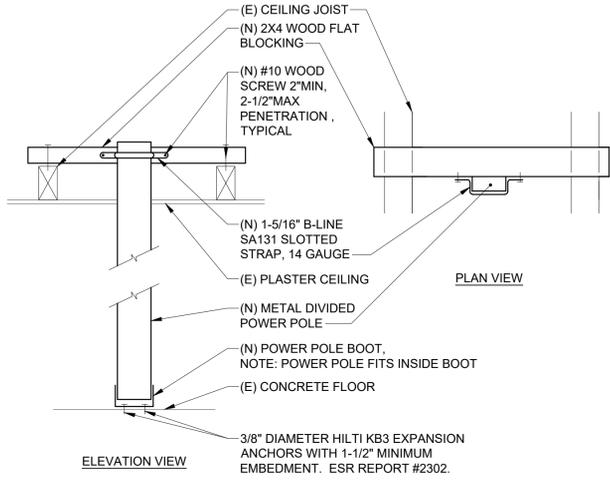

5 POWER POLE DETAIL
E5.1 NO SCALE

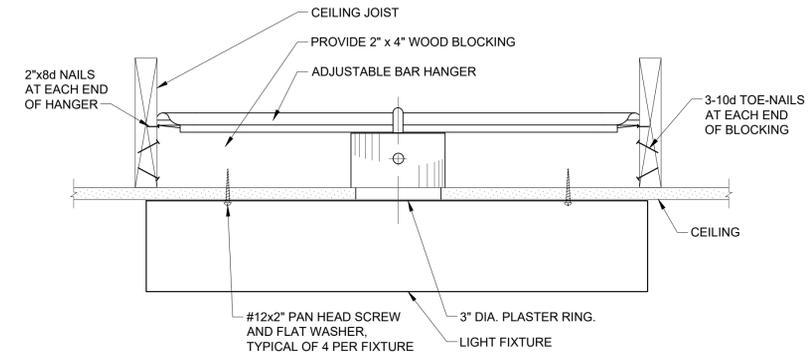

DIMENSION: 48"H X12.1"W X4"D
 WEIGHT: 14.7LB.
6 SURFACE FIXTURE MOUNTING DETAIL
 E5.1 NO SCALE

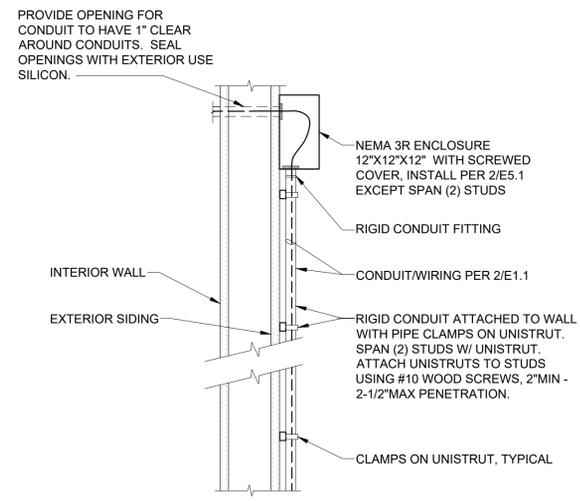

7 EXTERIOR CONDUIT PENETRATION DETAIL
E5.1 NO SCALE

©2023 Synthesis Partners, LLC. All Rights Reserved.
 These record drawings have been prepared based upon information submitted, in part, by others. While this information is believed to be reliable, the Architect is not responsible for their accuracy, nor for errors or omissions which may have been incorporated into these documents as a result.

PO Box 1900
 Yuba City, CA 95992-1900
 530.298.7298
 www.spinc-arch.com

ARCHITECTURAL • COMMERCIAL • RESIDENTIAL • INTERIOR • CONSTRUCTION MANAGEMENT




SYNTHESIS PARTNERS, LLC
 Managers • Architects

M. NEILS
ENGINEERING, INC.
 Electrical Engineers | Lighting Designers
 100 Howe Ave., Suite 235N
 Sacramento, CA 95825-8217
 www.mneilsengineering.com
 Tel: (916) 923-4400 Fax: (916) 923-4410
 PROJECT #: 22133.21

OWNER
 Woodland Joint Unified School District
 435 6th Street
 Woodland, CA 95695

PROJECT
 CLASSROOM CONVERSIONS
 at
 WOODLAND EDUCATION
 CENTER
 575 Hays Street
 Woodland, CA 95695

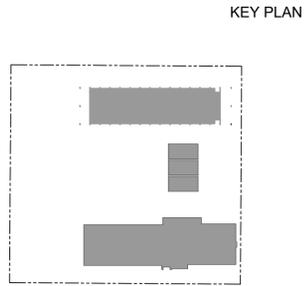

REGISTERED PROFESSIONAL ENGINEER
 JESSE U. BASTIAN
 No. E20229
 Exp. 03-31-23
 ELECTRICAL
 STATE OF CALIFORNIA
 02/13/2023

NO.	REVISION DESCRIPTION	DATE

ELECTRICAL DETAILS

E5.1

DATE 2022-07-29
 PROJECT NO. 21-W04-01

Feb 12, 2023 - 11:29am / sgljic
UNAUTHORIZED CHANGES & USES: M. Neils Engineering, Inc. preparing these plans will not be responsible for, or liable for unauthorized changes to or uses to these plans. All changes to these plans must be in writing and must be approved by M. Neils Engineering, Inc.

STATE OF CALIFORNIA
Indoor Lighting
NRCCLTI-E (Created 01/20)

CERTIFICATE OF COMPLIANCE
This document is used to demonstrate compliance with requirements in §110.9, §110.12(c), §130.0, §130.1, §140.6, and §141.0(b)2 for indoor lighting scopes using the prescriptive path.

Project Name: CLASSROOM CONVERSIONS AT WOODLAND EDUCATION CENTER Report Page: Page 1 of 6
Project Address: 575 HAYS ST, WOODLAND, CA 95695 Date Prepared: 11/17/2022

A. GENERAL INFORMATION

01 Project Location (city)	WOODLAND	04 Total Conditioned Floor Area (ft ²)	868
02 Climate Zone	12	05 Total Unconditioned Floor Area (ft ²)	
03 Occupancy Types Within Project (select all that apply):		06 # of Stories (Habitable Above Grade)	
<input type="checkbox"/> Office <input type="checkbox"/> Retail <input type="checkbox"/> Warehouse <input type="checkbox"/> School <input type="checkbox"/> Support Areas			
<input type="checkbox"/> Parking Garage <input type="checkbox"/> High-Rise Residential <input type="checkbox"/> Relocatable <input type="checkbox"/> Healthcare <input type="checkbox"/> Other (write in):			

B. PROJECT SCOPE

Table Instructions: include any lighting systems that are within the scope of the permit application and are demonstrating compliance using the prescriptive path outlined in §140.6 or §141.0(b)2 for alterations. WARNING: Changing the Calculation Method in this table will result in the deletion of data previously input. If you need to change the calculation method, please open a new form or use "Save As".

Scope of Work		Conditioned Spaces		Unconditioned Spaces	
01	02	03	04	05	06
My Project Consists of (check all that apply):	Calculation Method	Area (ft ²)	Calculation Method	Area (ft ²)	
<input checked="" type="checkbox"/> New Lighting System	Area Category	868			
<input type="checkbox"/> Altered Lighting System					
Total Area of Work (ft ²)		868			

C. COMPLIANCE RESULTS

Table Instructions: If any cell on this table says "DOES NOT COMPLY" or "COMPLIES with Exceptional Conditions" refer to Table D for guidance.

Allowed Lighting Power per §140.6(b) (Watts)		Adjusted Lighting Power per §140.6(a) (Watts)		Compliance Results	
01	02	03	04	05	06
Complete Building §140.6(c)1	Area Category §140.6(c)2	Additional §140.6(c)2G (+)	Tailored §140.6(c)3 (+)	Total Allowed (Watts)	Total Adjusted (Watts)
(See Table I)	(See Table J)	(See Table K)	(See Table L)	824.6	640
Conditioned:		824.6		824.6	640
Unconditioned:					
Table Continued					

CA Building Energy Efficiency Standards - 2019 Nonresidential Compliance: <http://www.energy.ca.gov/title24/2019standards> January 2020

STATE OF CALIFORNIA
Indoor Lighting
NRCCLTI-E (Created 01/20)

CERTIFICATE OF COMPLIANCE
This document is used to demonstrate compliance with requirements in §110.9, §110.12(c), §130.0, §130.1, §140.6, and §141.0(b)2 for indoor lighting scopes using the prescriptive path.

Project Name: CLASSROOM CONVERSIONS AT WOODLAND EDUCATION CENTER Report Page: Page 4 of 6
Project Address: 575 HAYS ST, WOODLAND, CA 95695 Date Prepared: 11/17/2022

K. TAILORED METHOD GENERAL LIGHTING POWER ALLOWANCE
This Section Does Not Apply

L. ADDITIONAL LIGHTING ALLOWANCE: TAILORED WALL DISPLAY
This Section Does Not Apply

M. ADDITIONAL LIGHTING ALLOWANCE: TAILORED FLOOR AND TASK LIGHTING
This Section Does Not Apply

N. ADDITIONAL LIGHTING ALLOWANCE: TAILORED ORNAMENTAL/SPECIAL EFFECTS
This Section Does Not Apply

O. ADDITIONAL LIGHTING ALLOWANCE: TAILORED VERY VALUABLE MERCHANDISE
This Section Does Not Apply

P. POWER ADJUSTMENT: LIGHTING CONTROL CREDIT (POWER ADJUSTMENT FACTOR (PAF))
This Section Does Not Apply

Q. RATED POWER REDUCTION COMPLIANCE FOR ALTERATIONS
This Section Does Not Apply

R. 80% LIGHTING POWER FOR ALTERATIONS - CONTROLS EXCEPTIONS
This Section Does Not Apply

S. DAYLIGHT DESIGN POWER ADJUSTMENT FACTOR (PAF)
This Section Does Not Apply

T. DECLARATION OF REQUIRED CERTIFICATES OF INSTALLATION

Table Instructions: Selections have been made based on information provided in previous tables of this document. If any selection needs to be changed, please explain why in Table E. Additional Remarks. These documents must be provided to the building inspector during construction and can be found online at https://www2.energy.ca.gov/title24/2019standards/2019_compliance_documents/Nonresidential_Documents/NRC/

CA Building Energy Efficiency Standards - 2019 Nonresidential Compliance: <http://www.energy.ca.gov/title24/2019standards> January 2020

STATE OF CALIFORNIA
Indoor Lighting
NRCCLTI-E (Created 01/20)

CERTIFICATE OF COMPLIANCE
This table is auto-filled with uneditable comments because of selections made or data entered in tables throughout the form.

Project Name: CLASSROOM CONVERSIONS AT WOODLAND EDUCATION CENTER Report Page: Page 2 of 6
Project Address: 575 HAYS ST, WOODLAND, CA 95695 Date Prepared: 11/17/2022

Controls Compliance (See Table H for Details) **COMPLIES**
Rated Power Reduction Compliance (See Table Q for Details) **Not Applicable**

D. EXCEPTIONAL CONDITIONS

This table is auto-filled with uneditable comments because of selections made or data entered in tables throughout the form.

No exceptional conditions apply to this project.

E. ADDITIONAL REMARKS

This table includes remarks made by the permit applicant to the Authority Having Jurisdiction.

F. INDOOR LIGHTING FIXTURE SCHEDULE

Table Instructions: Include all permanent designed lighting and all portable lighting in offices.

Designed Wattage: Conditioned Spaces

01	02	03	04	05	06	07	08	09	10
Name or Item Tag	Complete Luminaire Description	Modular (Track) Fixture	Small Aperture & Color Change	Watts per luminaire*	How Wattage is determined	Total number luminaires	Exempt per §140.6(a)3	Design Watts	Field Inspector
A	4FT SURFACE MOUNT LED			40	Mfr. Spec*	16		640	Pass
Total Designed Watts CONDITIONED SPACES:									640

* FOOTNOTE: Design Watts for small aperture and color changing luminaires which qualify per §140.6(a)4B is adjusted to be 75% of their rated wattage. Table F automatically makes this adjustment, the permit applicant should enter full rated wattage in column 05.
* Authority Having Jurisdiction may ask for Luminaire cut sheets to confirm wattage used for compliance per §130.0(c) Wattage used must be the maximum rated for the luminaire, not the lamp.

G. MODULAR LIGHTING SYSTEMS
This Section Does Not Apply

H. INDOOR LIGHTING CONTROLS (Not Including PAFs)

Table Instructions: Please include lighting controls for conditioned and unconditioned spaces in this table. When an option having a * is selected, the notes section of this table must be completed. The lighting controls section of the Compliance Summary Table on the first page will show "DOES NOT COMPLY" if the notes are left blank.

CA Building Energy Efficiency Standards - 2019 Nonresidential Compliance: <http://www.energy.ca.gov/title24/2019standards> January 2020

STATE OF CALIFORNIA
Indoor Lighting
NRCCLTI-E (Created 01/20)

CERTIFICATE OF COMPLIANCE
This table is auto-filled with uneditable comments because of selections made or data entered in tables throughout the form.

Project Name: CLASSROOM CONVERSIONS AT WOODLAND EDUCATION CENTER Report Page: Page 5 of 6
Project Address: 575 HAYS ST, WOODLAND, CA 95695 Date Prepared: 11/17/2022

YES	NO	Form/Title	Field Inspector
			Pass Fail
<input checked="" type="radio"/>	<input type="radio"/>	NRCI-LTI-01-E - Must be submitted for all buildings	<input type="checkbox"/> <input type="checkbox"/>
<input type="radio"/>	<input checked="" type="radio"/>	NRCI-LTI-02-E - Must be submitted for a lighting control system, or for an Energy Management Control System (EMCS), to be recognized for compliance.	<input type="checkbox"/> <input type="checkbox"/>
<input type="radio"/>	<input checked="" type="radio"/>	NRCI-LTI-04-E - Must be submitted for two interlocked systems serving an auditorium, a convention center, a conference room, a multipurpose room, or a theater to be recognized for compliance.	<input type="checkbox"/> <input type="checkbox"/>
<input type="radio"/>	<input checked="" type="radio"/>	NRCI-LTI-05-E - Must be submitted for a Power Adjustment Factor (PAF) to be recognized for compliance.	<input type="checkbox"/> <input type="checkbox"/>
<input type="radio"/>	<input checked="" type="radio"/>	NRCI-LTI-06-E - Must be submitted for additional wattage installed in a video conferencing studio to be recognized for compliance.	<input type="checkbox"/> <input type="checkbox"/>

I. DECLARATION OF REQUIRED CERTIFICATES OF ACCEPTANCE

Table Instructions: Selections have been made based on information provided in previous tables of this document. If any selection needs to be changed, please explain why in Table E. Additional Remarks. These documents must be provided to the building inspector during construction and any with "A" in the form name must be completed through an Acceptance Test Technician Certification Provider (ATTCP). For more information visit: <http://www.energy.ca.gov/title24/attcp/providers.html>

YES	NO	Form/Title	Field Inspector
			Pass Fail
<input checked="" type="radio"/>	<input type="radio"/>	NRCA-LTI-02-A - Must be submitted for occupancy sensors and automatic time switch controls.	<input type="checkbox"/> <input type="checkbox"/>
<input type="radio"/>	<input checked="" type="radio"/>	NRCA-LTI-03-A - Must be submitted for automatic daylight controls.	<input type="checkbox"/> <input type="checkbox"/>
<input type="radio"/>	<input checked="" type="radio"/>	NRCA-LTI-04-A - Must be submitted for demand responsive lighting controls.	<input type="checkbox"/> <input type="checkbox"/>
<input type="radio"/>	<input checked="" type="radio"/>	NRCA-LTI-05-A - Must be submitted for institutional tuning power adjustment factor (PAF).	<input type="checkbox"/> <input type="checkbox"/>
<input type="radio"/>	<input checked="" type="radio"/>	NRCA-ENV-03-F - Must be submitted for daylighting design power adjustment factors (PAF).	<input type="checkbox"/> <input type="checkbox"/>

CA Building Energy Efficiency Standards - 2019 Nonresidential Compliance: <http://www.energy.ca.gov/title24/2019standards> January 2020

STATE OF CALIFORNIA
Indoor Lighting
NRCCLTI-E (Created 01/20)

CERTIFICATE OF COMPLIANCE
This table is auto-filled with uneditable comments because of selections made or data entered in tables throughout the form.

Project Name: CLASSROOM CONVERSIONS AT WOODLAND EDUCATION CENTER Report Page: Page 3 of 6
Project Address: 575 HAYS ST, WOODLAND, CA 95695 Date Prepared: 11/17/2022

Building Level Controls

01	02	03
Mandatory Demand Response §110.12(c)	Shut-Off Controls §130.1(c)	Field Inspector
Not Required ≤ 10,000 SF	See Area/Space Level Controls	Pass Fail

Area Level Controls

04	05	06	07	08	09	10	11	12
Area Description	Complete Building or Area Category Primary Function Area	Area Controls §130.1(a)	Multi-Level Controls §130.1(b)	Shut-Off Controls §130.1(c)	Primary/Skylight Daylighting §130.1(d)	Secondary Daylighting §140.6(d)	Interlocked Systems §140.6(a)1	Field Inspector
CULINARY CLASSROOM	Kitchen, Food Preparation	Manual ON/OFF	Dimmer	Occ. Sensor	NA	NA		Pass Fail
Plan Sheet Showing Daylit Zones:								

* NOTES: Controls with a * require a note in the space below explaining how compliance is achieved.
EX: Conference 1: Primary/Skylight Daylighting: Exempt because less than 120 watts of general lighting;
EXCEPTION 1 to §130.1(d)2

I. LIGHTING POWER ALLOWANCE: COMPLETE BUILDING OR AREA CATEGORY METHODS

Table Instructions: Complete the table for each area complying using the Complete Building or Area Category Methods per §140.6(b). Indicate if additional lighting power allowances per §140.6(c) or adjustments per §140.6(a) are being used.

Conditioned Spaces:

01	02	03	04	05	06
Area Description	Complete Building or Area Category Primary Function Area	Allowed Density (W/ft ²)	Area (ft ²)	Allowed Wattage (Watts)	Additional Allowances / Adjustment
CULINARY CLASSROOM	Kitchen, Food Preparation	0.95	868	824.6	Area Category PAF
TOTAL:			868	824.6	See Tables J or P for detail

J. ADDITIONAL LIGHTING ALLOWANCE: AREA CATEGORY METHOD QUALIFYING LIGHTING SYSTEM
This Section Does Not Apply

CA Building Energy Efficiency Standards - 2019 Nonresidential Compliance: <http://www.energy.ca.gov/title24/2019standards> January 2020

STATE OF CALIFORNIA
Indoor Lighting
NRCCLTI-E (Created 01/20)

CERTIFICATE OF COMPLIANCE
This table is auto-filled with uneditable comments because of selections made or data entered in tables throughout the form.

Project Name: CLASSROOM CONVERSIONS AT WOODLAND EDUCATION CENTER Report Page: Page 6 of 6
Project Address: 575 HAYS ST, WOODLAND, CA 95695 Date Prepared: 11/17/2022

DOCUMENTATION AUTHOR'S DECLARATION STATEMENT

I certify that this Certificate of Compliance documentation is accurate and complete.

Documentation Author Name: Jesse U. Bastian
Company: M. Neils Engineering, Inc.
Address: 100 Howe Ave, Suite 235N
City/State/Zip: Sacramento, CA 95825

Documentation Author Signature: *Jesse Bastian*
Signature Date: 02/13/2023
CEA/HERS Certification Identification (if applicable):
Phone: (916) 923-4400

RESPONSIBLE PERSON'S DECLARATION STATEMENT

I certify the following under penalty of perjury, under the laws of the State of California:

- The information provided on this Certificate of Compliance is true and correct.
- I am eligible under Division 3 of the Business and Professions Code to accept responsibility for the building design or system design identified on this Certificate of Compliance (responsible designer).
- The energy features and performance specifications, materials, components, and manufactured devices for the building design or system design identified on this Certificate of Compliance conform to the requirements of Title 24, Part 1 and Part 6 of the California Code of Regulations.
- The building design features or system design features identified on this Certificate of Compliance are consistent with the information provided on other applicable compliance documents, worksheets, calculations, plans and specifications submitted to the enforcement agency for approval with this building permit application.
- I will ensure that a completed signed copy of this Certificate of Compliance shall be made available with the building permit(s) issued for the building, and made available to the enforcement agency for all applicable inspections. I understand that a completed signed copy of this Certificate of Compliance is required to be included with the documentation the builder provides to the building owner at occupancy.

Responsible Designer Name: Jesse U. Bastian
Company: M. Neils Engineering, Inc.
Address: 100 Howe Ave, Suite 235N
City/State/Zip: Sacramento, CA 95825

Responsible Designer Signature: *Jesse Bastian*
Date Signed: 02/13/2023
License: E20229
Phone: (916) 923-4400

CA Building Energy Efficiency Standards - 2019 Nonresidential Compliance: <http://www.energy.ca.gov/title24/2019standards> January 2020

©2023 Synthesis Partners, LLC. All Rights Reserved.
These record drawings have been prepared based upon information submitted, in part, by others. While this information is believed to be reliable, the Architect is not responsible for their accuracy, nor for errors or omissions which may have been incorporated into these documents as a result.

PO Box 1900
Yuba City, CA 95992-1900
530.298.7298
www.spinc-arch.com




SYNTHESIS PARTNERS, LLC
Managers · Architects

M. NEILS ENGINEERING, INC.
Electrical Engineers | Lighting Designers
100 Howe Ave., Suite 235N
Sacramento, CA 95825-8217
www.mneilsengineering.com
Tel: (916) 923-4400 Fax: (916) 923-4410
PROJECT #: 22133.21

OWNER
Woodland Joint Unified School District
435 6th Street
Woodland, CA 95695

PROJECT
CLASSROOM CONVERSIONS
at
WOODLAND EDUCATION CENTER
575 Hays Street
Woodland, CA 95695

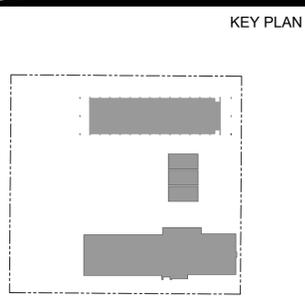

NO.	REVISION DESCRIPTION	DATE

T24 COMPLIANCE FORMS

DATE: 2022-07-29
PROJECT NO.: 21-W04-01

E6.1

APPROVALS